DATETIME$$$	TIME$$$	PRF	DGN	COUNTY	PROJECT NUMBER	SHEET NO.	TOTAL SHEETS
$USER$		$$PENTABLE$$		FORSYTH	CSSTP-0007-00(357)	14	55

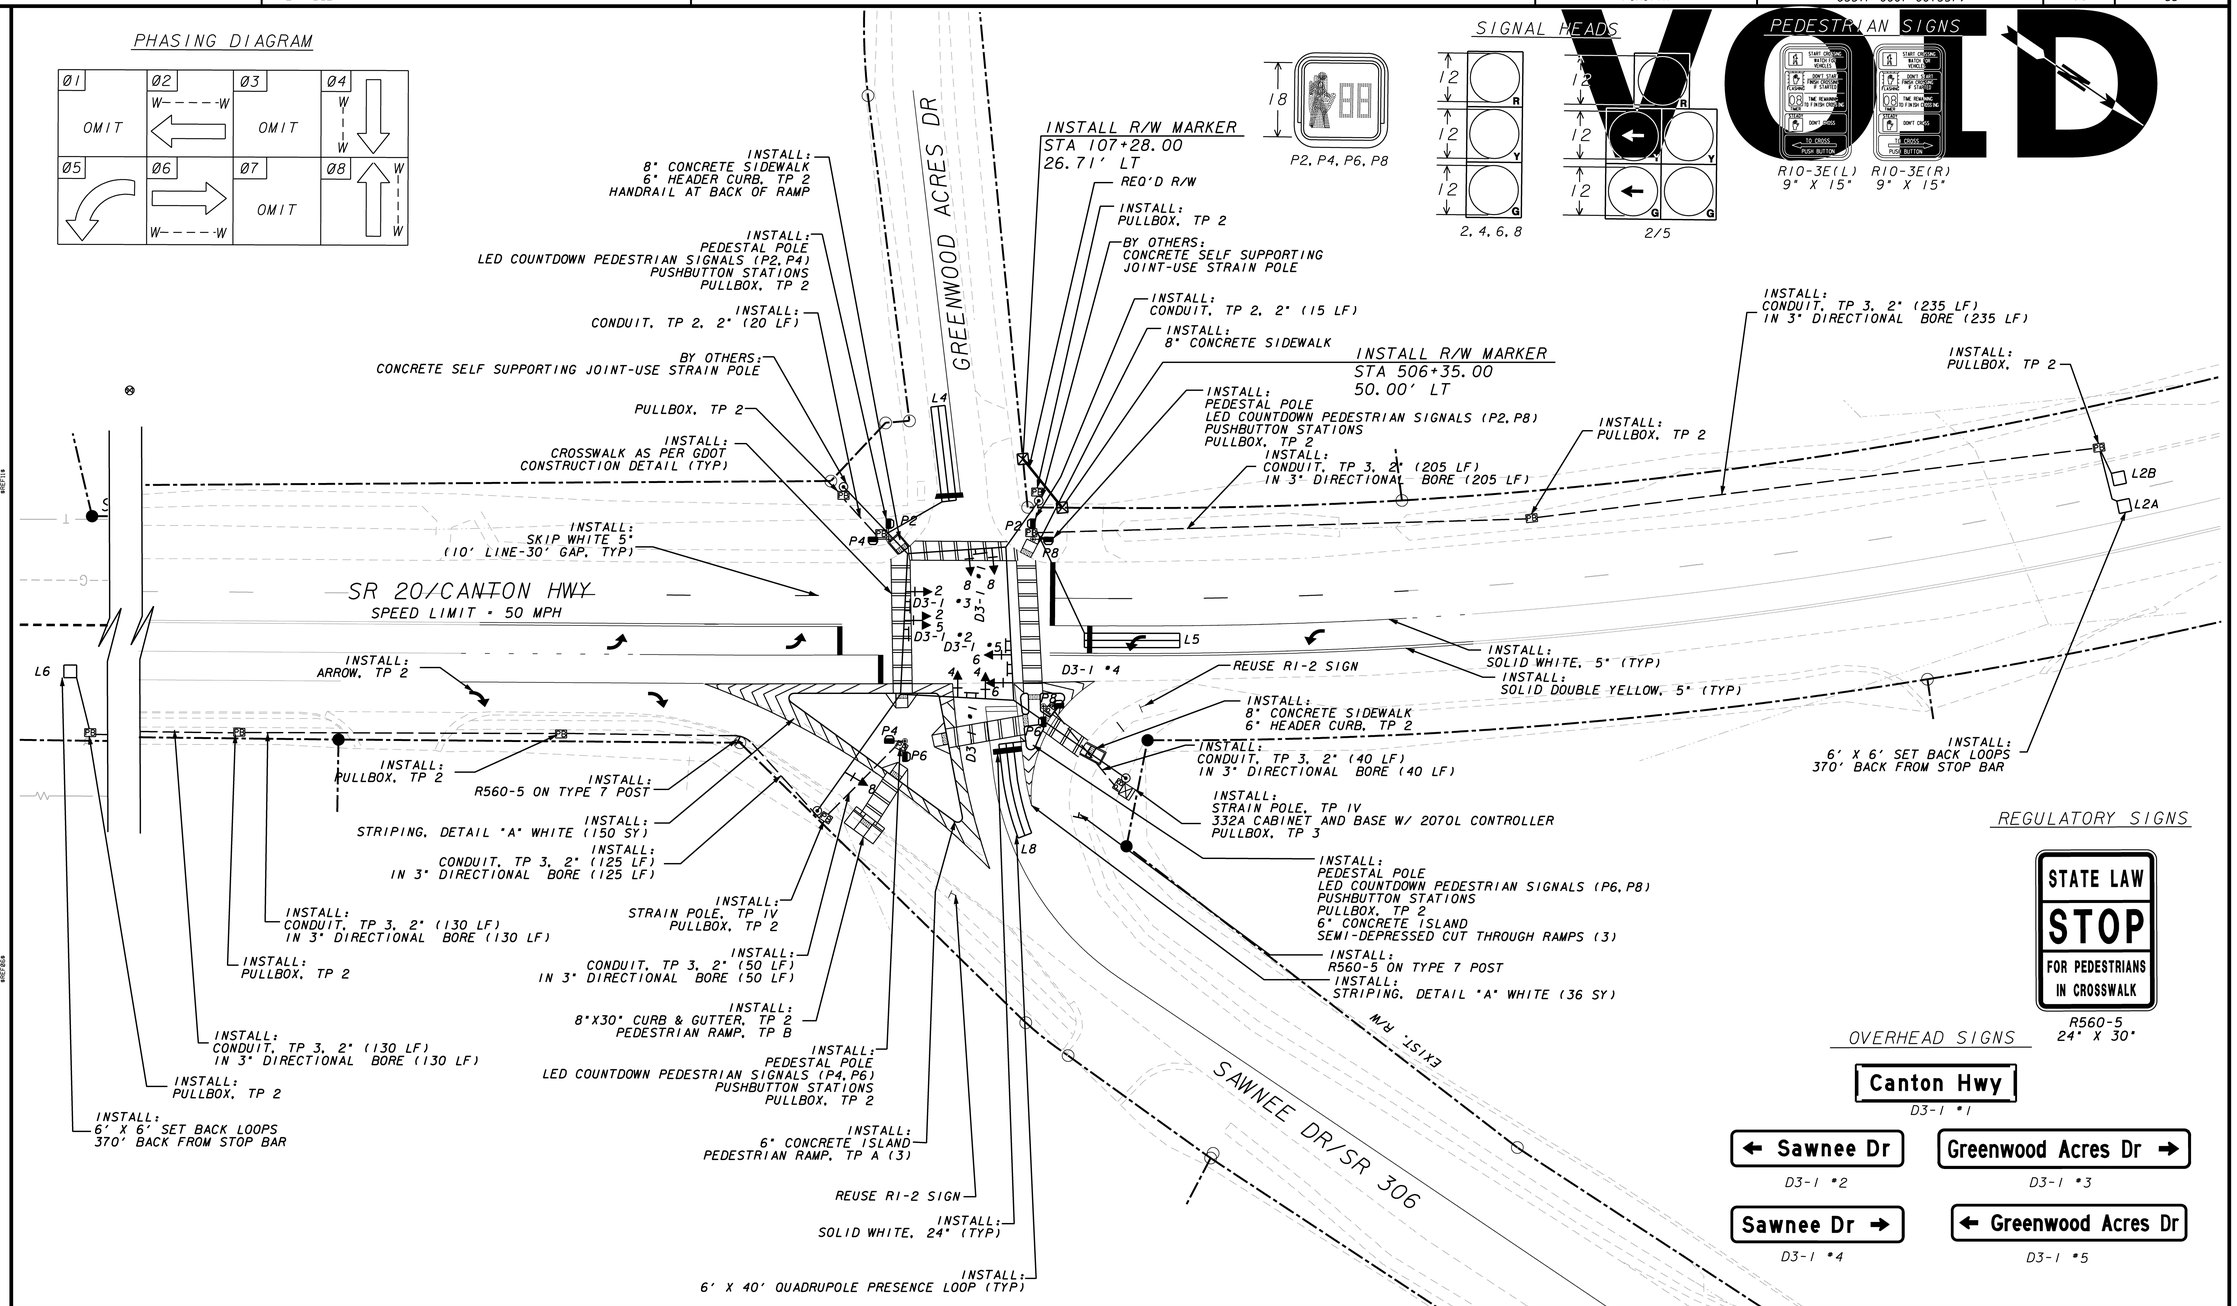

Wolverton & Associates
6745 Sugarloaf Parkway . Suite 100 . Duluth, Georgia 30097
Phone: (770) 447-8999 . Fax: (770) 447-9070
www.wolverton-assoc.com

GRESHAM SMITH AND PARTNERS

GEORGIA DEPARTMENT OF TRANSPORTATION

SCALE IN FEET
0 30 60 120

REVISION DATES

STATE OF GEORGIA
DEPARTMENT OF TRANSPORTATION
OFFICE: PROGRAM DELIVERY

CONSTRUCTION/INSTALLATION PLANS
INTERSECTION NO. 1

SR 20/CANTON HWY @ SR 306/SAWNEE DR

DRAWING No. 27- 003