PEDESTRIAN SIGNS

R10-3E(L) 9" X 15" R10-3E(R) 9" X 15"

LED PIXELATED SIGNAL

4/7 2,4,6,8 P2,P4 P6,P8

PHASING DIAGRAM

R560-5 18" X 24" R10-12 24" X 30"

VOID

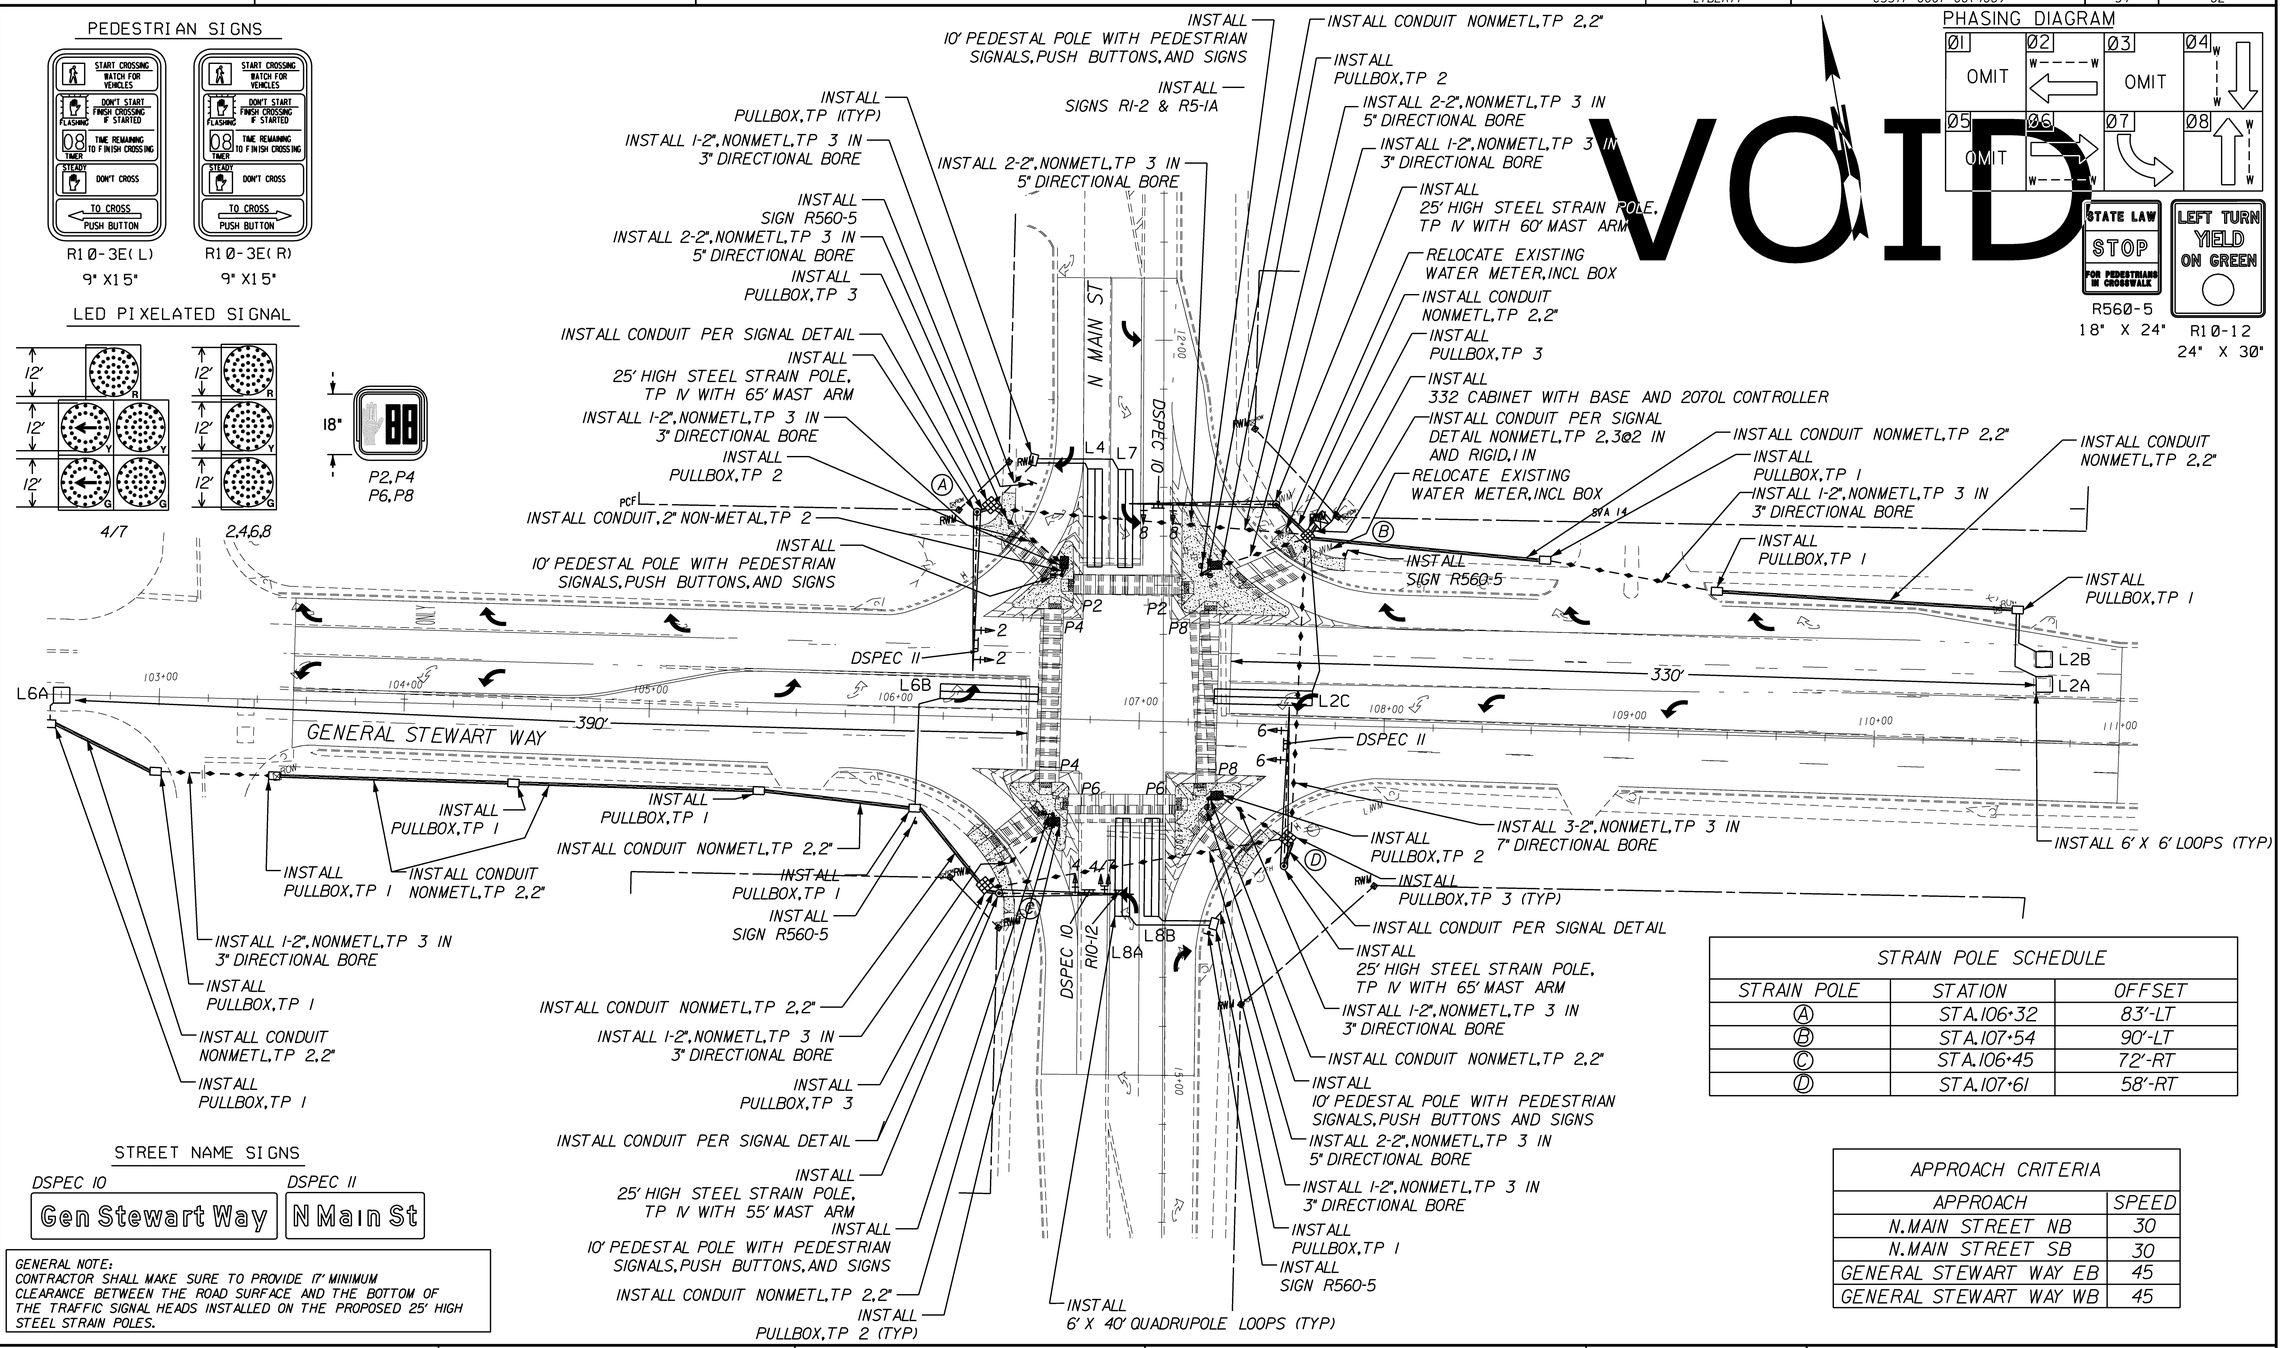

STREET NAME SIGNS

DSPEC 10: Gen Stewart Way

DSPEC 11: N Main St

GENERAL NOTE:
CONTRACTOR SHALL MAKE SURE TO PROVIDE 17' MINIMUM CLEARANCE BETWEEN THE ROAD SURFACE AND THE BOTTOM OF THE TRAFFIC SIGNAL HEADS INSTALLED ON THE PROPOSED 25' HIGH STEEL STRAIN POLES.

STRAIN POLE SCHEDULE

STRAIN POLE	STATION	OFFSET
A	STA.106+32	83'-LT
B	STA.107+54	90'-LT
C	STA.106+45	72'-RT
D	STA.107+61	58'-RT

APPROACH CRITERIA

APPROACH	SPEED
N.MAIN STREET NB	30
N.MAIN STREET SB	30
GENERAL STEWART WAY EB	45
GENERAL STEWART WAY WB	45

ARCADIS

SCALE IN FEET: 0 30 60 120

GEORGIA DEPARTMENT OF TRANSPORTATION

TRAFFIC SIGNAL # 6
GENERAL STEWART WAY @
N. MAIN STREET

DESIGNED BY: SM | CHECKED BY: AK | DATE: | REVIEWED BY: DT | DATE:

REVISION DATES

STATE OF GEORGIA
DEPARTMENT OF TRANSPORTATION
OFFICE: TRAFFIC OPERATIONS

SIGNAL PLANS

CONSTRUCTION AND INSTALLATION

DRAWING No. 27-018