| STATE | PROJECT NUMBER | SHEET NO. | TOTAL SHEETS |
|---|---|---|---|
| GA | CSSTP-0007-00(457) | 53 | 130 |

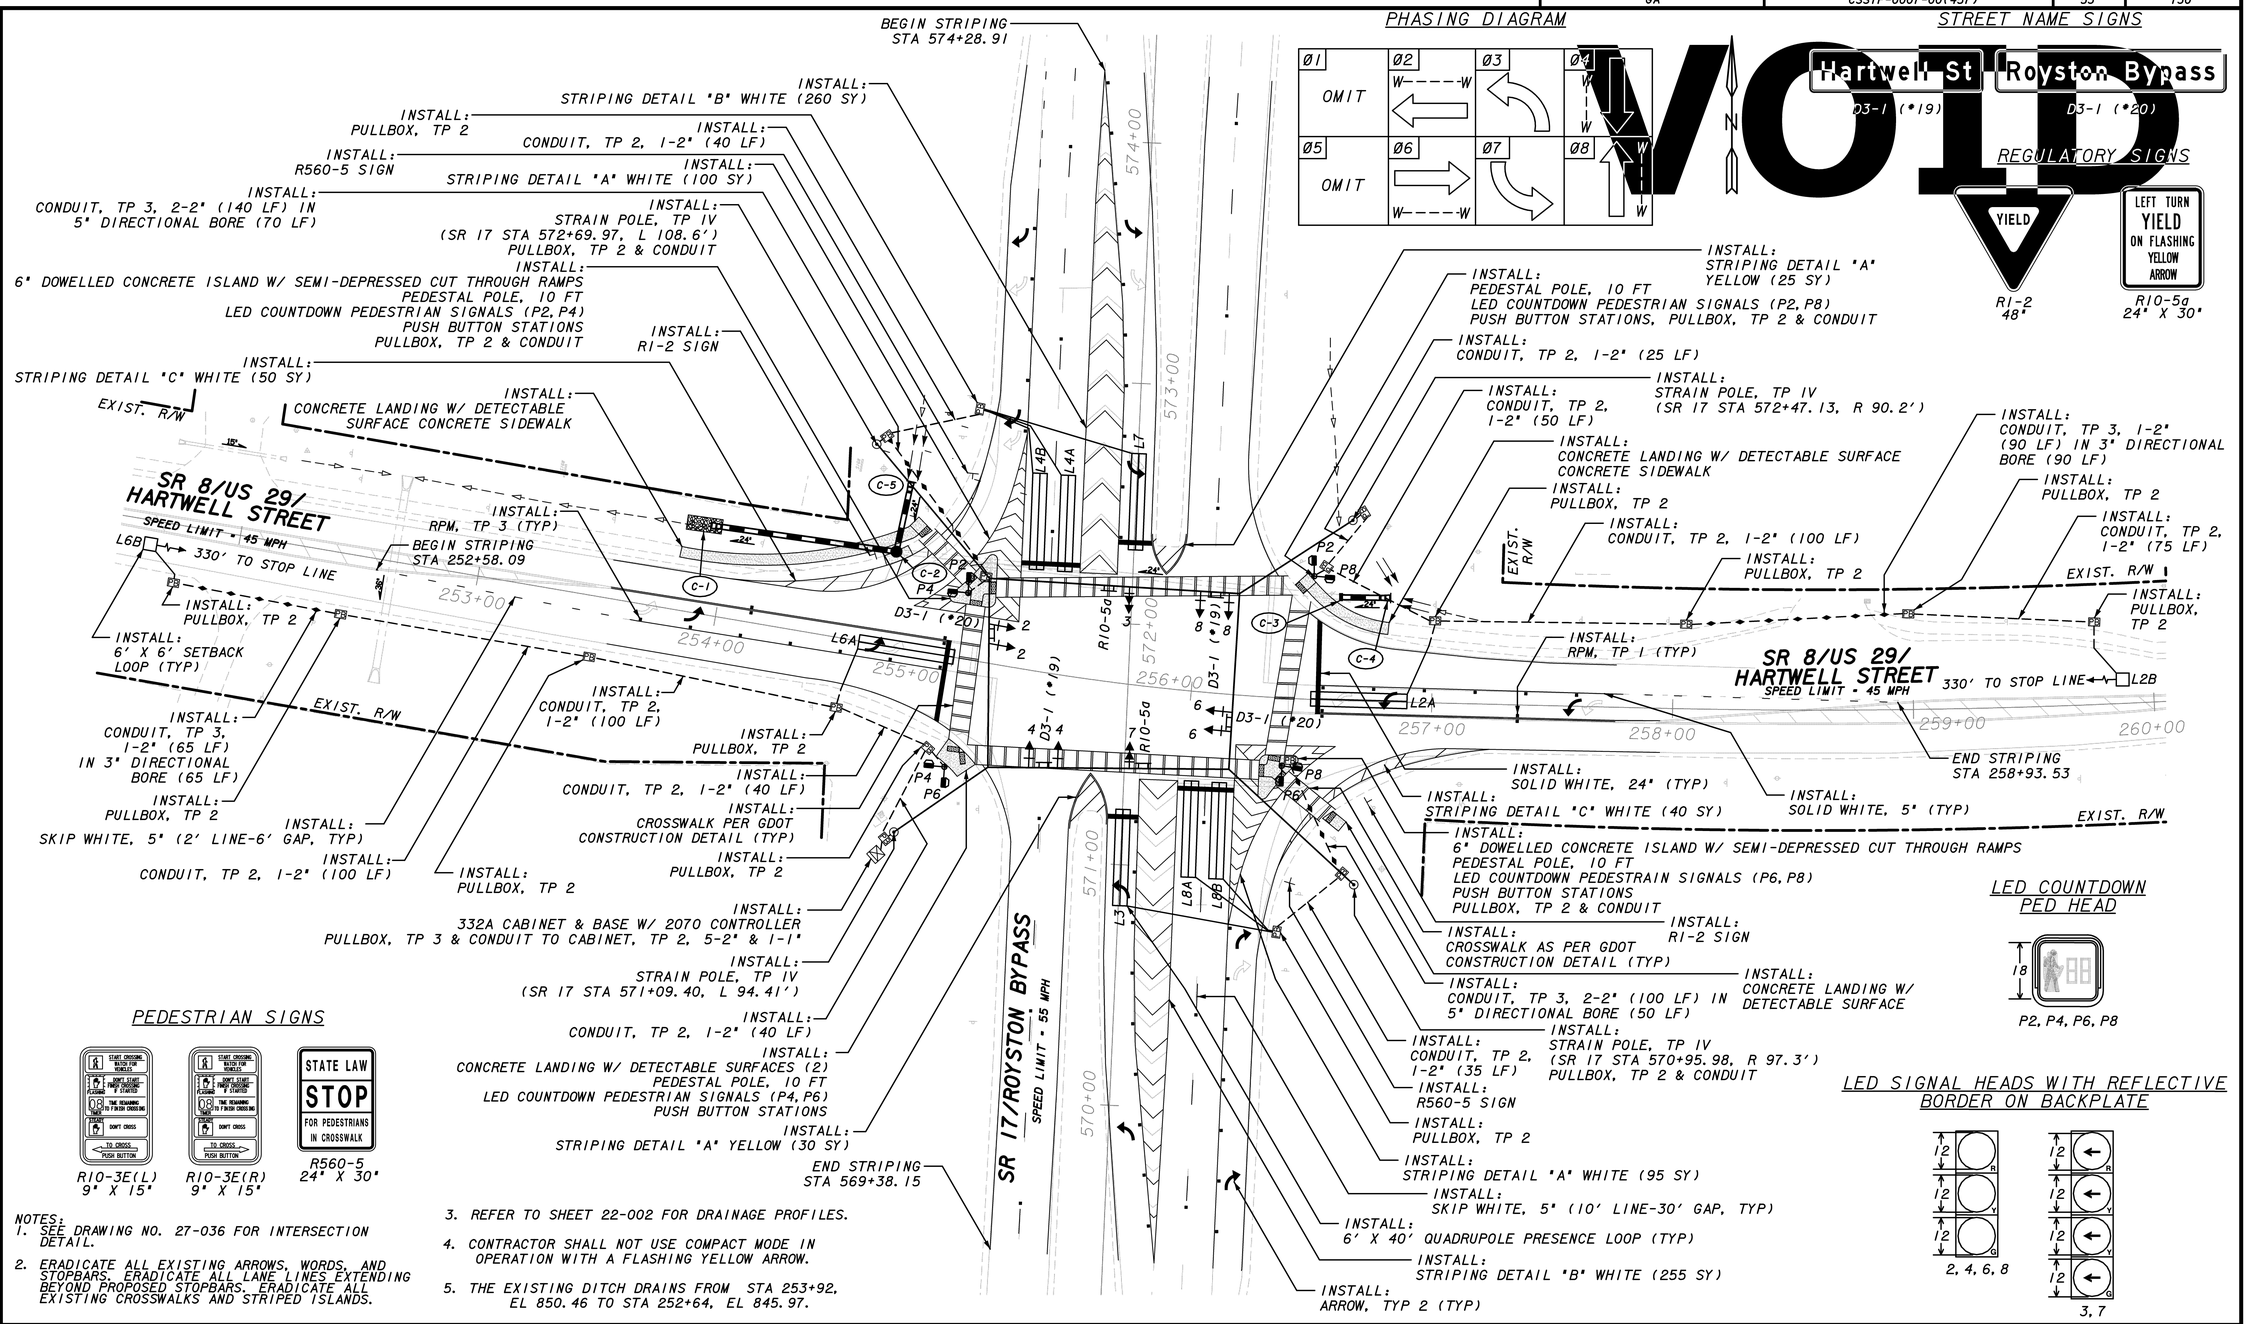


NOTES:
1. SEE DRAWING NO. 27-036 FOR INTERSECTION DETAIL.
2. ERADICATE ALL EXISTING ARROWS, WORDS, AND STOPBARS. ERADICATE ALL LANE LINES EXTENDING BEYOND PROPOSED STOPBARS. ERADICATE ALL EXISTING CROSSWALKS AND STRIPED ISLANDS.
3. REFER TO SHEET 22-002 FOR DRAINAGE PROFILES.
4. CONTRACTOR SHALL NOT USE COMPACT MODE IN OPERATION WITH A FLASHING YELLOW ARROW.
5. THE EXISTING DITCH DRAINS FROM STA 253+92, EL 850.46 TO STA 252+64, EL 845.97.


Wolverton & Associates
6745 Sugarloaf Parkway . Suite 100 . Duluth, Georgia 30097
Phone: (770) 447-8999 . Fax: (770) 447-9070
www.wolverton-assoc.com


| DESIGNED BY: | CHECKED BY: | DATE: |
|---|---|---|
| | REVIEWED BY: | DATE: |

**GEORGIA**
**DEPARTMENT OF TRANSPORTATION**

30 0 30 60 90
SCALE: 1" = 30'

REVISION DATES

STATE OF GEORGIA
DEPARTMENT OF TRANSPORTATION
OFFICE: PROGRAM DELIVERY

**CONSTRUCTION/INSTALLATION PLANS**

INTERSECTION NO. 8

SR 8/US 29/HARTWELL ST @
SR 17/ROYSTON BYPASS

DRAWING No.
**27-033**