| 12/19/2008 9:37:48 AM | 63732-KIA | g:\tra\63732-kia\rdy\0082321r01.dgn | COUNTY | PROJECT NUMBER | SHEET NO. | TOTAL SHEETS |
|---|---|---|---|---|---|---|
| clanz | AGMENG.tbl | | TROUP | CSNHS-0008-00(232) | 25 | 839 |

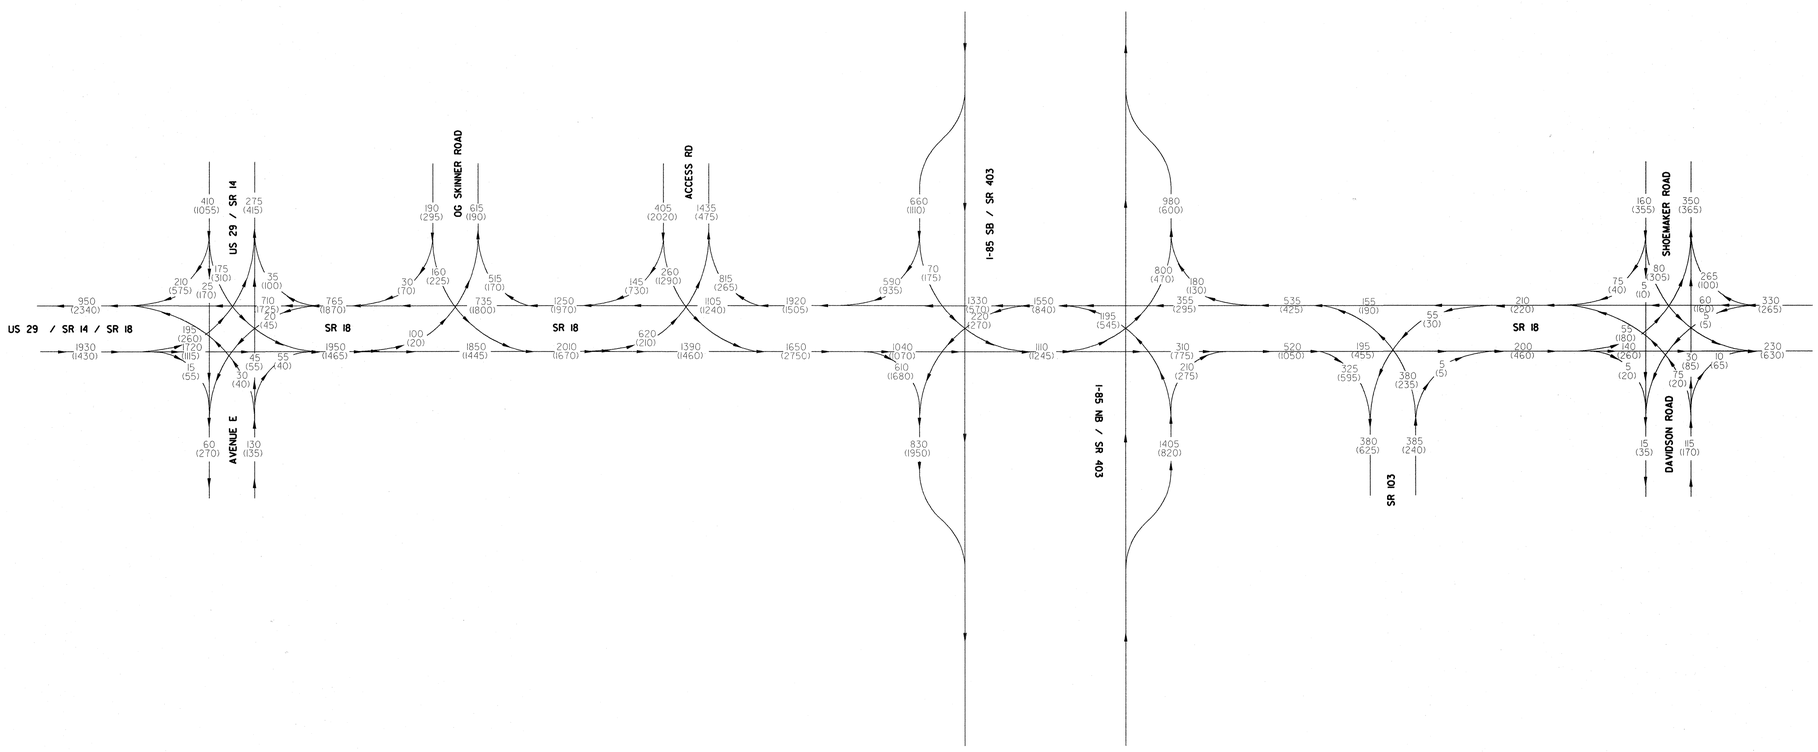


| I-85 |
|---|
| T = 18% |
| 24 HOUR T = 21% |
| S.U. = 4.00% |
| COMB. = 17.00% |

| SR 18 |
|---|
| T = 5% |
| 24 HOUR T = 7.50% |
| S.U. = 4.00% |
| COMB. = 3.50% |

CSNHS-0008-00(232)
P.I.# 0008232
TROUP COUNTY

2029 A.M. DHV = 000
2029 P.M. DHV = (000)

ARCADIS
Infrastructure, environment, facilities

REVISION DATES

STATE OF GEORGIA
DEPARTMENT OF TRANSPORTATION
OFFICE: URBAN DESIGN
YEAR 2029 PEAK HOUR TRAFFIC
TRAFFIC FLOW DIAGRAM
I-85 INTERCHANGE
AT CR 98/GABBETTVILLE RD

DRAWING No. 10-01

AS-BUILT

PLAN DATE: 09-07-07