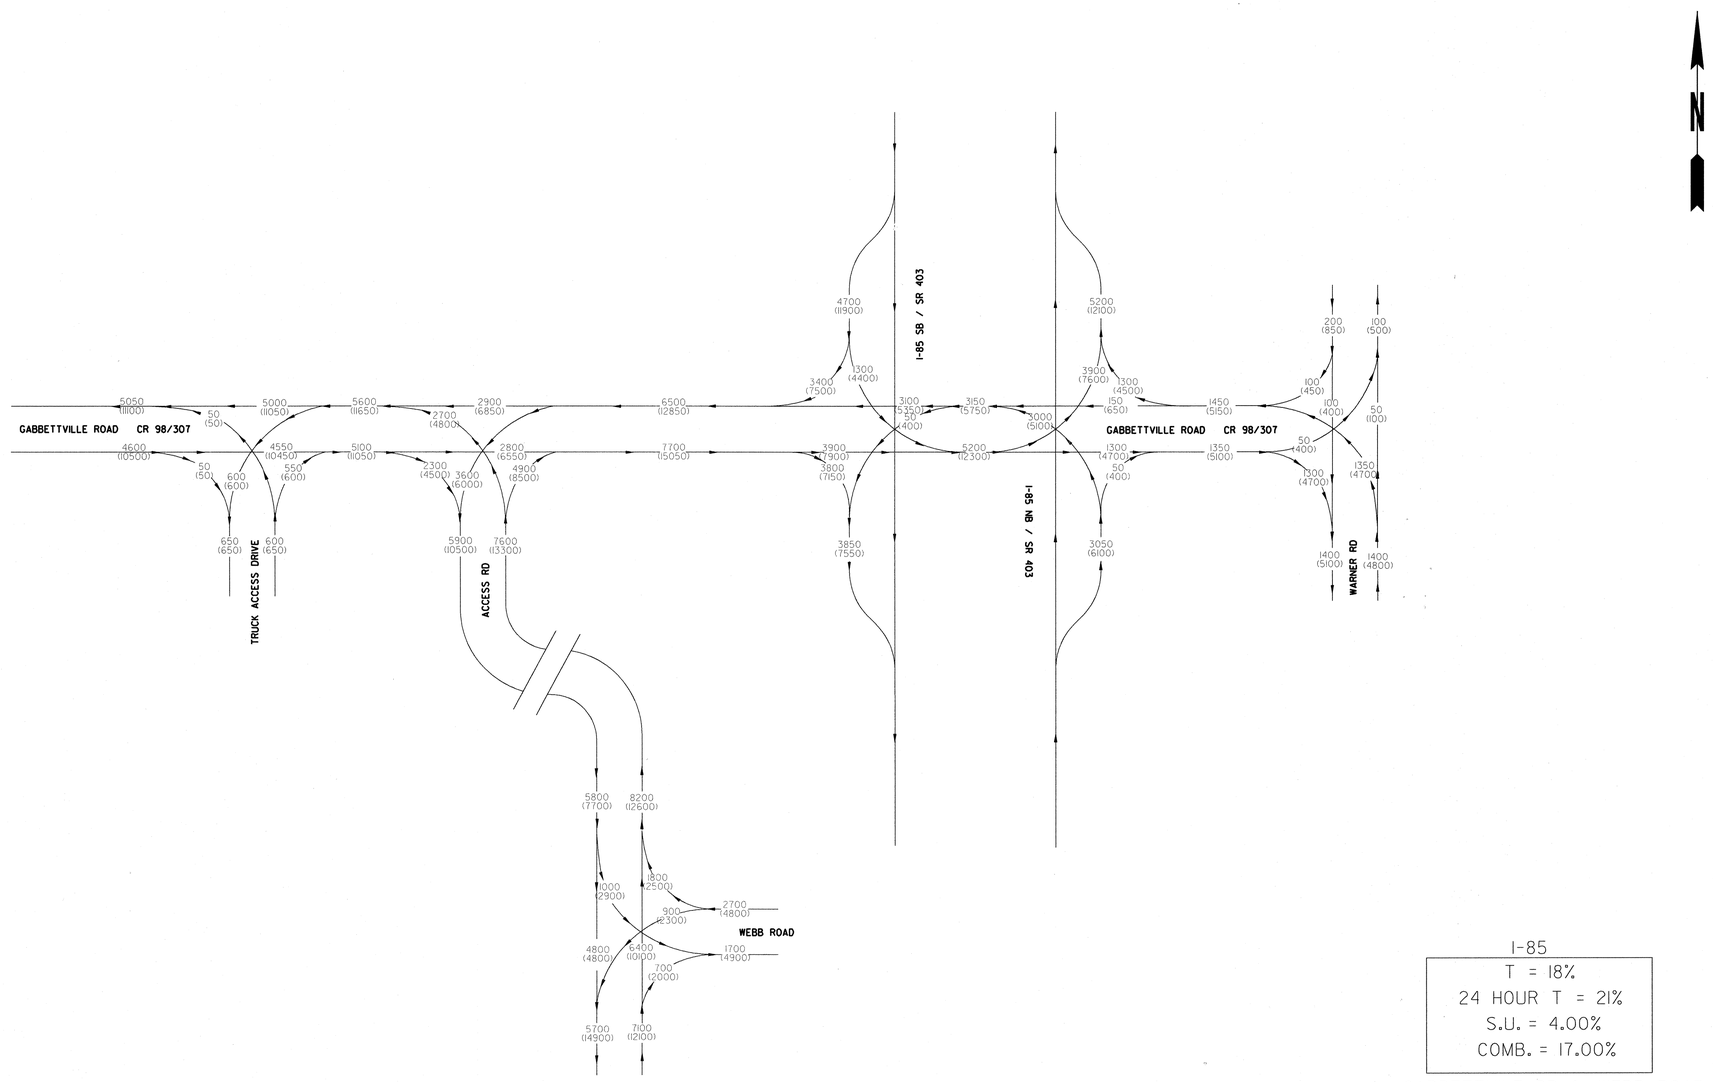

I-85

T = 18%
24 HOUR T = 21%
S.U. = 4.00%
COMB. = 17.00%

GABBETTVILE RD & WEBB ROAD

T = 8.00%
24 HOUR T = 10.00%
S.U. = 7.00%
COMB. = 3.00%

CSNHS-0008-00(232)
P.I.# 0008232
TROUP COUNTY

2009 ADT = 000
2029 ADT = (000)

ARCADIS
Infrastructure, environment, facilities

REVISION DATES

STATE OF GEORGIA
DEPARTMENT OF TRANSPORTATION
OFFICE: URBAN DESIGN
YEAR 2009 (2029) AVERAGE DAILY TRAFFIC
TRAFFIC FLOW DIAGRAM
I-85 INTERCHANGE
AT CR 98/GABBETTVILLE RD

DRAWING No. 10-06

AS-BUILT

PLAN DATE: 09-07-07