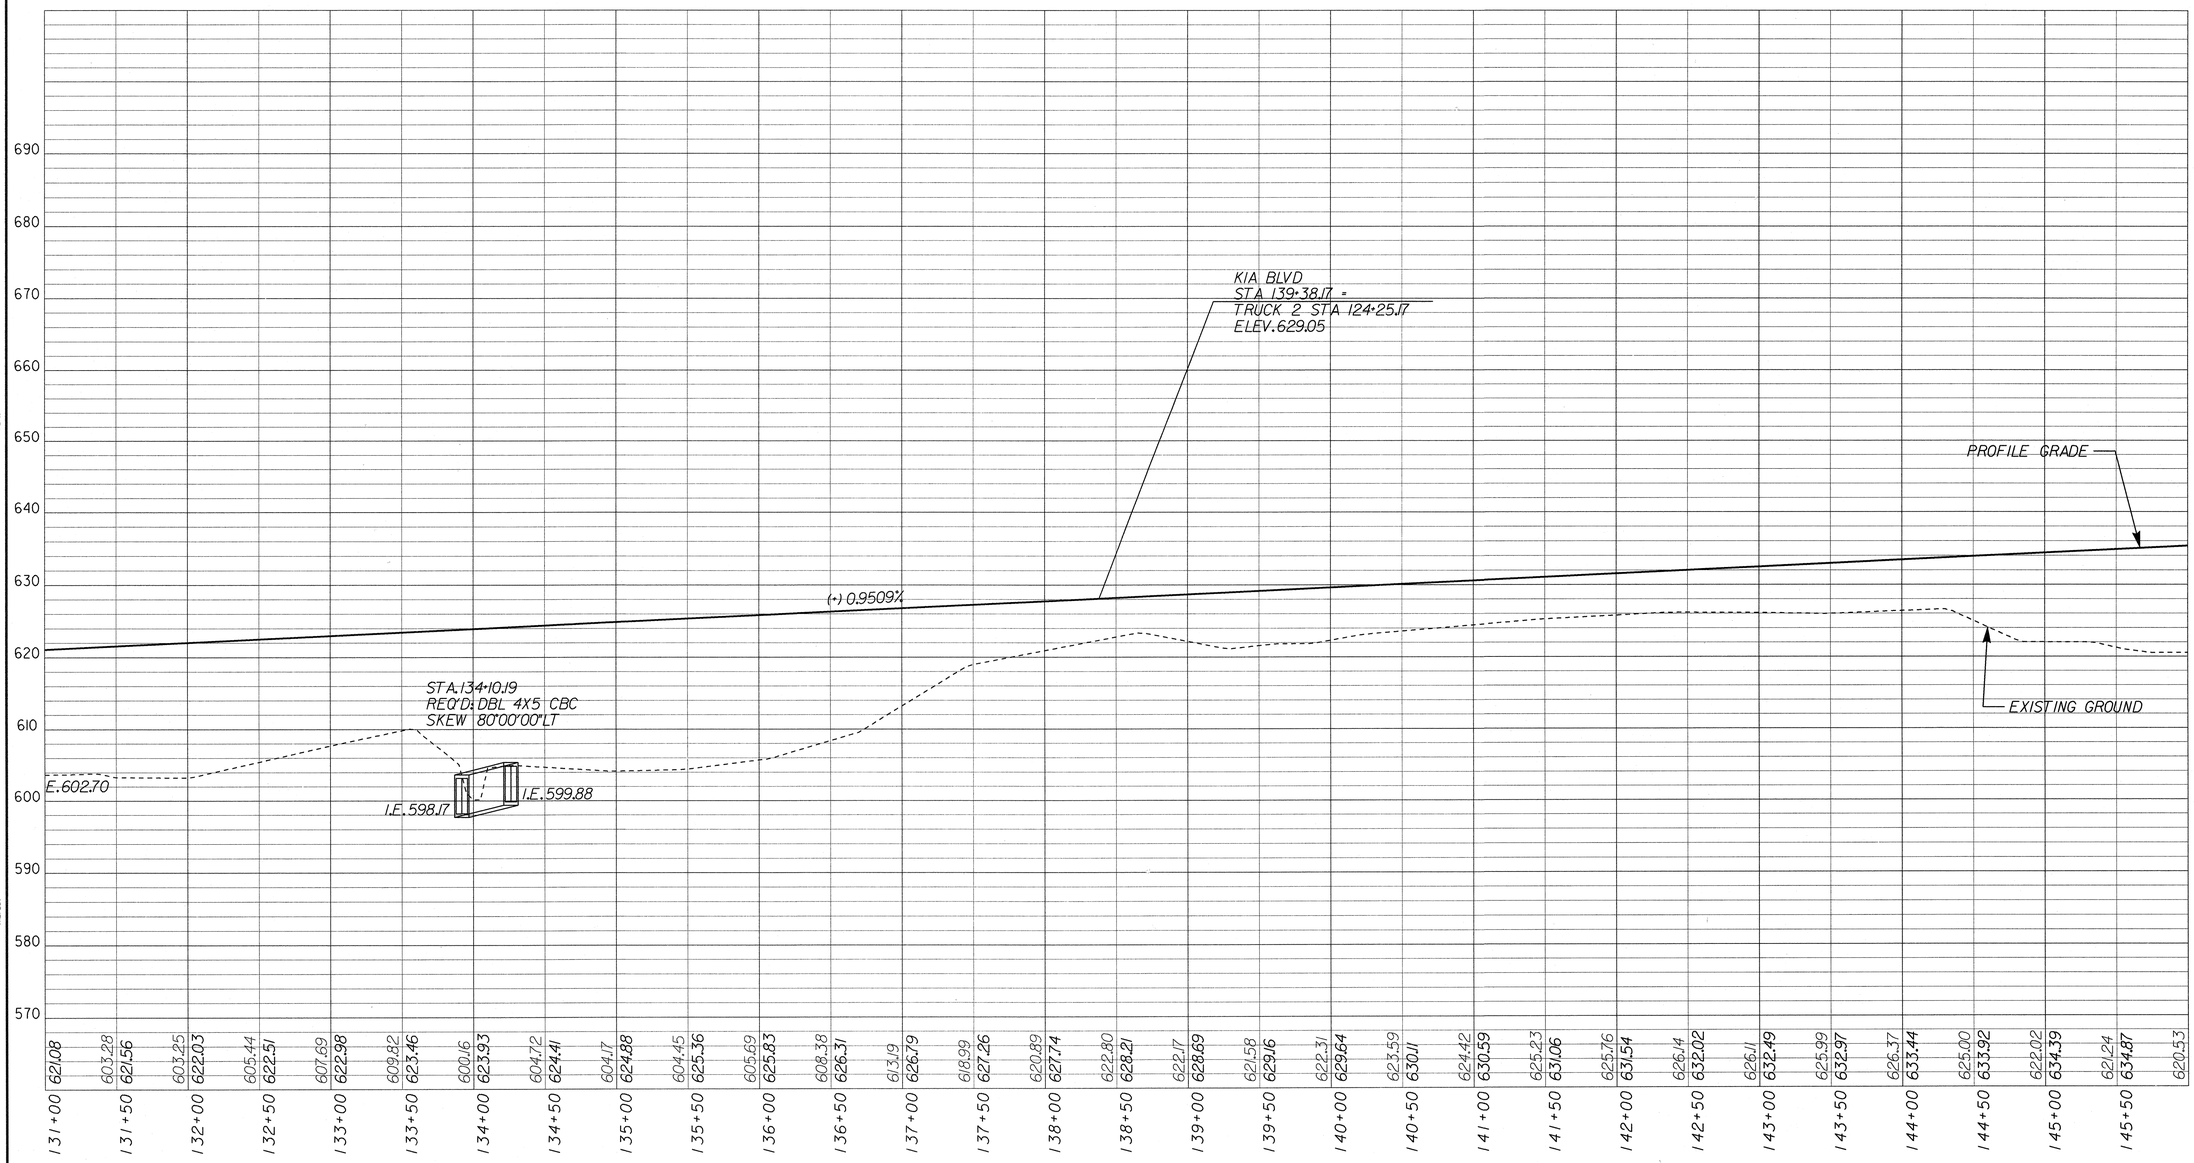

AS-BUILT

ARCADIS
Infrastructure, environment, facilities

SCALE: 1"=50' HORIZONTAL
1"=10' VERTICAL

REVISION DATES		

STATE OF GEORGIA
DEPARTMENT OF TRANSPORTATION
OFFICE: URBAN DESIGN

MAINLINE PROFILE
KIA BOULEVARD

I-85 INTERCHANGE
AT CR 98/GABBETTVILLE RD

DRAWING No. 15-03