12/19/2008	10:16:04 AM	63732-KIA	g:\trq\63732-kia\rdy\008232xp03.dgn	COUNTY	PROJECT NUMBER	SHEET NO.	TOTAL SHEETS
clanz		AGMENG.tbl		TROUP	CSNHS-0008-00(232)	104A	839

AS-BUILT

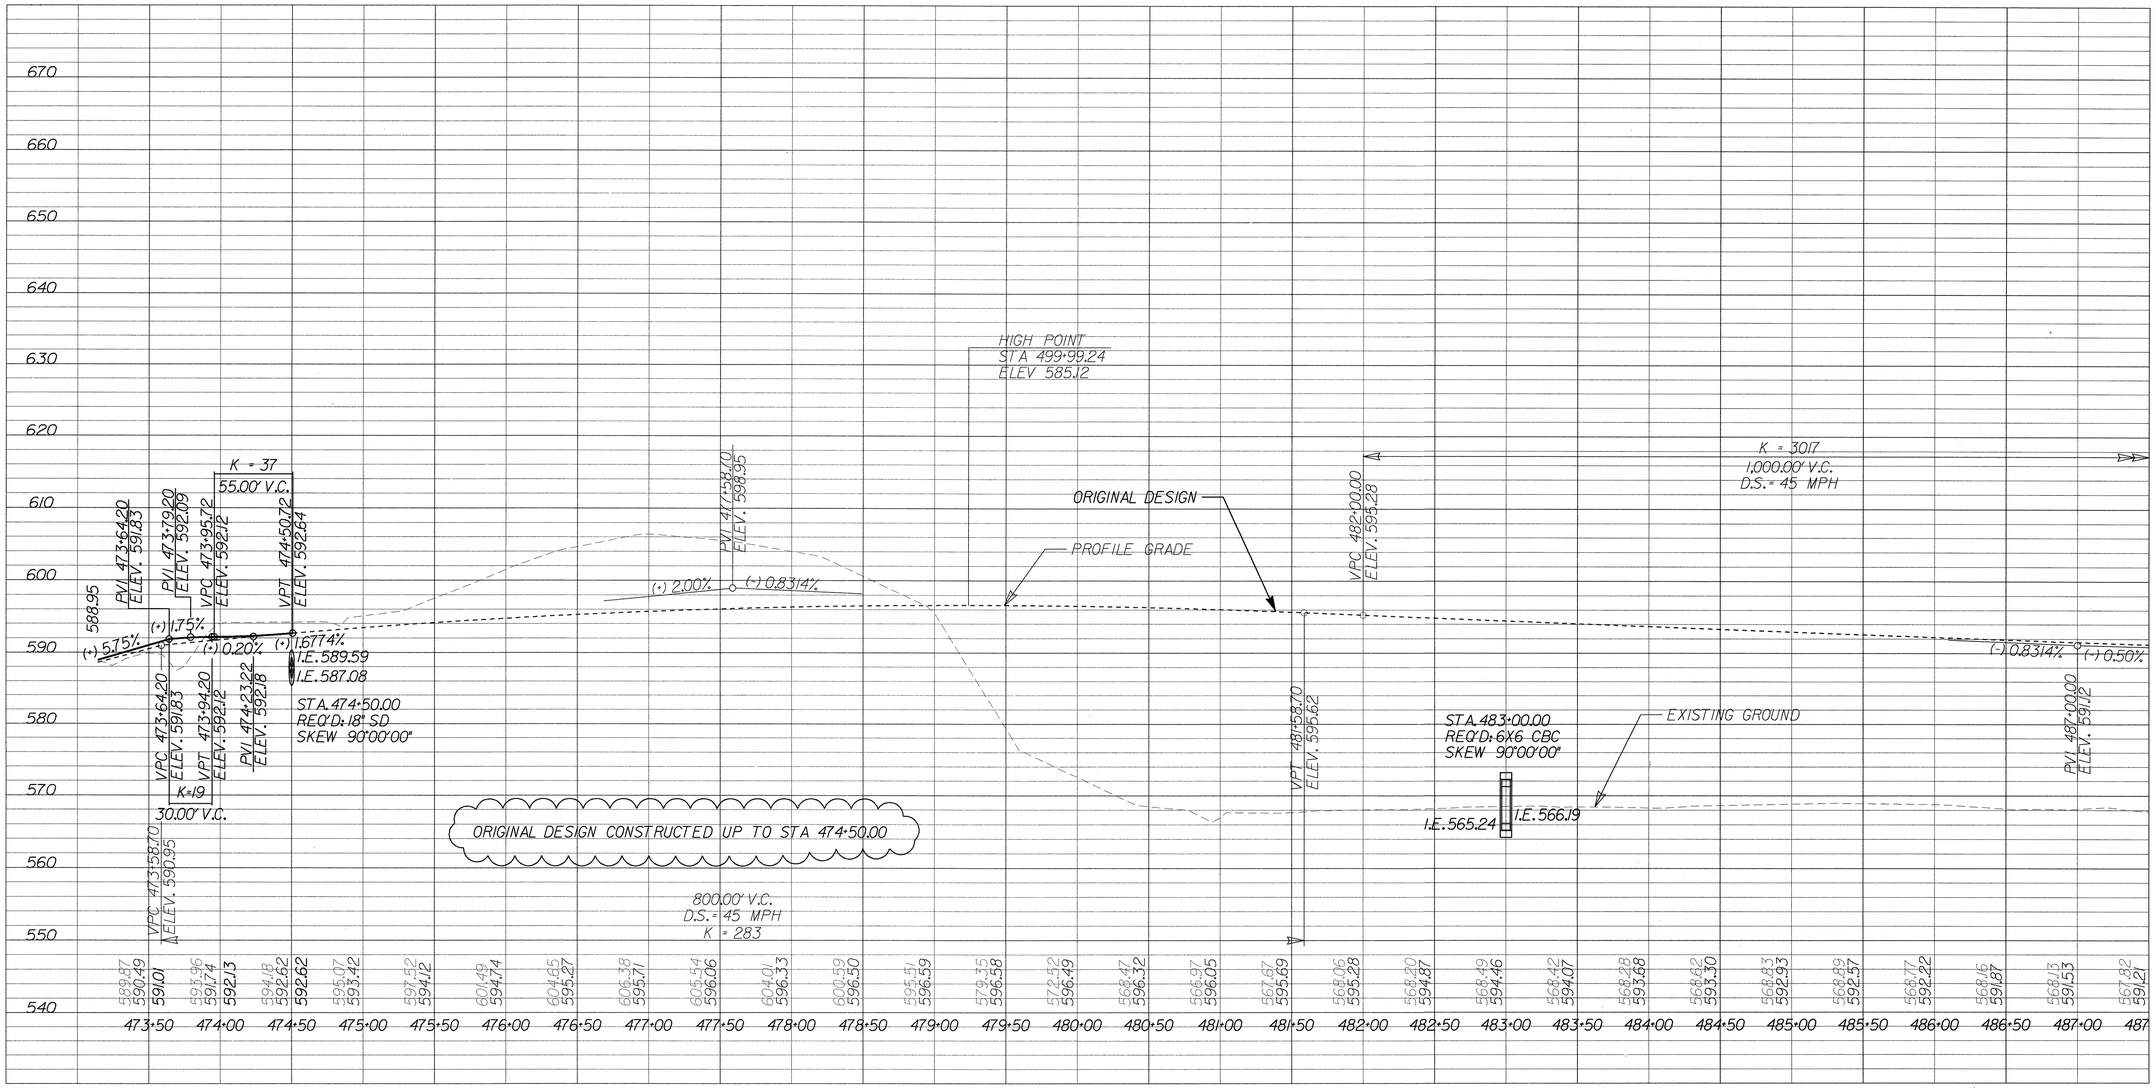

ARCADIS
Infrastructure, environment, facilities

REVISION DATES
05/06/08

STATE OF GEORGIA
DEPARTMENT OF TRANSPORTATION
OFFICE: URBAN DESIGN

CROSSROAD PROFILE
KIA PARKWAY
I-85 INTERCHANGE
AT CR 98/GABBETTVILLE RD

DRAWING No. 16-04a