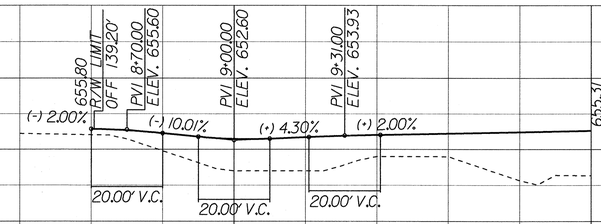

DW 25
KIA PKWY 1623+49.10 LT
PGL ELEV. 655.31

DW 24 STA 10+00=
WARNER RD, STA 135+50
ELEV 731.41

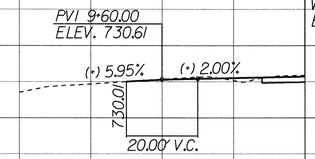

DW 24
WARNER RD, 135+50.00 LT
PGL ELEV. 731.41

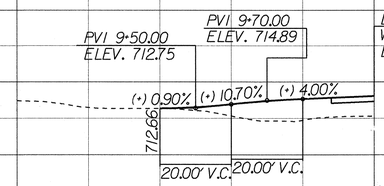

DW 23 STA 10+00=
WARNER RD, STA 130+20
ELEV 716.09

DW 23
WARNER RD, 130+20.00 LT
PGL ELEV. 716.09

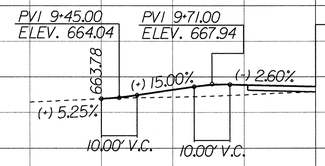

DW 24 STA 10+00=
WARNER RD, STA 112+40
ELEV 667.19

DW 22
WARNER RD, 112+40.00 LT
PGL ELEV. 667.19

AS-BUILT

ARCADIS
Infrastructure, environment, facilities

SCALE: 1"=20' HORIZONTAL
1"=20' VERTICAL

REVISION DATES		
01-25-08		

STATE OF GEORGIA
DEPARTMENT OF TRANSPORTATION
OFFICE: URBAN DESIGN

DRIVEWAY PROFILE

I-85 INTERCHANGE
AT CR 98/GABBETTVILLE RD

DRAWING No. 17-06