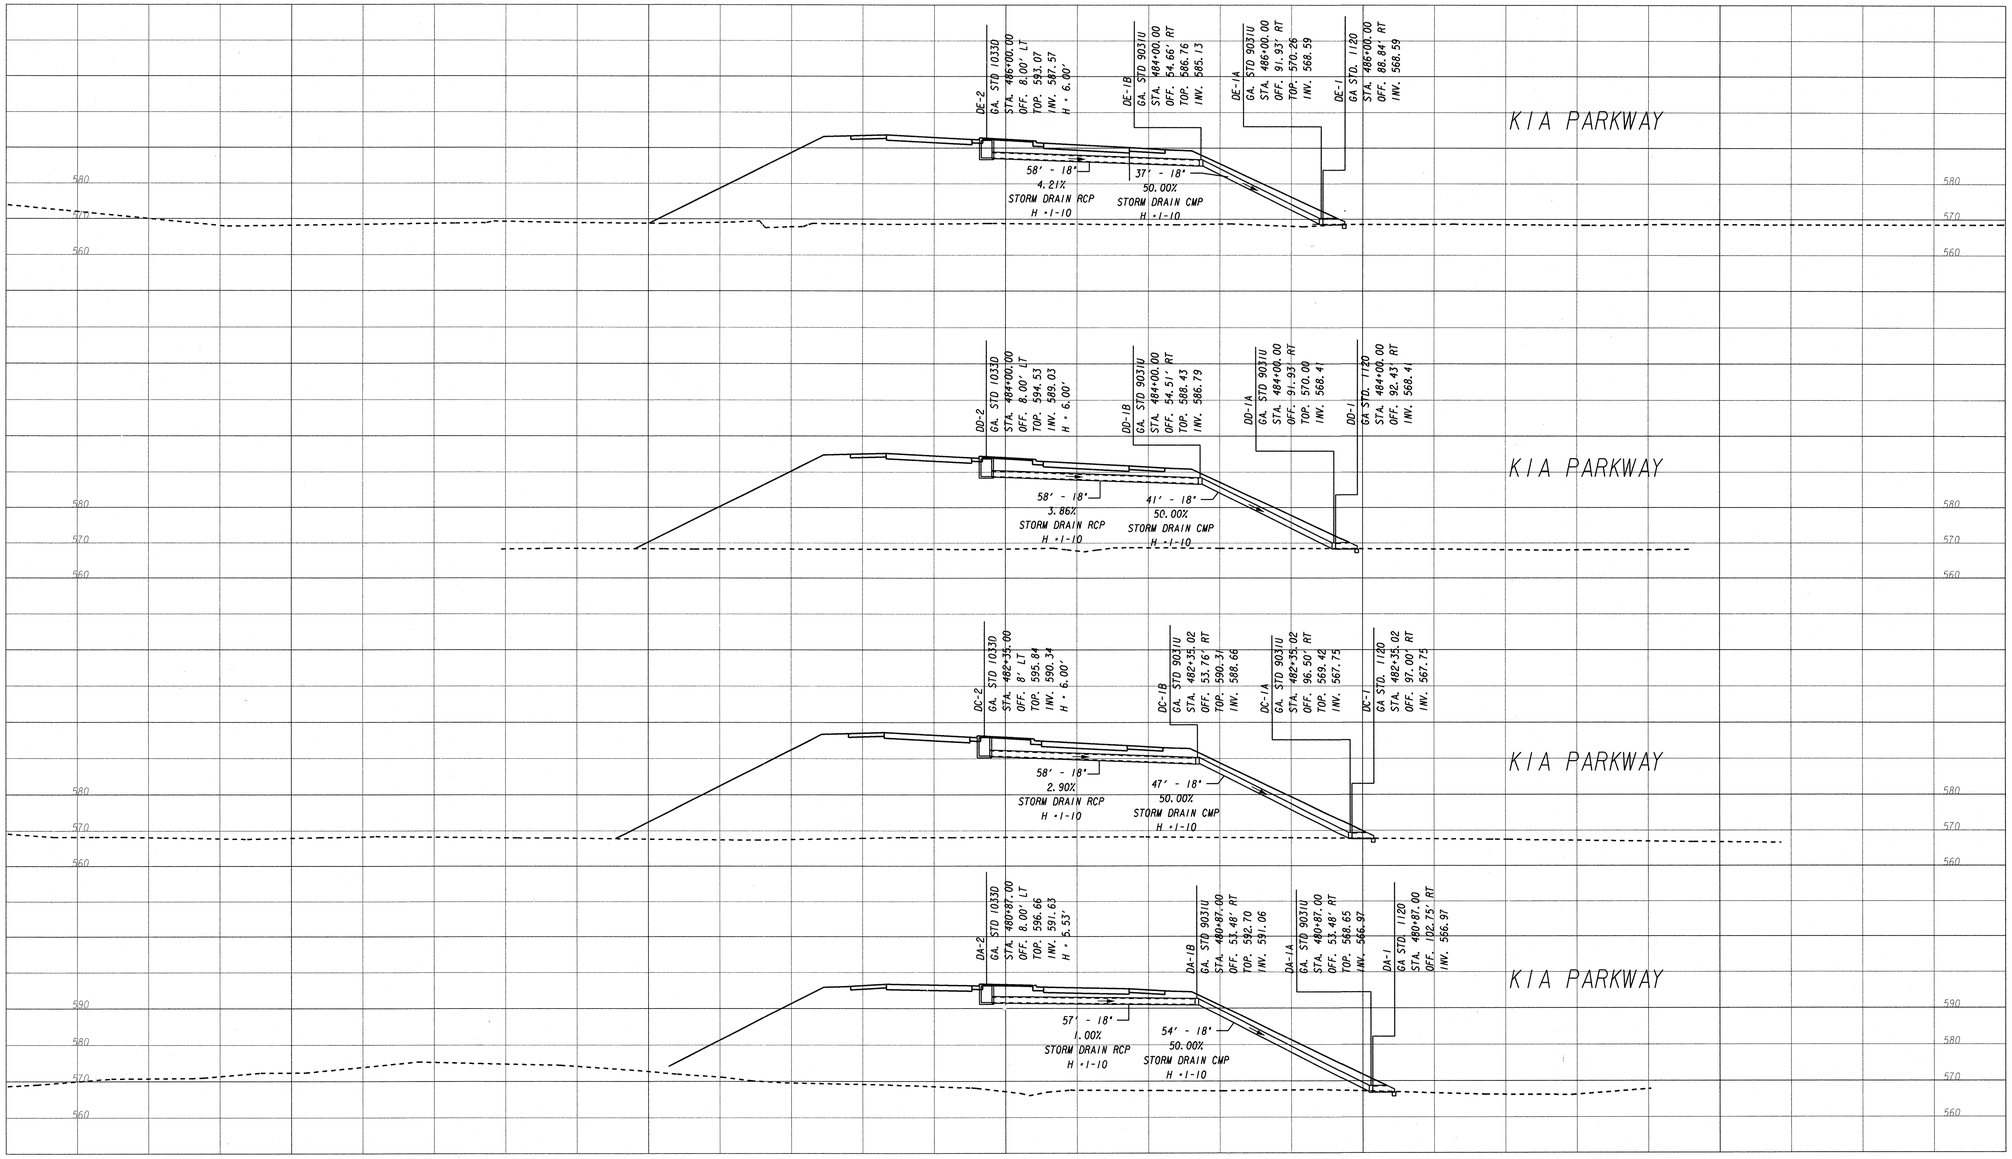

AS-BUILT

ARCADIS
Infrastructure, environment, facilities

SCALE: 1" = 10' HORIZONTAL
1" = 10' VERTICAL

REVISION DATES		

STATE OF GEORGIA
DEPARTMENT OF TRANSPORTATION
OFFICE: URBAN DESIGN

DRAINAGE PROFILES

I-85 INTERCHANGE
AT CR 98/GABBETTVILLE RD

DRAWING No. 22-02