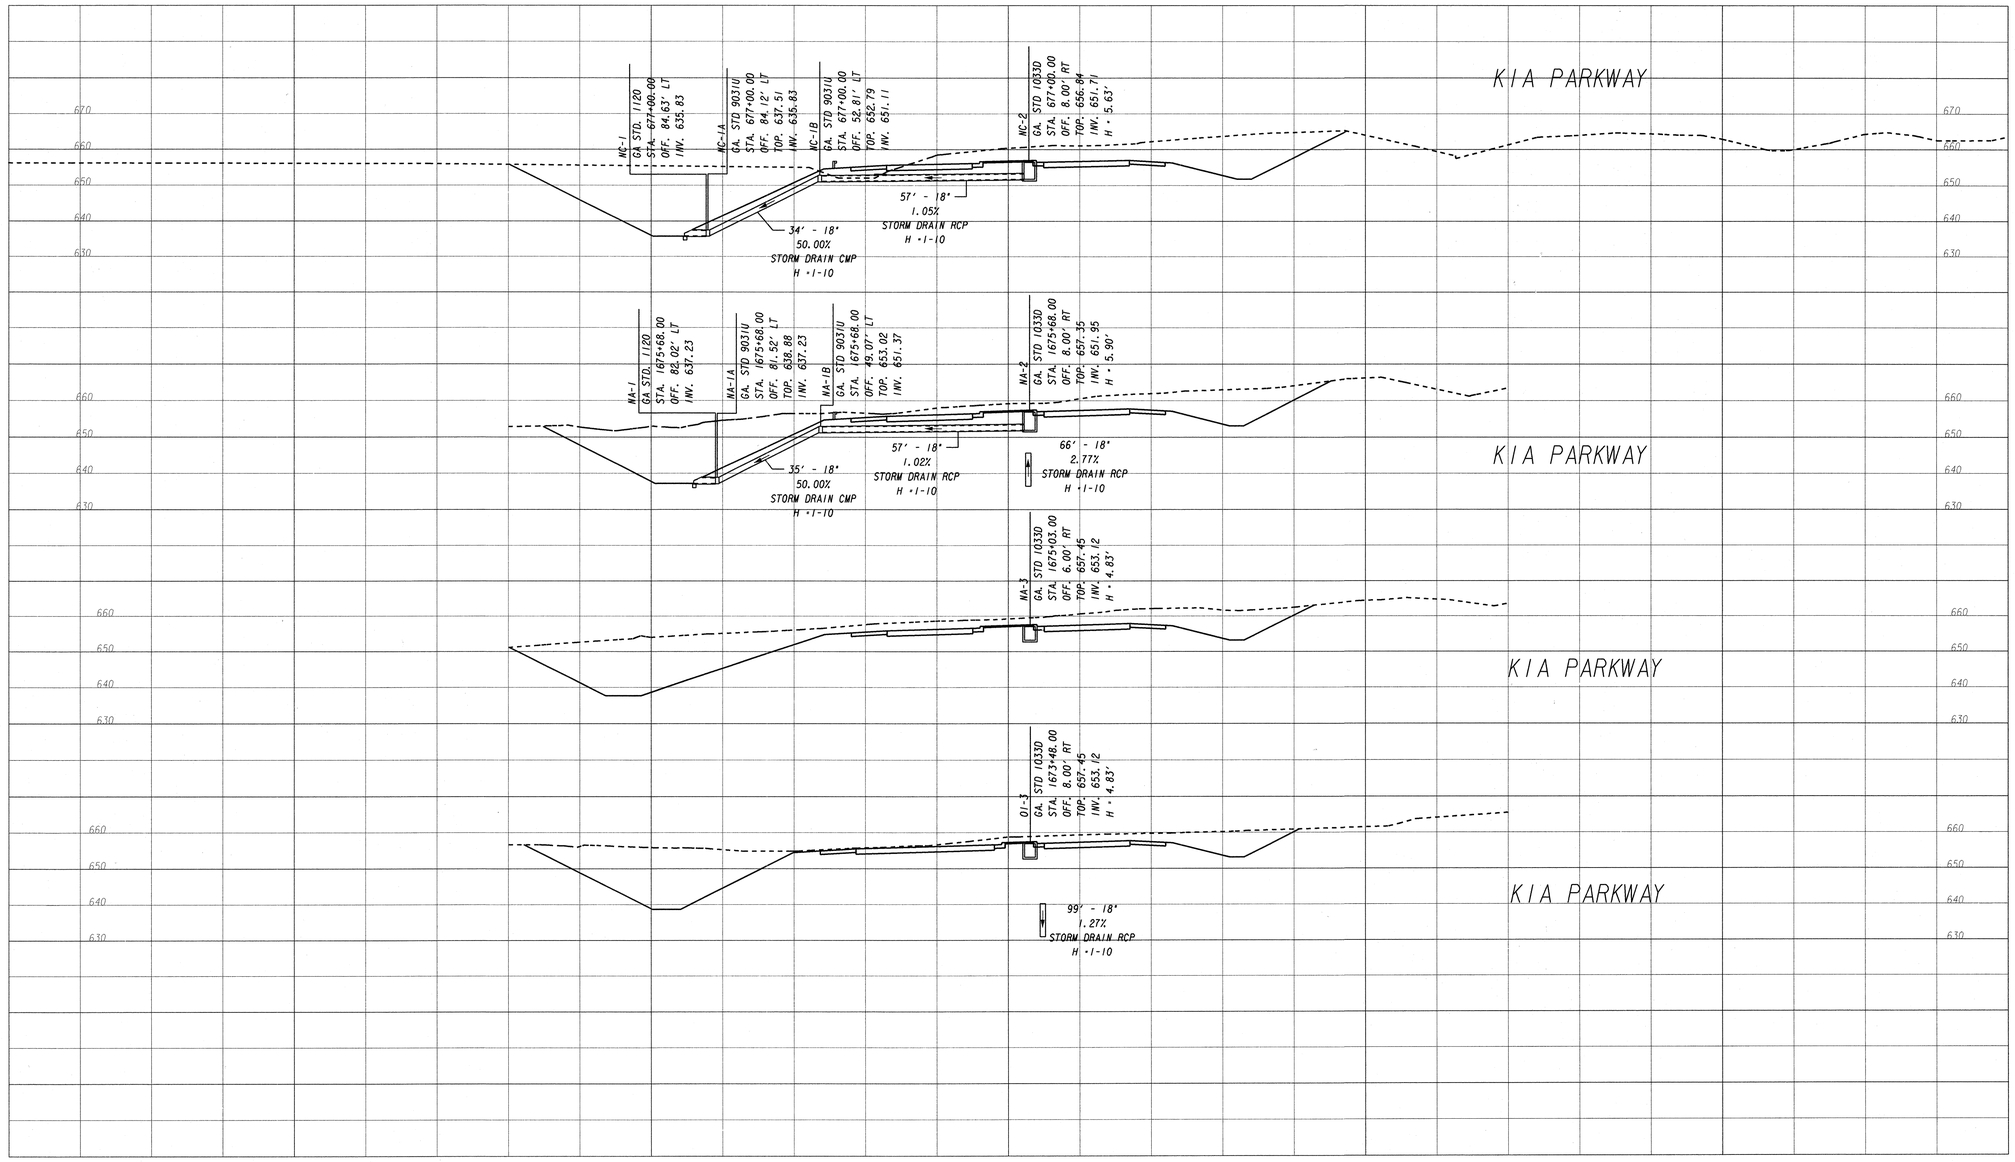

AS-BUILT

ARCADIS
Infrastructure, environment, facilities

SCALE: 1"=10' HORIZONTAL
1"=10' VERTICAL

REVISION DATES

STATE OF GEORGIA
DEPARTMENT OF TRANSPORTATION

OFFICE: URBAN DESIGN

DRAINAGE PROFILES

I-85 INTERCHANGE
AT CR 98/GABBETTVILLE RD

DRAWING No. 22-10