12/19/2008 10:53:08 AM	63732-KIA	G:\TRA\63732-KIA\rdy\008232XS01.dgn	COUNTY	PROJECT NUMBER	SHEET NO.	TOTAL SHEETS
clanz	AGMENG.tbl		TROUP	CSNHS-0008-00(232)	179	839

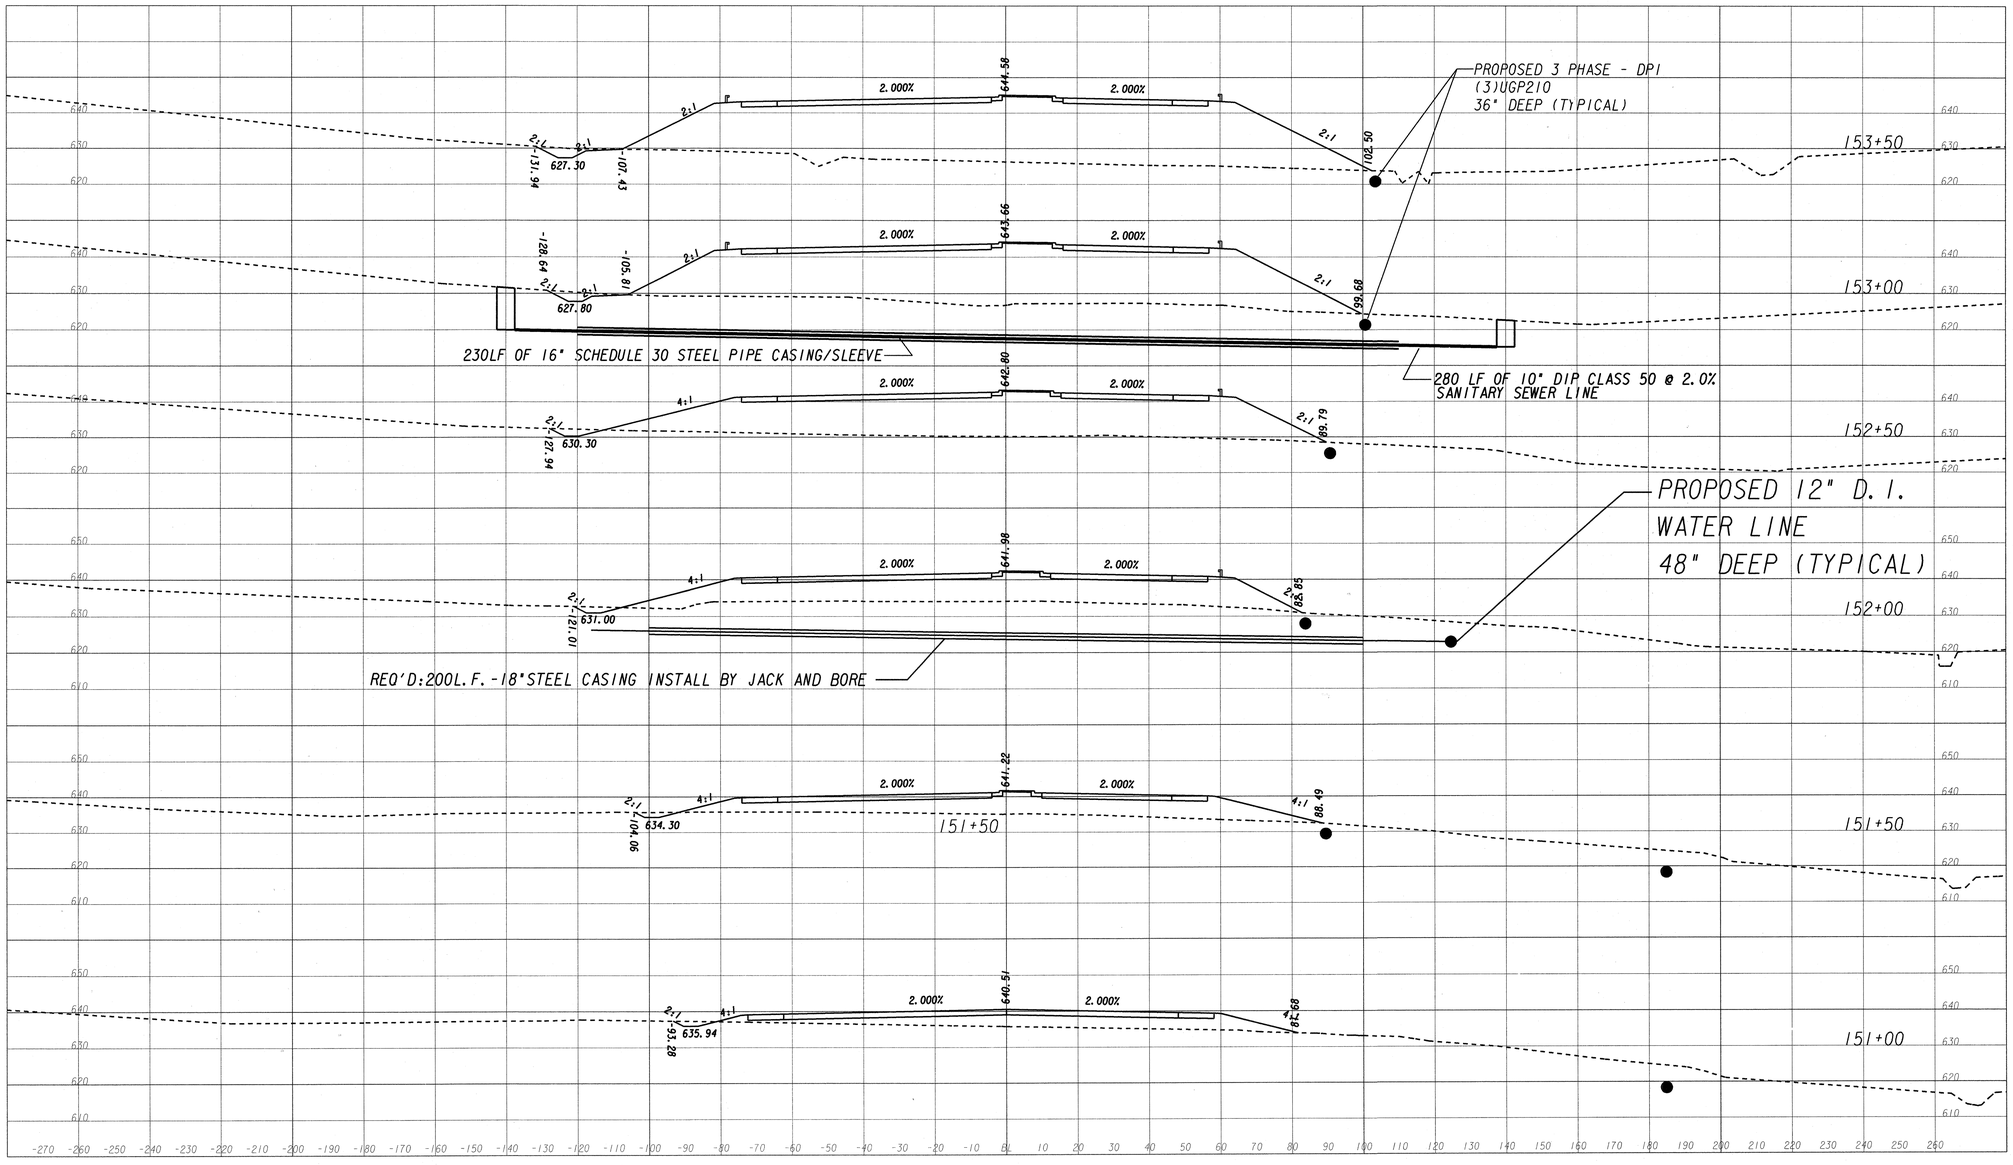

AS-BUILT

PLAN DATE: 09-07-07

ARCADIS
Infrastructure, environment, facilities

SCALE: 1"=20' HORIZONTAL
1"=20' VERTICAL

REVISION DATES
09-18-07
09-28-07
04-09-08
08-01-08

STATE OF GEORGIA
DEPARTMENT OF TRANSPORTATION
OFFICE: URBAN DESIGN

EARTHWORK CROSS SECTIONS
KIA BOULEVARD
I-85 INTERCHANGE
AT CR 98/GABBETTVILLE RD

DRAWING No. 23-15