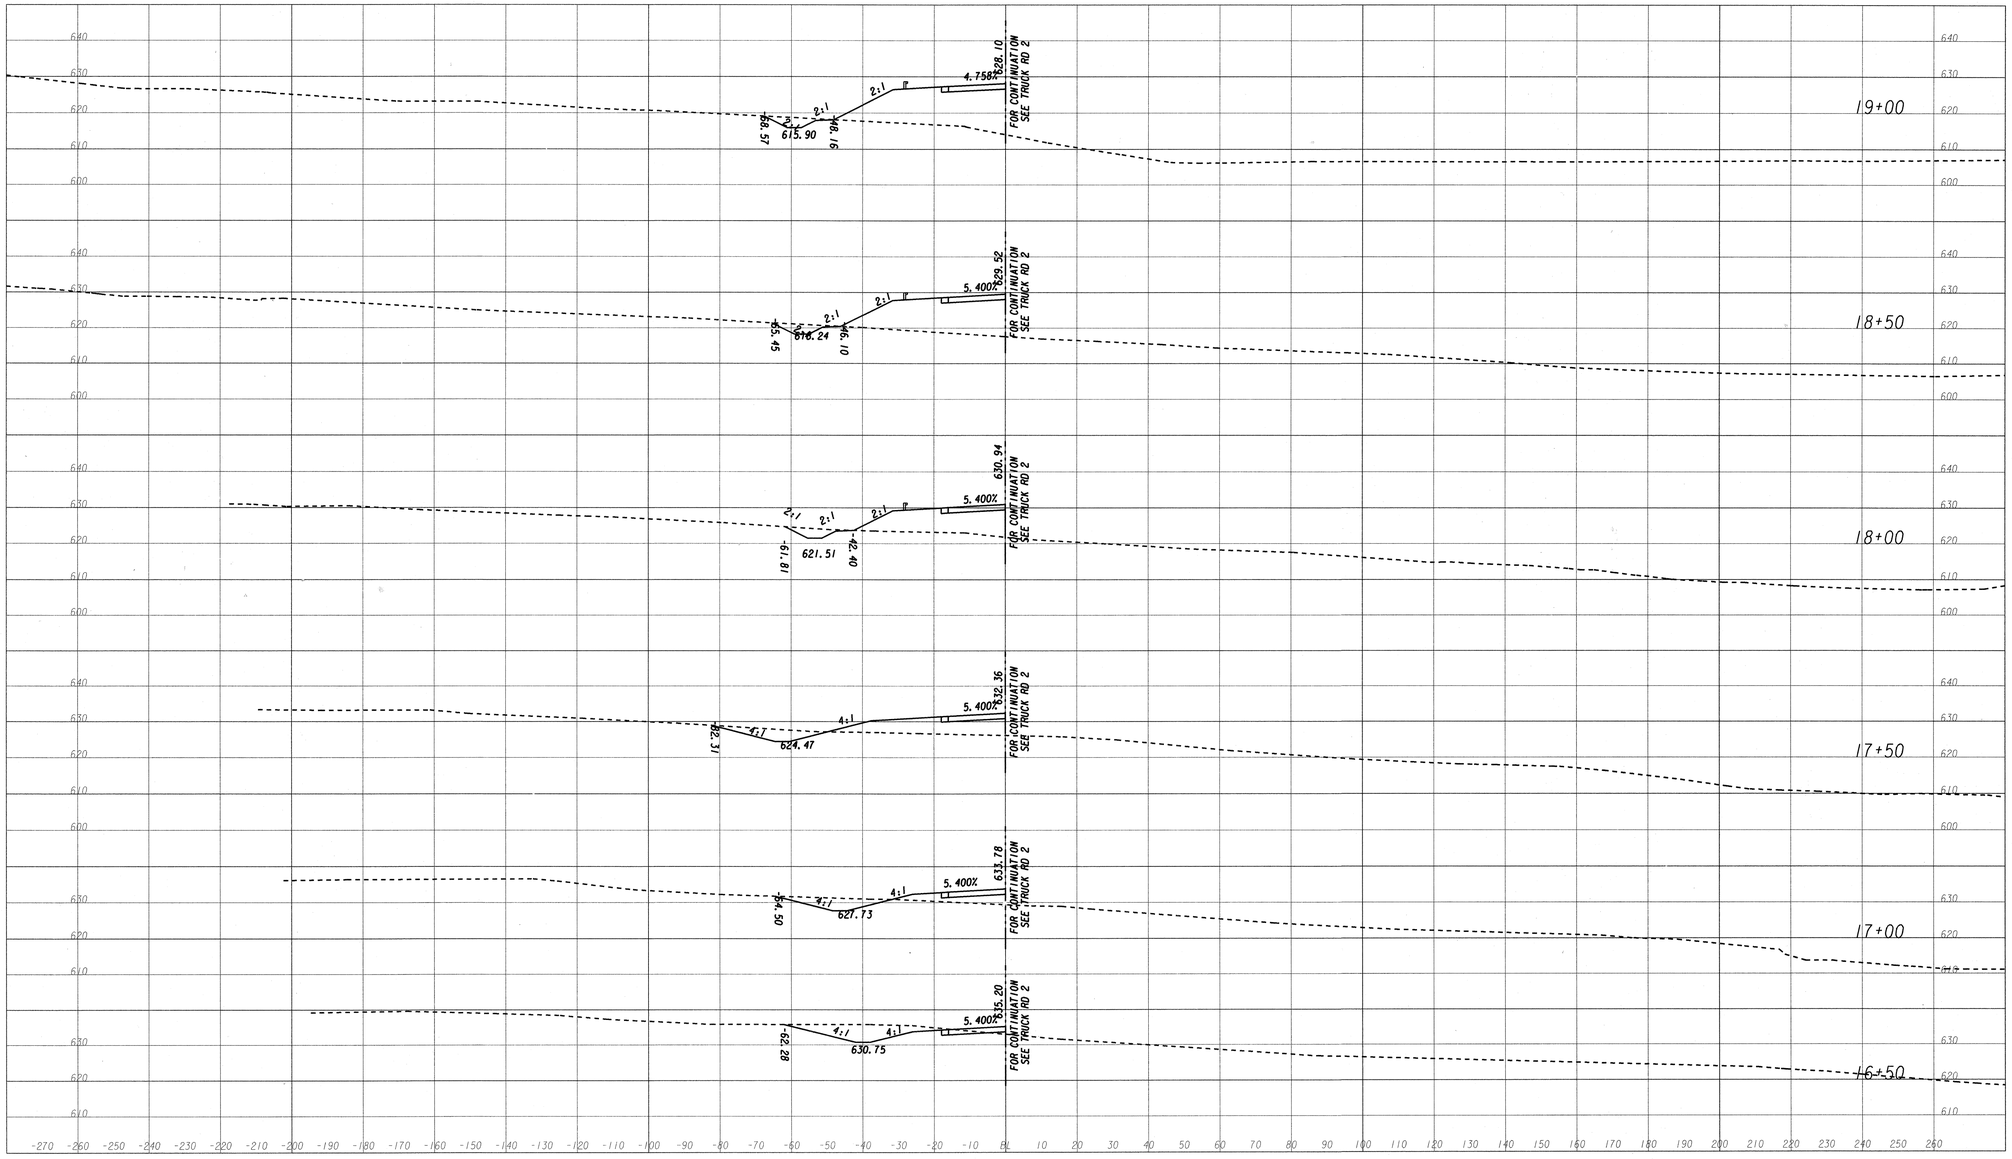

AS-BUILT

ARCADIS
Infrastructure, environment, facilities

SCALE: 1"=20' HORIZONTAL
1"=20' VERTICAL

REVISION DATES

STATE OF GEORGIA
DEPARTMENT OF TRANSPORTATION

OFFICE: URBAN DESIGN

EARTHWORK CROSS SECTIONS

TRUCK RD 1 (2 LANE)

I-85 INTERCHANGE
AT CR 98/GABBETTVILLE RD

DRAWING No. 23-28