12/19/2008 10:53:11 AM 63732-KIA g:\tra\63732-kla\rdy\008232xs02b.dgn
clanz AGMENG.tbl

COUNTY	PROJECT NUMBER	SHEET NO.	TOTAL SHEETS
TROUP	CSNHS-0008-00(232)	197	839

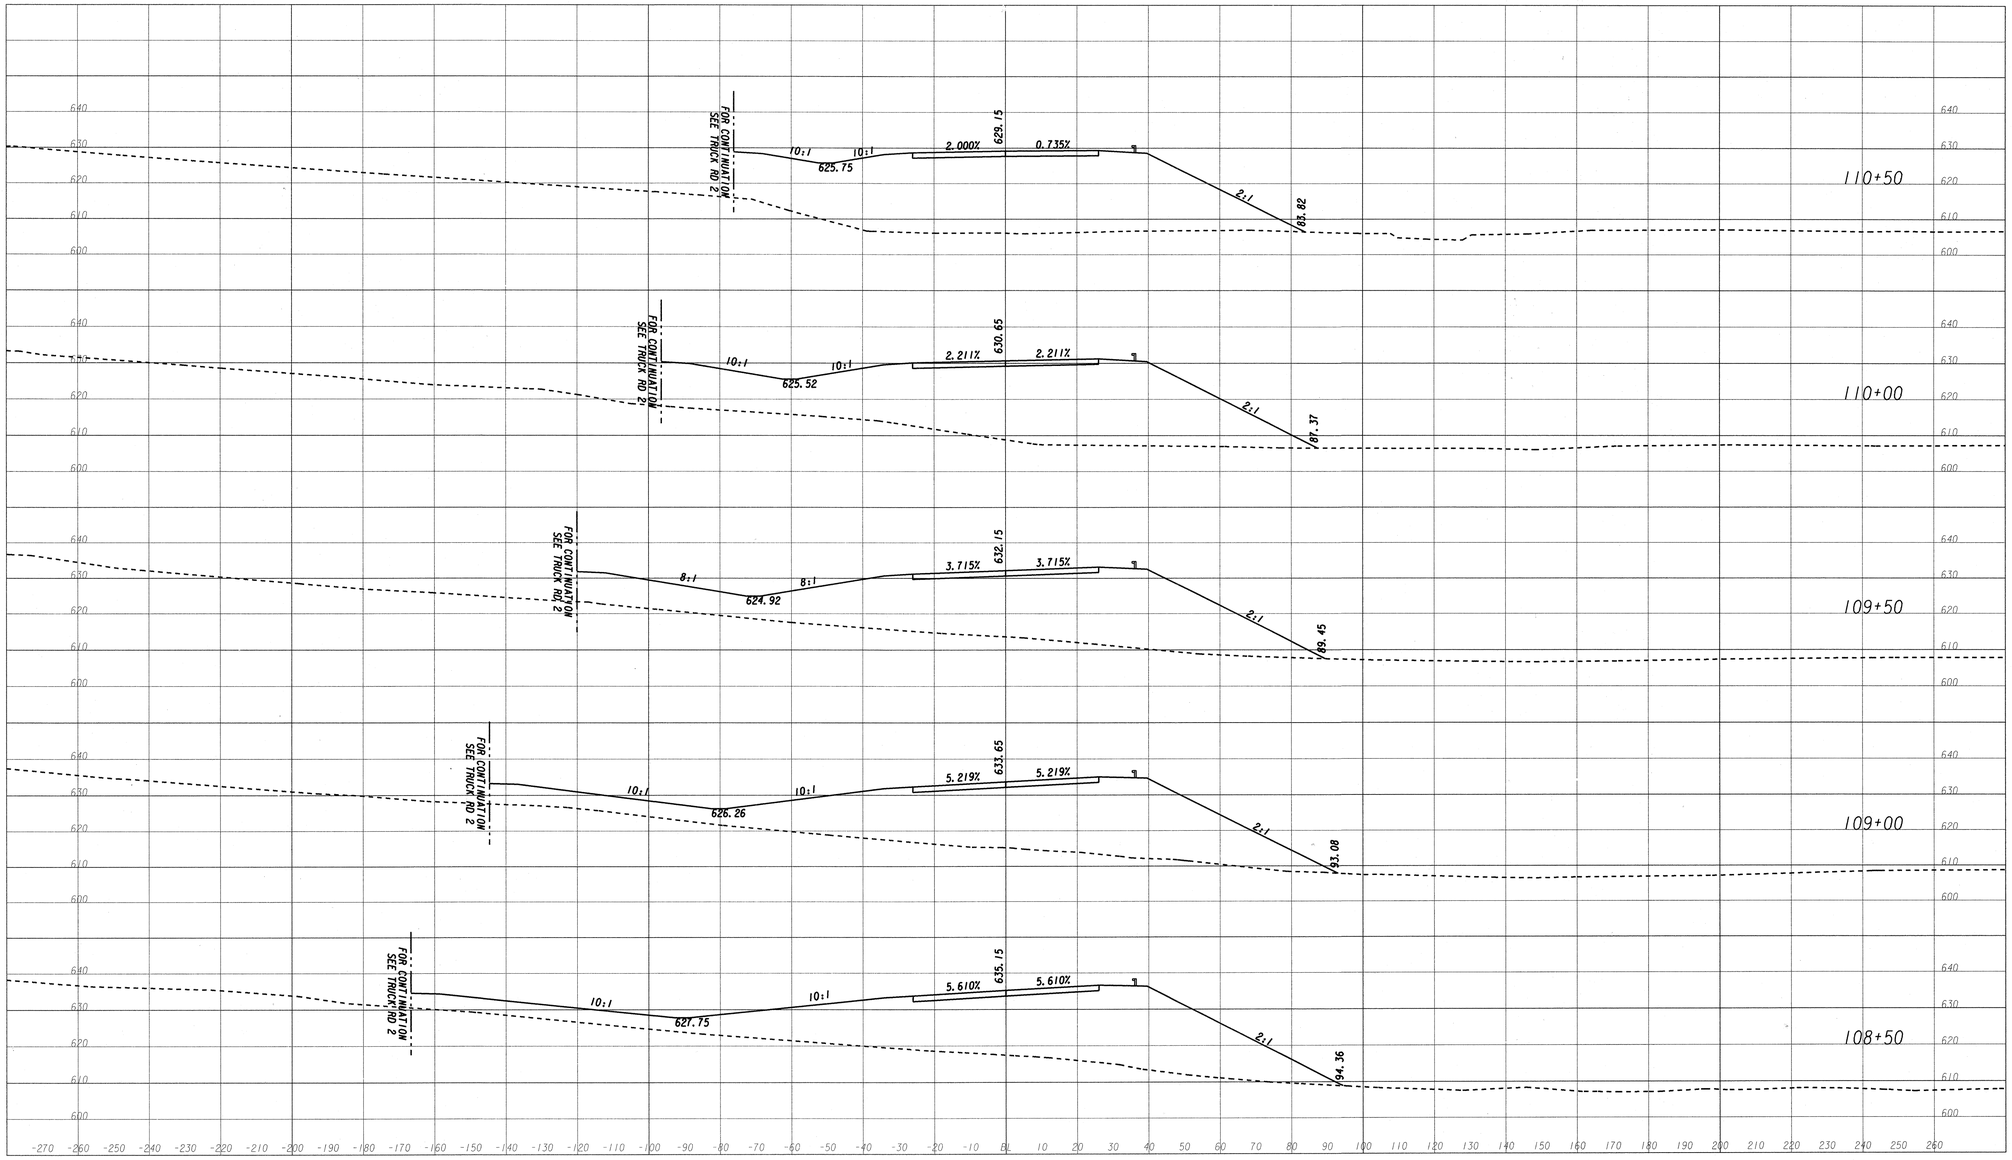

AS-BUILT

ARCADIS
Infrastructure, environment, facilities

SCALE: 1"=20' HORIZONTAL
1"=20' VERTICAL

REVISION DATES

STATE OF GEORGIA
DEPARTMENT OF TRANSPORTATION
OFFICE: URBAN DESIGN

EARTHWORK CROSS SECTIONS
TRUCK ROAD 2
I-85 INTERCHANGE
AT CR 98/GABBETTVILLE RD

DRAWING No. 23-33