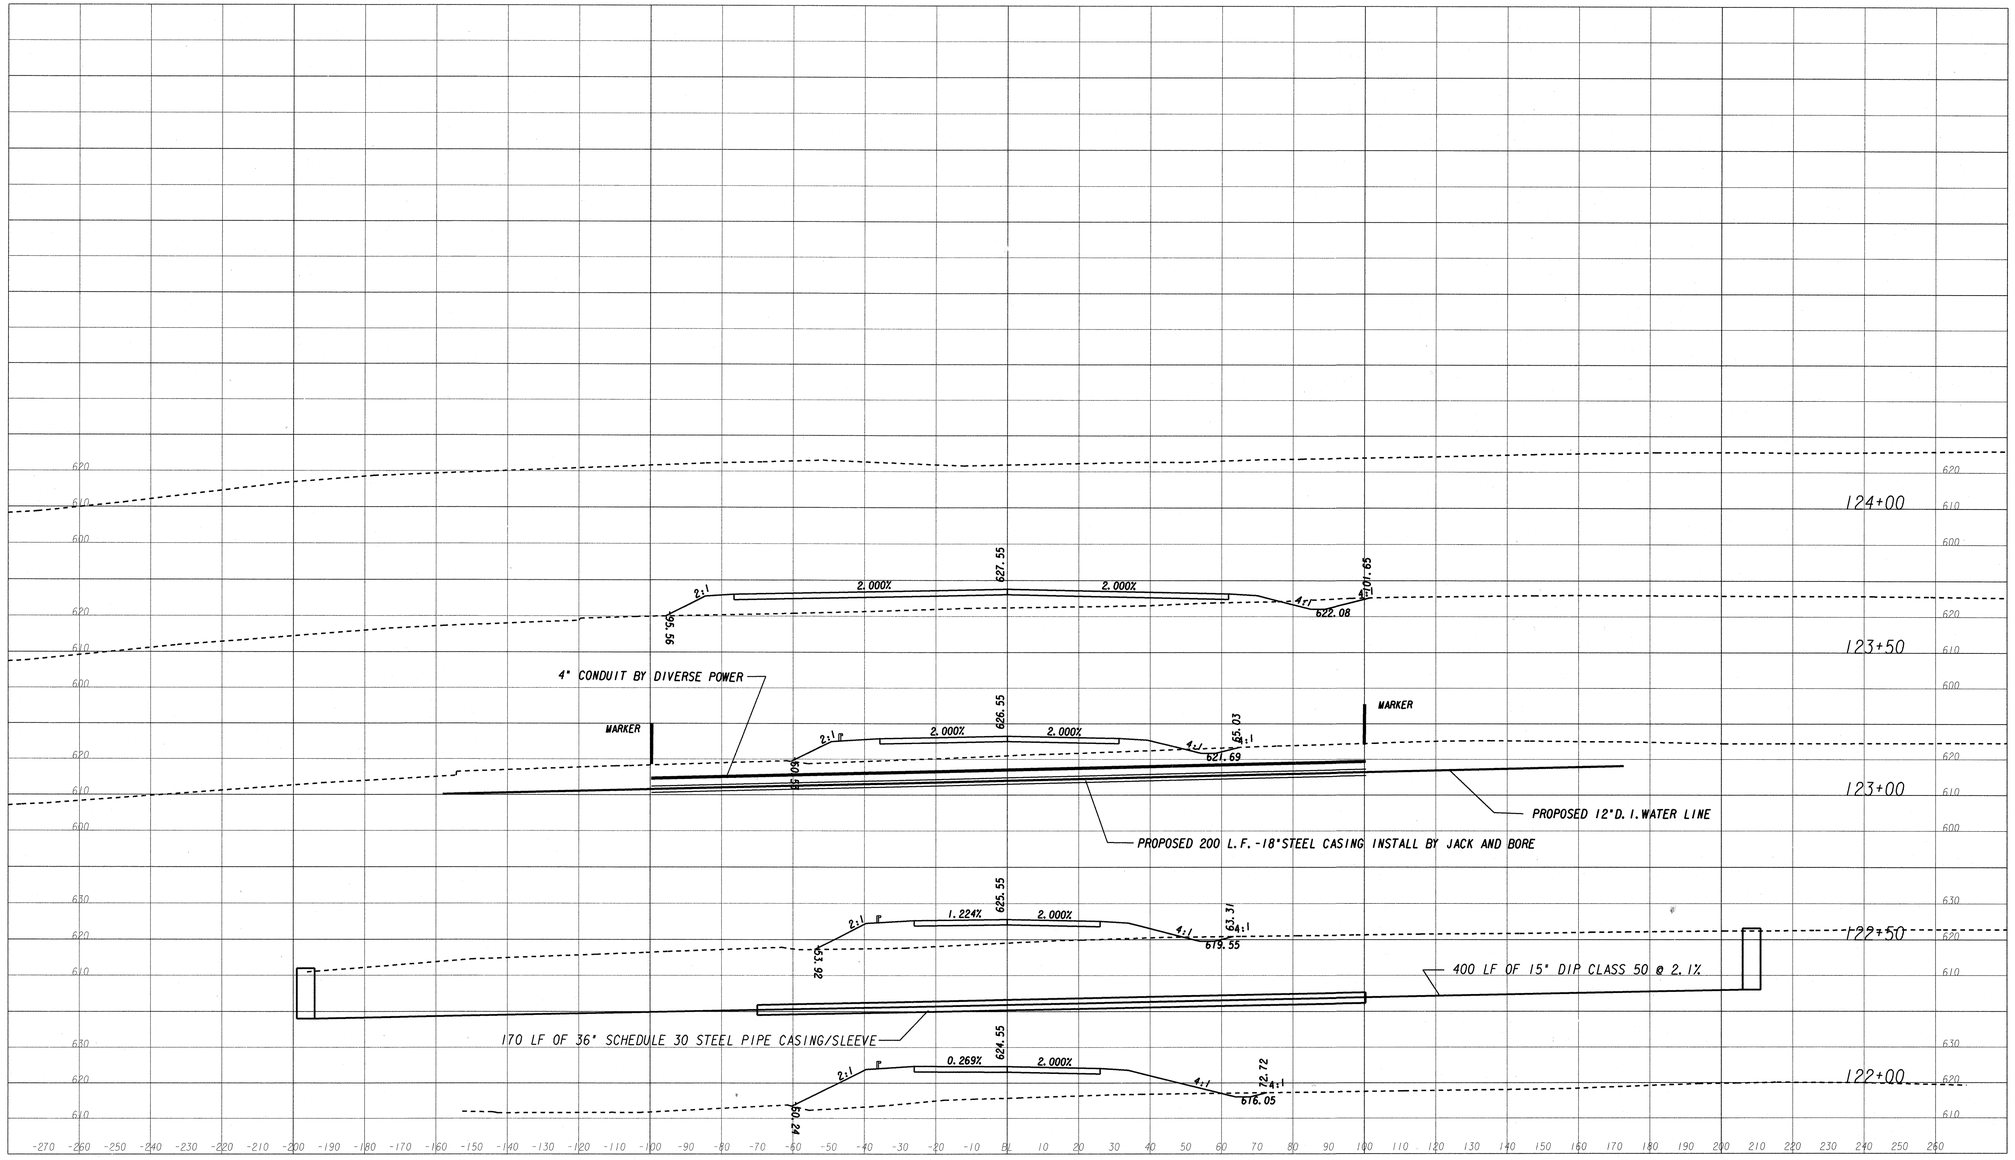

ARCADIS
Infrastructure, environment, facilities

SCALE: 1"=20' HORIZONTAL
1"=20' VERTICAL

REVISION DATES
09-18-07
09-28-07
01-03-08

STATE OF GEORGIA
DEPARTMENT OF TRANSPORTATION
OFFICE: URBAN DESIGN

EARTHWORK CROSS SECTIONS
TRUCK ROAD 2
I-85 INTERCHANGE
AT CR 98/GABBETTVILLE RD

DRAWING No. 23-37

AS-BUILT

PLAN DATE: 09-07-07