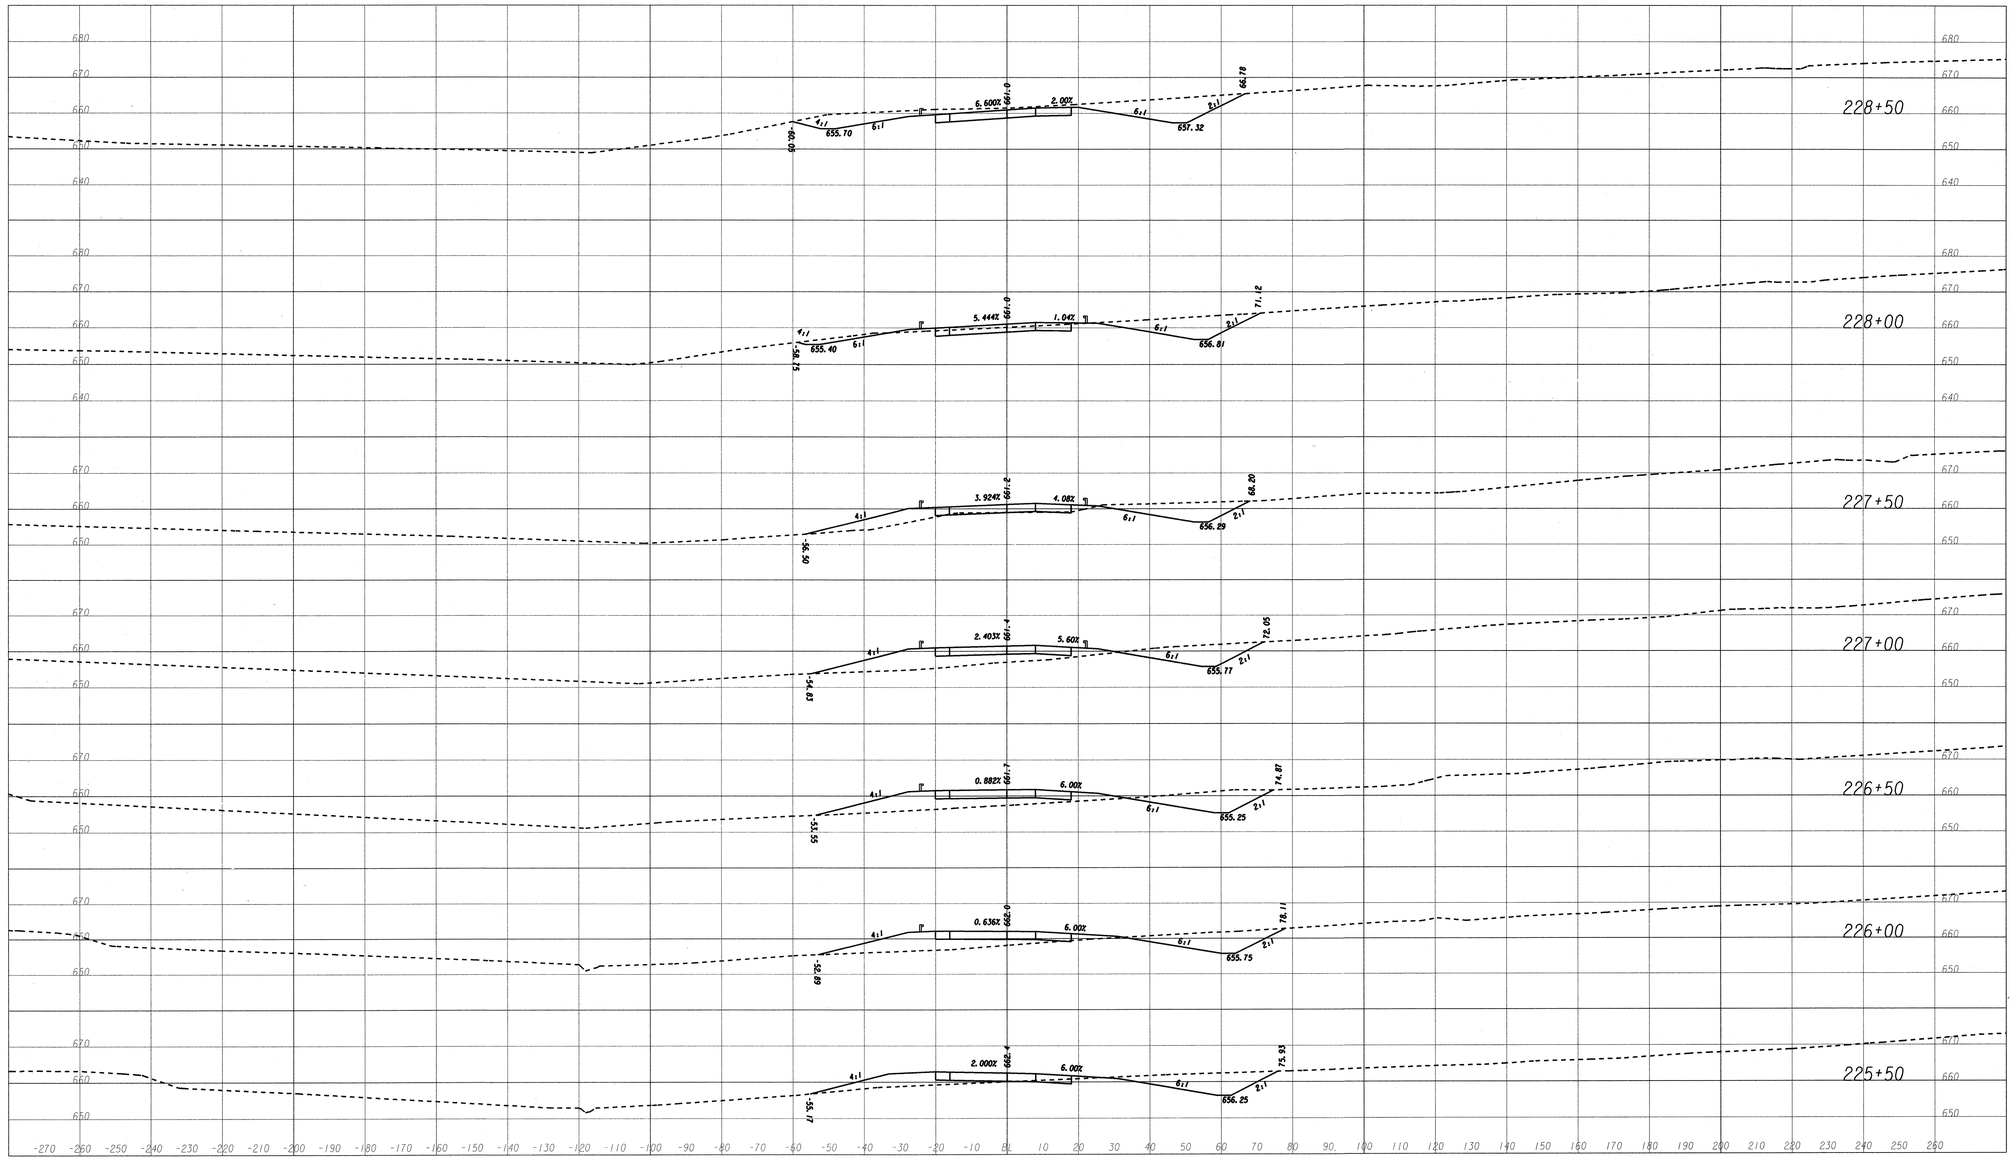


AS-BUILT

ARCADIS
Infrastructure, environment, facilities

SCALE: 1"=20' HORIZONTAL
1"=20' VERTICAL

| REVISION DATES | | |
|---|---|---|
| 04-09-08 | | |

STATE OF GEORGIA
DEPARTMENT OF TRANSPORTATION
OFFICE: URBAN DESIGN

# EARTHWORK CROSS SECTIONS
## RAMP A

I-85 INTERCHANGE
AT CR 98/GABBETTVILLE RD

DRAWING No. 23-135

GPLN