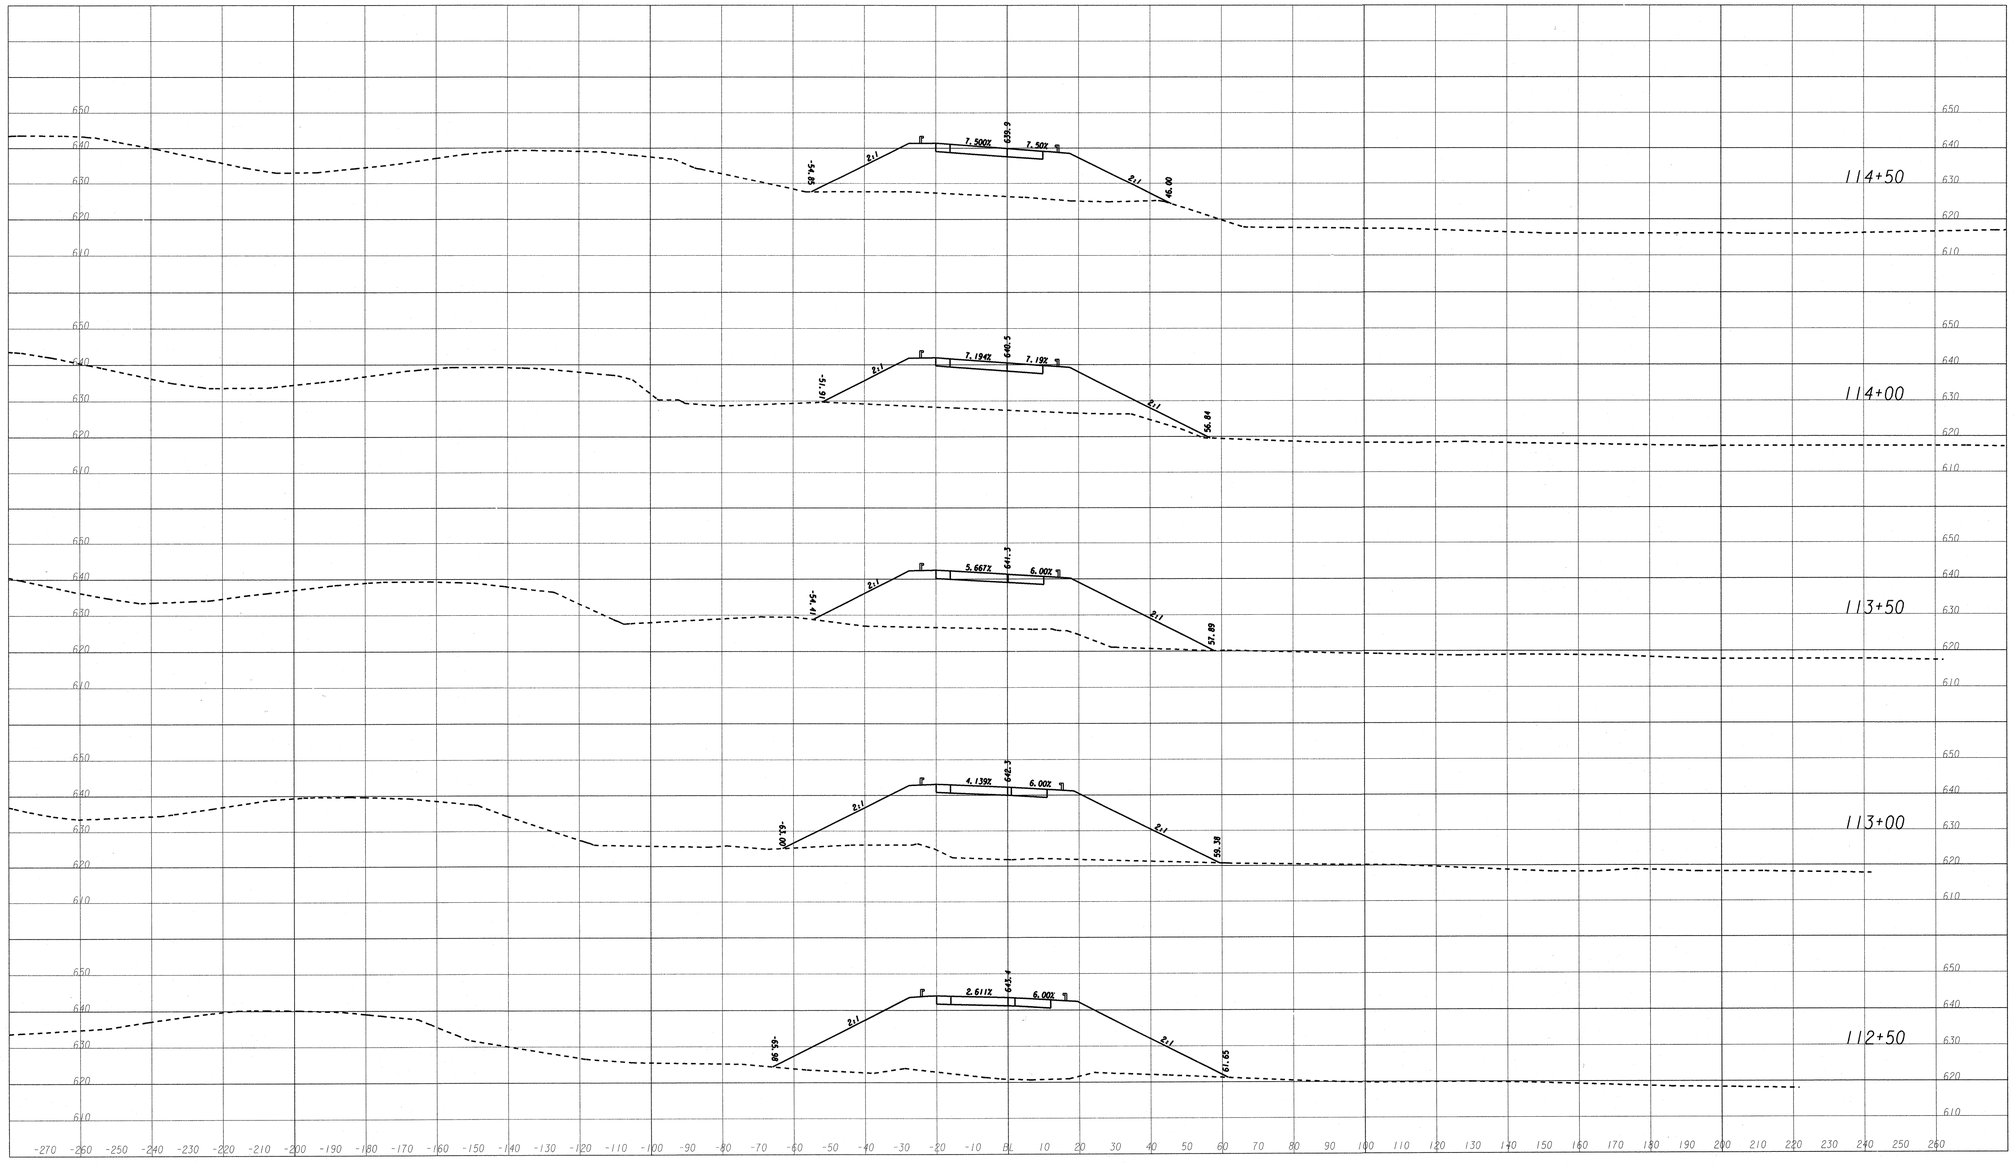

AS-BUILT

ARCADIS Infrastructure, environment, facilities	SCALE: 1"=20' HORIZONTAL 1"=20' VERTICAL	REVISION DATES 04-09-08	STATE OF GEORGIA DEPARTMENT OF TRANSPORTATION OFFICE: URBAN DESIGN **EARTHWORK CROSS SECTIONS RAMP B** I-85 INTERCHANGE AT CR 98/GABBETTVILLE RD DRAWING No. 23-145