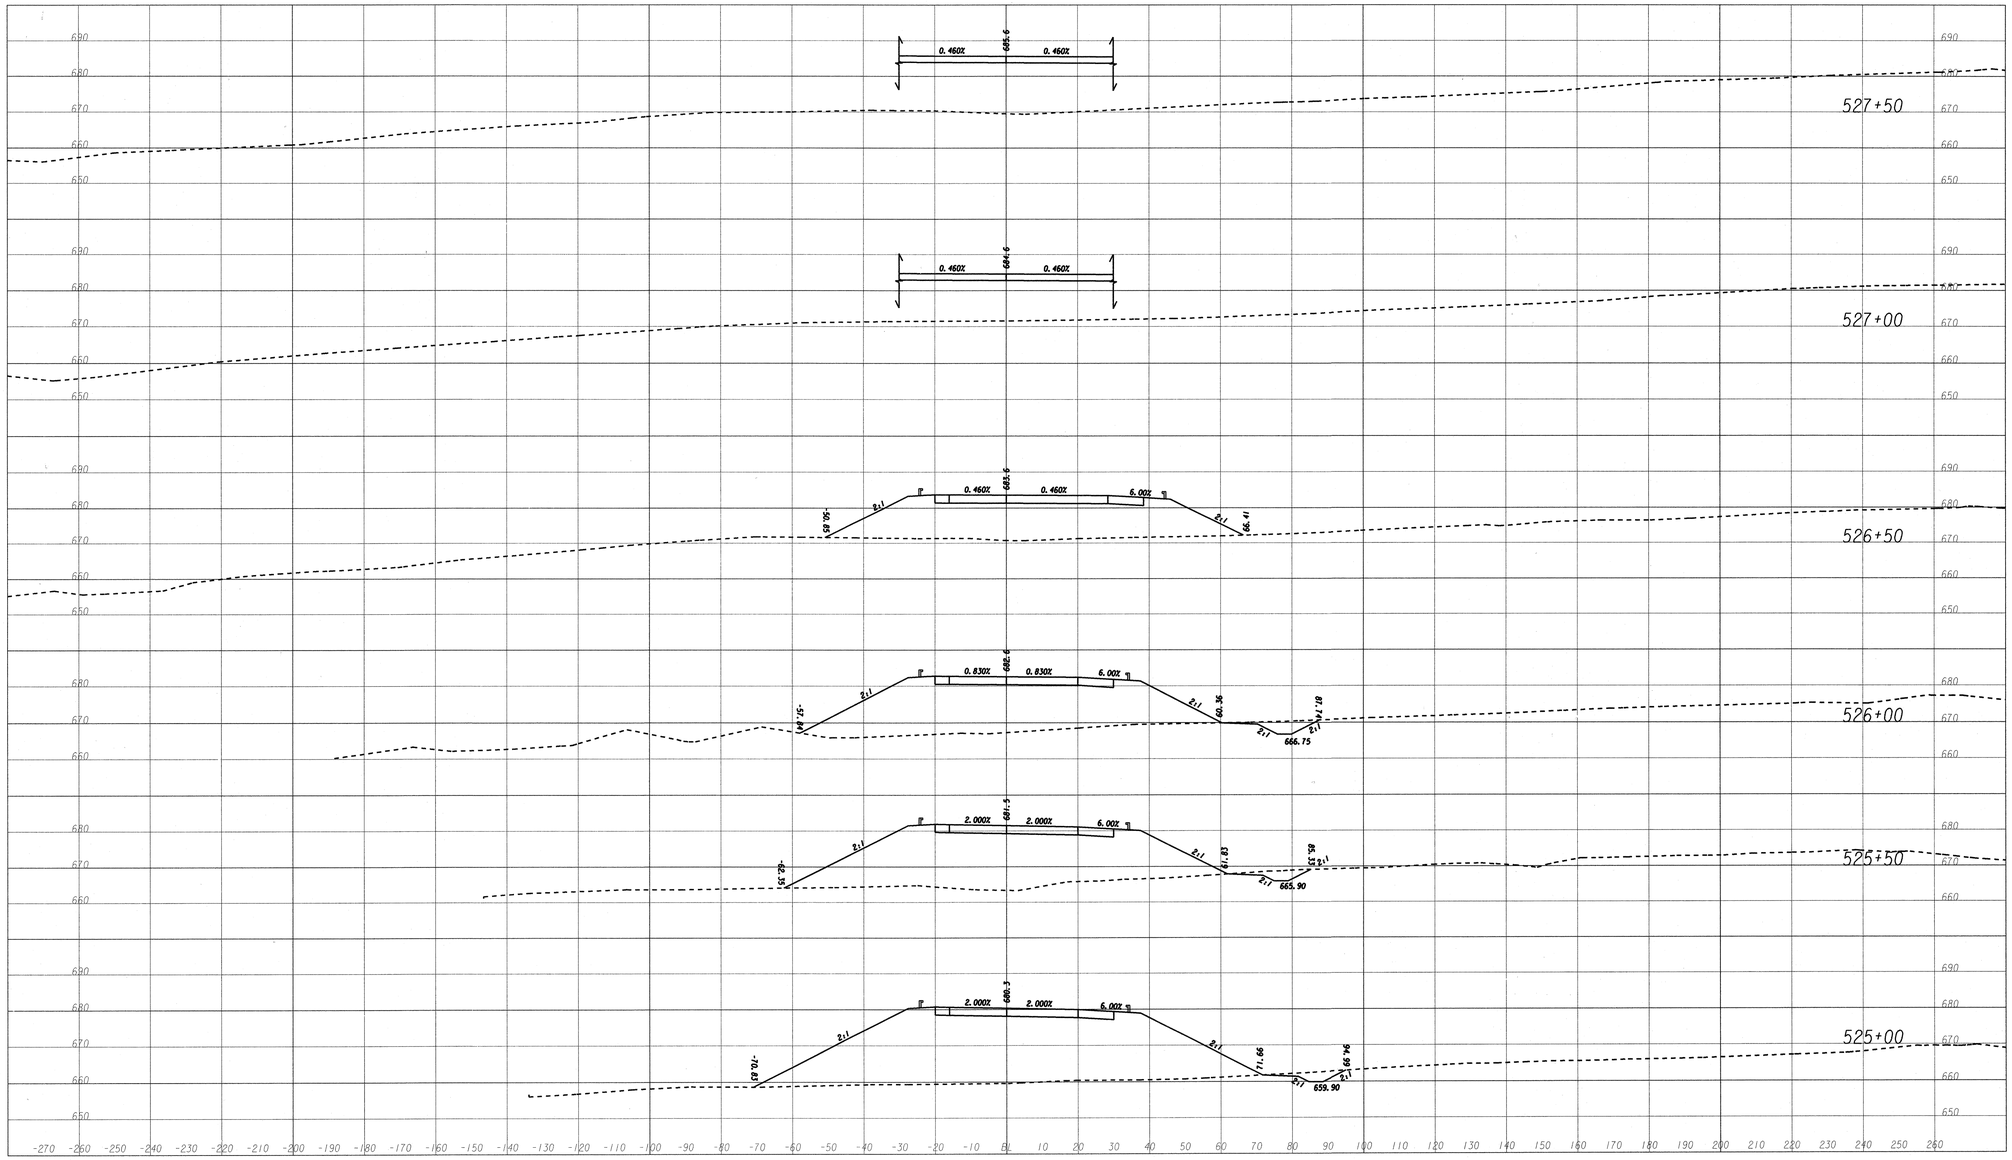

AS-BUILT

ARCADIS
Infrastructure, environment, facilities

SCALE: 1"=20' HORIZONTAL
1"=20' VERTICAL

REVISION DATES		
04-09-08		

STATE OF GEORGIA
DEPARTMENT OF TRANSPORTATION
OFFICE: URBAN DESIGN

EARTHWORK CROSS SECTIONS
RAMP D

I-85 INTERCHANGE
AT CR 98/GABBETTVILLE RD

DRAWING No. 23-163