12/19/2008 10:53:41 AM	63732-K1A	g:\tra\63732-kla\rdy\008232xs010.dgn	COUNTY	PROJECT NUMBER	SHEET NO.	TOTAL SHEETS
clanz	AGMENG.tbl		TROUP	CSNHS-0008-00(232)	365	839

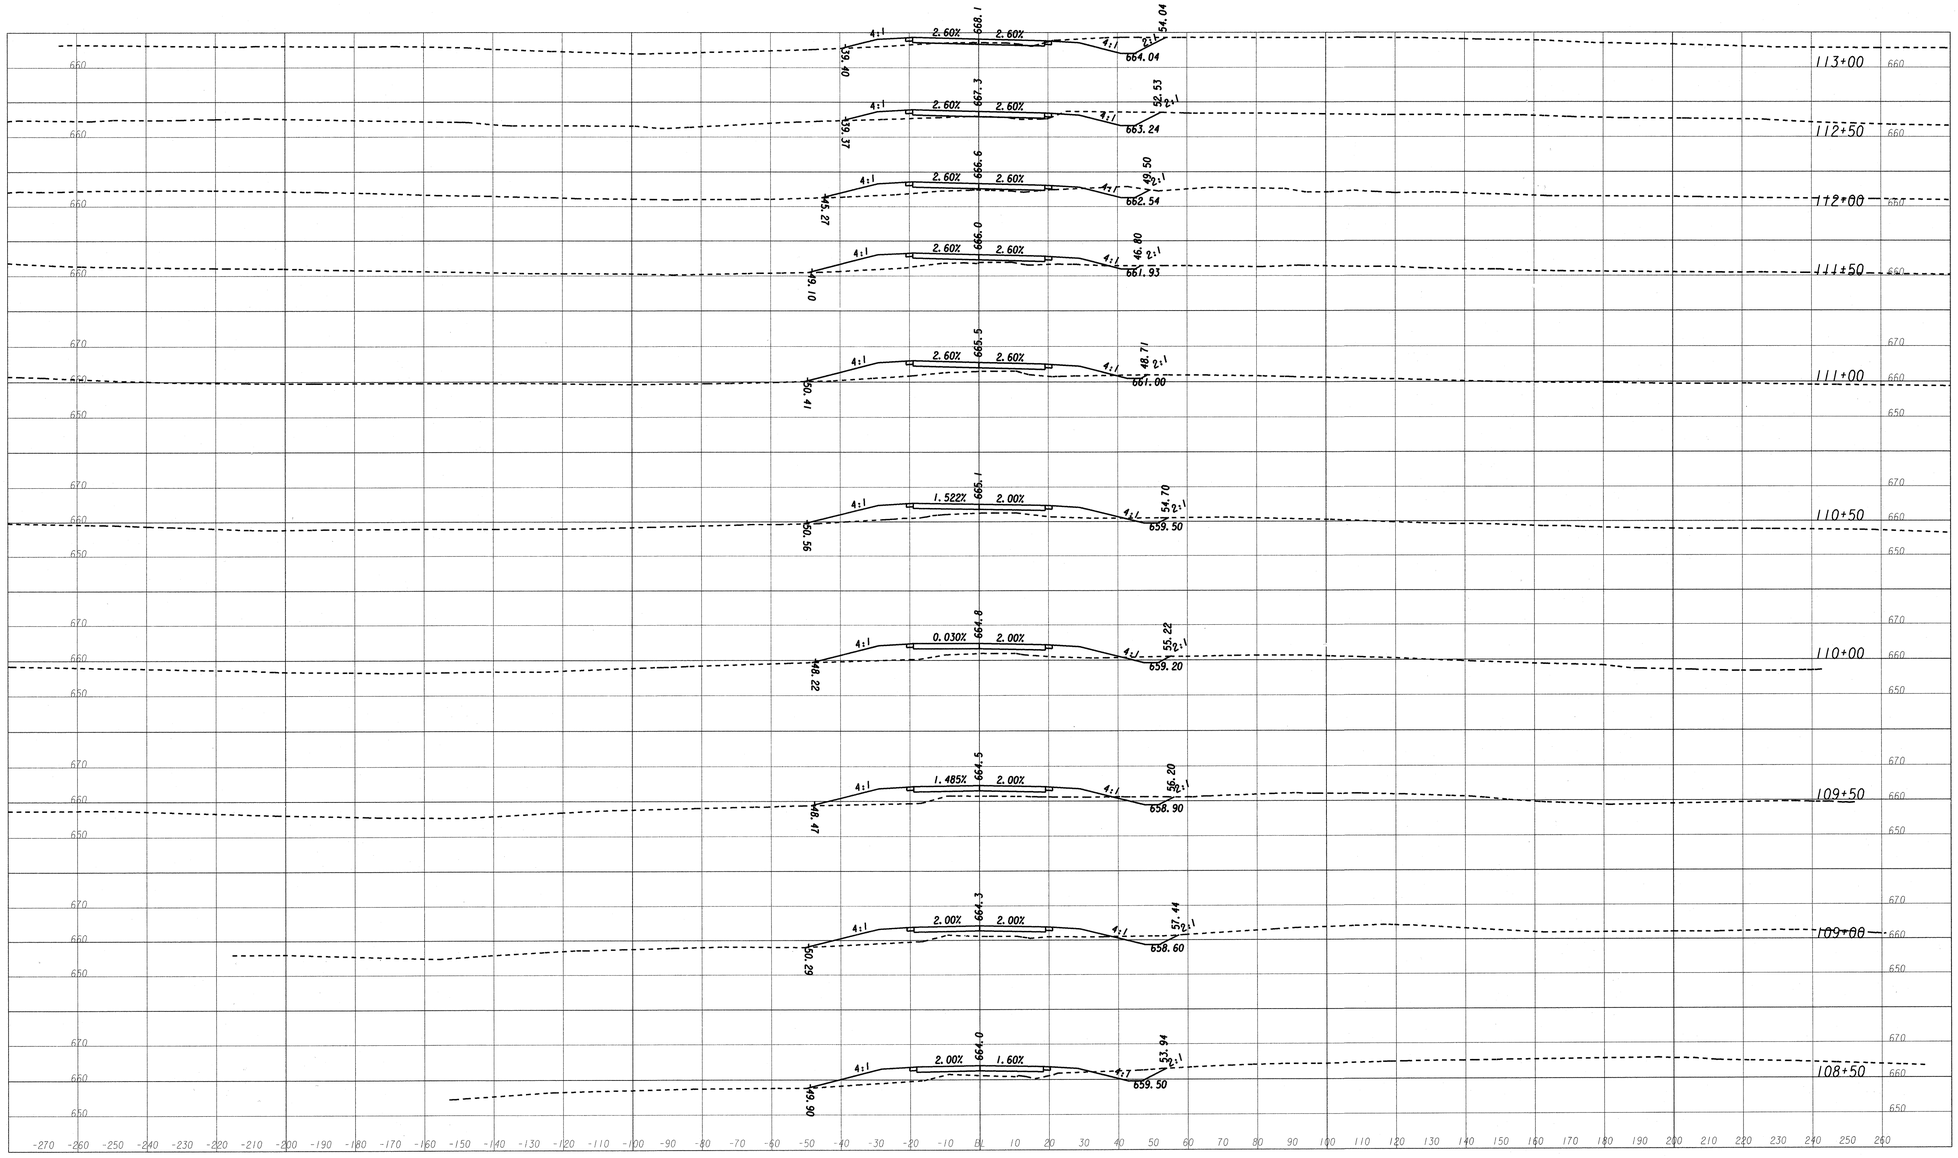

AS-BUILT

ARCADIS
Infrastructure, environment, facilities

SCALE: 1"=20' HORIZONTAL
1"=20' VERTICAL

REVISION DATES		

STATE OF GEORGIA
DEPARTMENT OF TRANSPORTATION

OFFICE: URBAN DESIGN

EARTHWORK CROSS SECTIONS
WARNER ROAD
I-85 INTERCHANGE
AT CR 98/GABBETTVILLE RD

DRAWING No. 23-201