12/19/2008 clanz	12:22:05 PM	63732-KIA AGMENG.tbl	G:\TRA\63732-KIA\rdy\0008232UT01.dgn	COUNTY	PROJECT NUMBER	SHEET NO.	TOTAL SHEETS
				TROUP	CSNHS-0008-00(232)	376	839

STATE OF GEORGIA
DEPARTMENT OF TRANSPORTATION

UTILITY PLANS
I-85 @ CR 98/KIA BOULEVARD
TROUP COUNTY

Proj. No. CSNHS-0008-00(232)
P. I. NO. 0008232

AS-BUILT

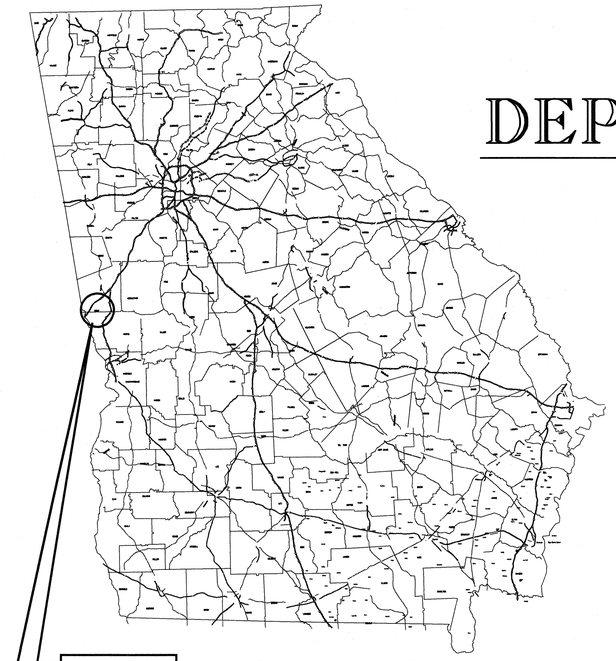

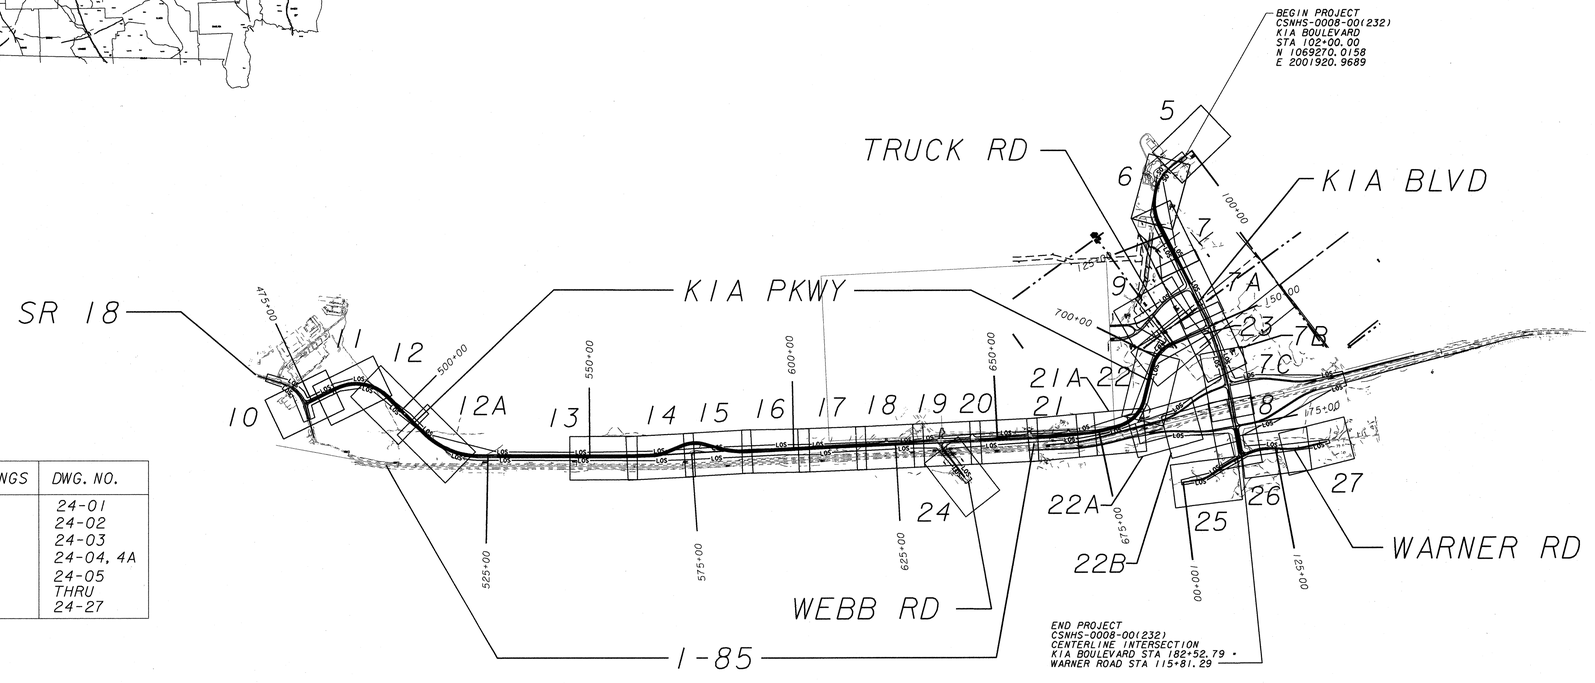

INDEX OF DRAWINGS	DWG. NO.
KEY MAP	24-01
GENERAL NOTES	24-02
LEGEND	24-03
POLE DATA	24-04, 4A
PLAN DRAWINGS	24-05 THRU 24-27

ARCADIS
Infrastructure, environment, facilities

REVISION DATES				
09-28-07				

STATE OF GEORGIA
DEPARTMENT OF TRANSPORTATION
OFFICE: URBAN DESIGN

UTILITY PLANS

I-85 INTERCHANGE
AT CR 98/GABBETTVILLE RD

DRAWING No. 24-01

PLAN DATE - 09-07-07