COUNTY	PROJECT NUMBER	SHEET NO.	TOTAL SHEETS
Troup	CSNHS-0008-00(232)	436	839

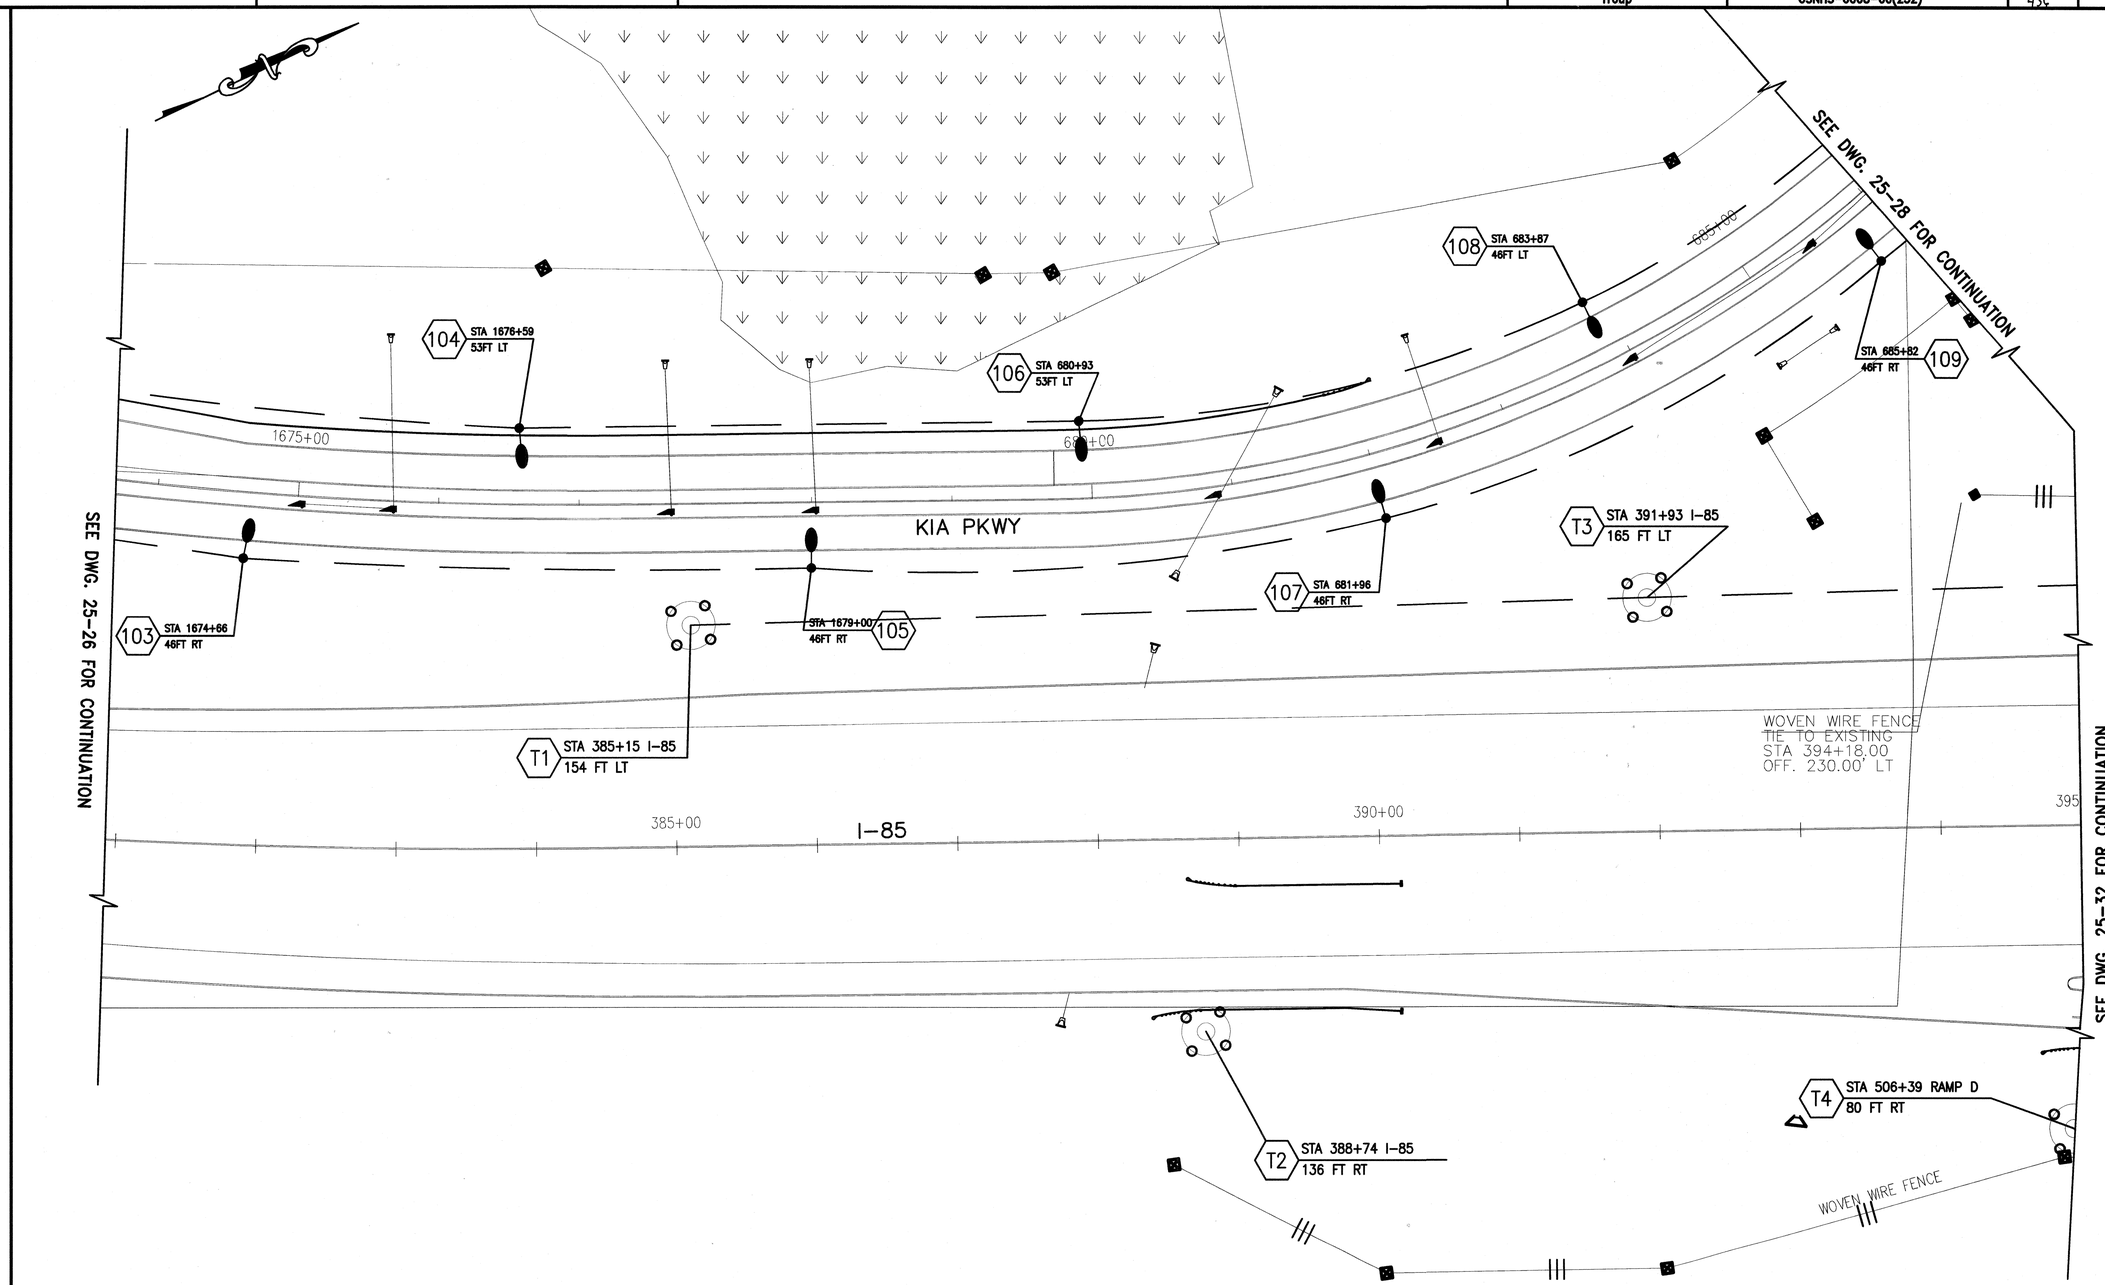

© 2007 ATLANTA CONSULTING ENGINEERS, INC. ALL RIGHTS RESERVED

THESE CONSTRUCTION DOCUMENTS AND PRINTED REPRODUCTIONS, IN WHOLE OR IN PART, ARE INSTRUMENTS OF SERVICE AND ARE THE SOLE PROPERTY OF ATLANTA CONSULTING ENGINEERS, INC. UNLESS OTHERWISE AGREED TO. THEY SHALL NOT BE REPRODUCED OR CONVEYED IN ANY MANNER NOR ARE THEY TO BE USED FOR ANY OTHER PROJECTS OTHER THAN THAT SPECIFICALLY INDICATED HEREIN WITHOUT WRITTEN PERMISSION PRIOR AND FULL COMPENSATION TO ATLANTA CONSULTING ENGINEERS, INC.

GPLN

ATLANTA CONSULTING ENGINEERS
500 SUN VALLEY DRIVE
UNIT G2
ROSWELL, GEORGIA 30076
bal@ace.idn.com
Tel: 678-205-2240
Fax: 678-205-2239

ARCADIS U.S., Inc.

GRAPHIC SCALE
50 0 25 50 100
(IN FEET)
1 inch = 50 ft.

REVISION DATES

STATE OF GEORGIA
DEPARTMENT OF TRANSPORTATION
Office of Urban Design

Lighting Layout

CSNHS-0008-00(232)
I-85 Interchange
CR 98/Gabbettville Road

DRAWING No.
25-27