12/12/2008 9:11:58 AM clanz	63761-Dekalb-Trail AGMENG.tbl	G:\Tra\63732-KIA\rdy\0082325M22.dgn	COUNTY	PROJECT NUMBER	SHEET NO.	TOTAL SHEETS
			TROUP	CSNHS-0008-00(232)	476	839

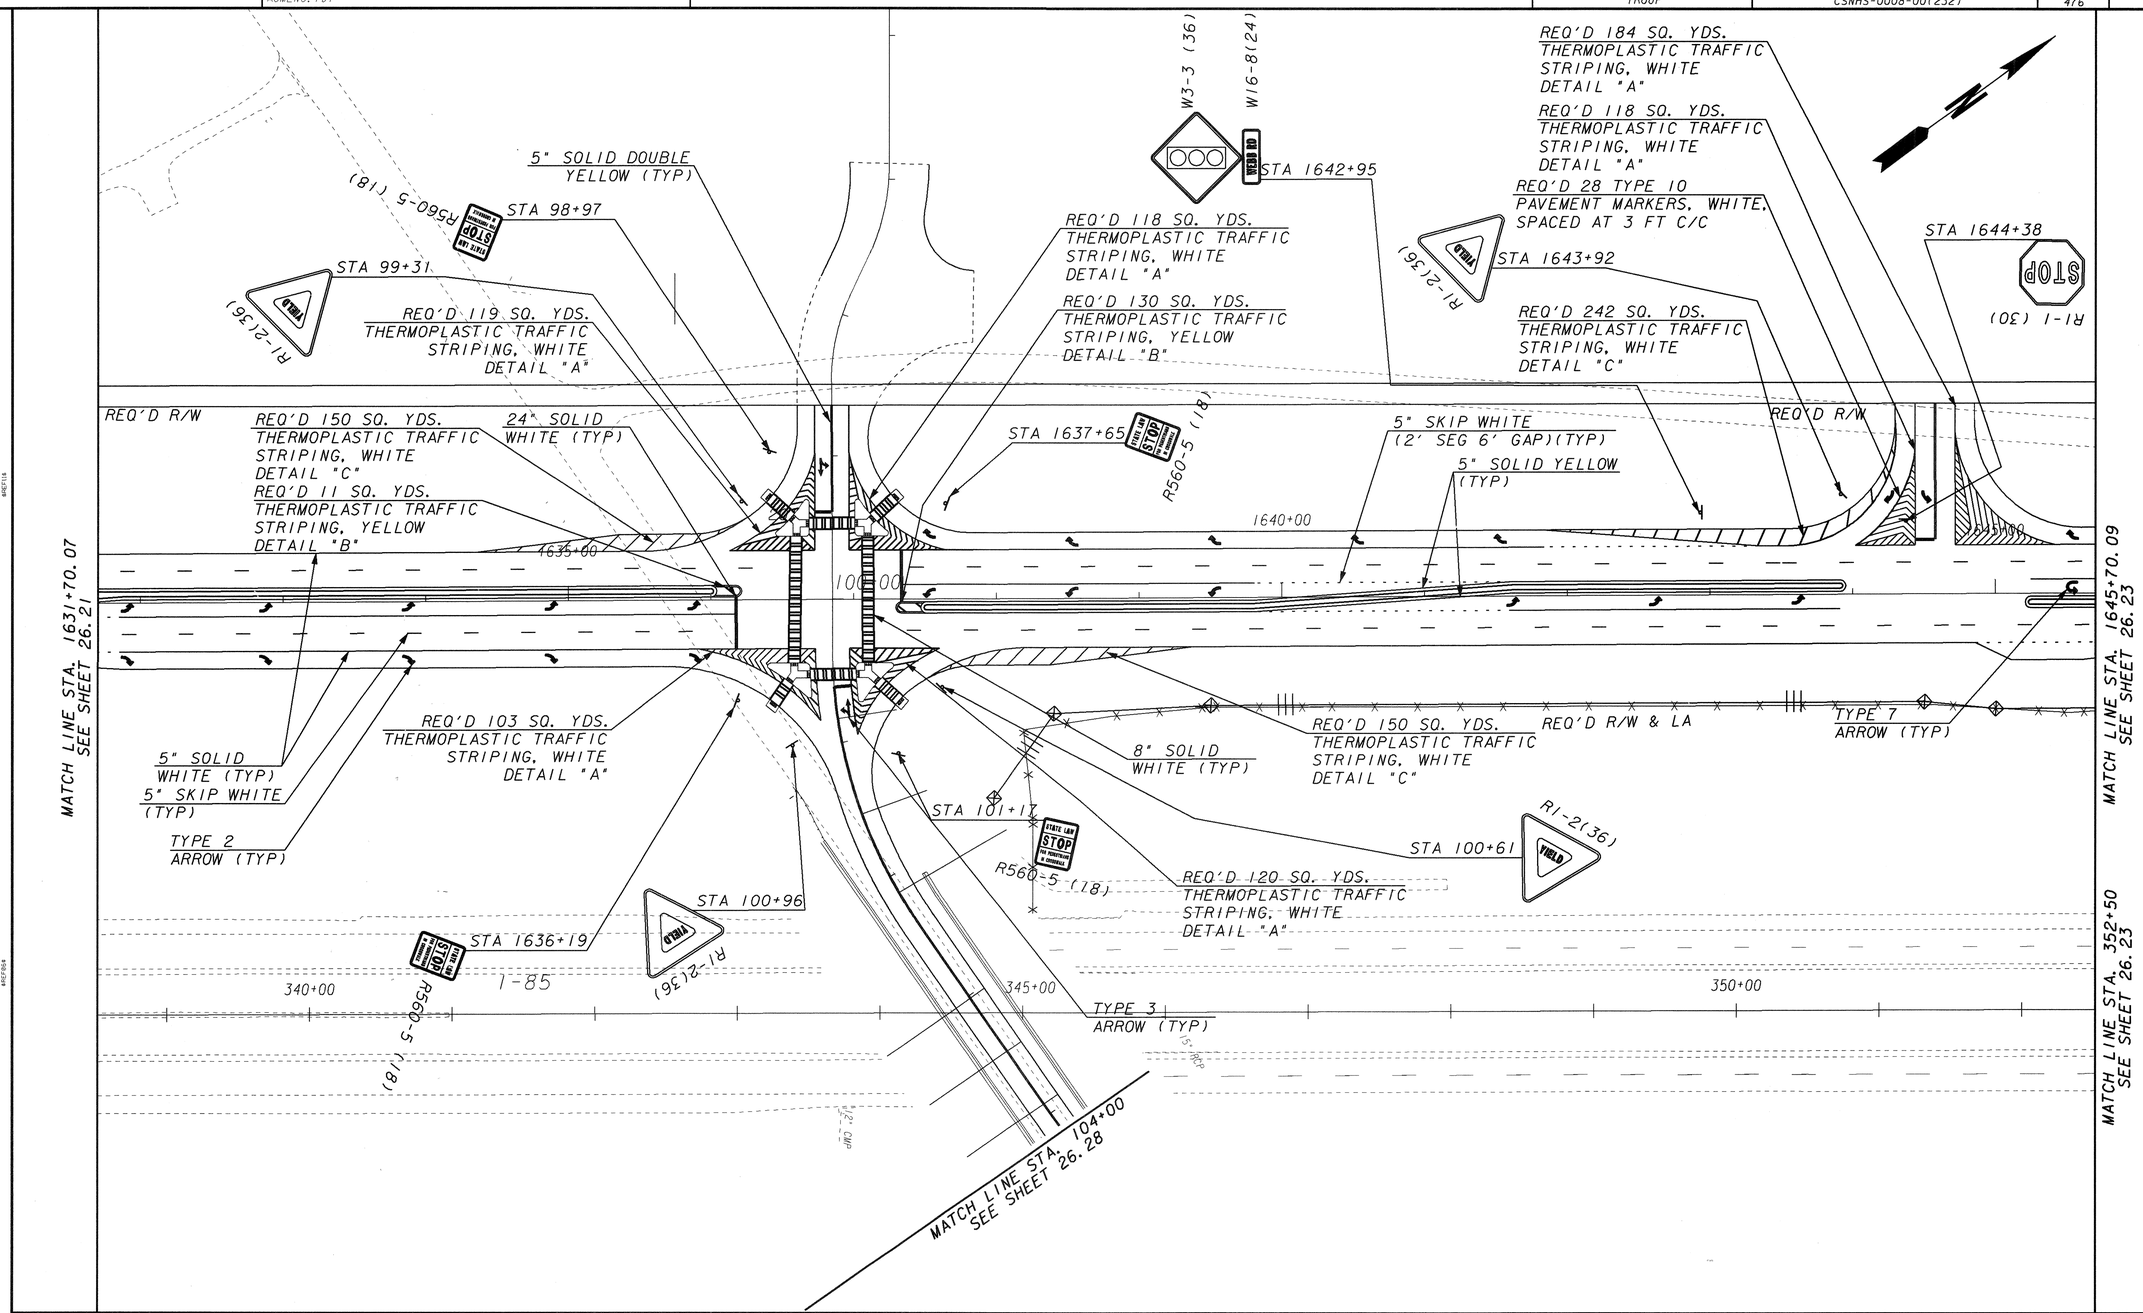

AS-BUILT

PLAN DATE: 09-07-07

ARCADIS
Infrastructure, environment, facilities

SCALE IN FEET
0 50 100 200

REVISION DATES		
12-12-08		

STATE OF GEORGIA
DEPARTMENT OF TRANSPORTATION
OFFICE: URBAN DESIGN

SIGNING AND MARKING PLANS

I-85 INTERCHANGE
AT CR 98/GABBETTVILLE RD

DRAWING No. 26-22