$DATE$	$TIME$	PRF	DGN	COUNTY	PROJECT NUMBER	SHEET NO.	TOTAL SHEETS
$USER$		$$PENTABLE$$		TROUP	CSNHS-0008-00(232)	513	839

PHASING DIAGRAM

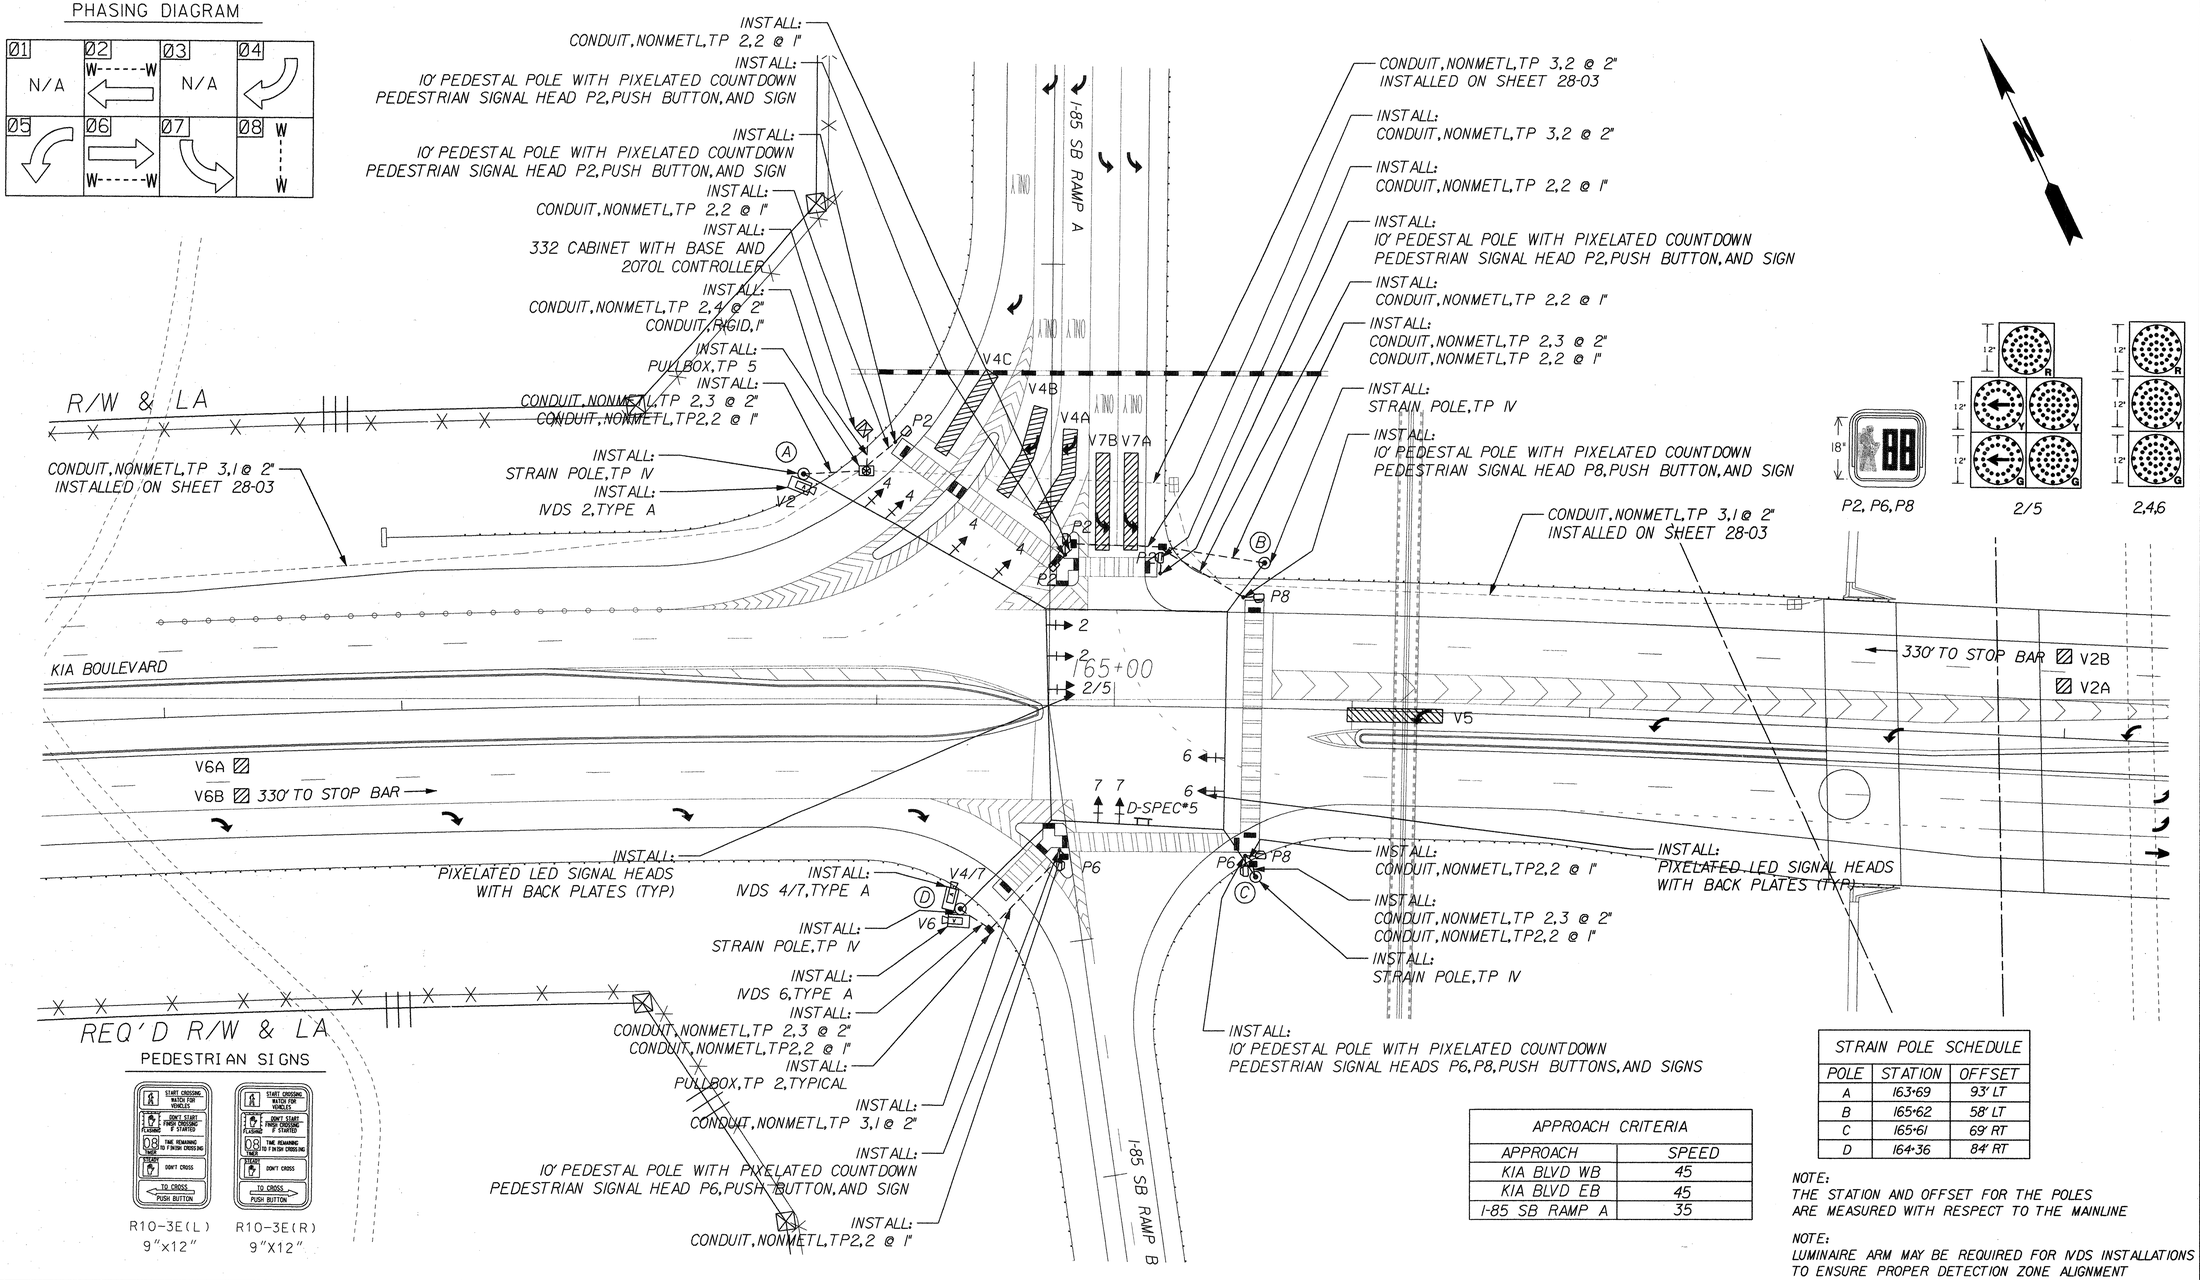

PEDESTRIAN SIGNS

R10-3E(L) 9"x12" R10-3E(R) 9"X12"

APPROACH CRITERIA	
APPROACH	SPEED
KIA BLVD WB	45
KIA BLVD EB	45
I-85 SB RAMP A	35

STRAIN POLE SCHEDULE		
POLE	STATION	OFFSET
A	163+69	93' LT
B	165+62	58' LT
C	165+61	69' RT
D	164+36	84' RT

NOTE:
THE STATION AND OFFSET FOR THE POLES ARE MEASURED WITH RESPECT TO THE MAINLINE

NOTE:
LUMINAIRE ARM MAY BE REQUIRED FOR IVDS INSTALLATIONS TO ENSURE PROPER DETECTION ZONE ALIGNMENT

AS-BUILT

ARCADIS
Infrastructure, environment, facilities

SCALE IN FEET
0 30 60 120

REVISION DATES

STATE OF GEORGIA
DEPARTMENT OF TRANSPORTATION
OFFICE: URBAN DESIGN

SIGNAL PLANS

TRAFFIC INSTALLATION #4
I-85 SOUTHBOUND RAMP
AT KIA BLVD

DRAWING No.
27-07

GPLN