$DATE$	$TIME$	PRF	DGN	COUNTY	PROJECT NUMBER	SHEET NO.	TOTAL SHEETS
$USER$		$$PENTABLE$$		TROUP	CSNHS-0008-00(232)	515	839

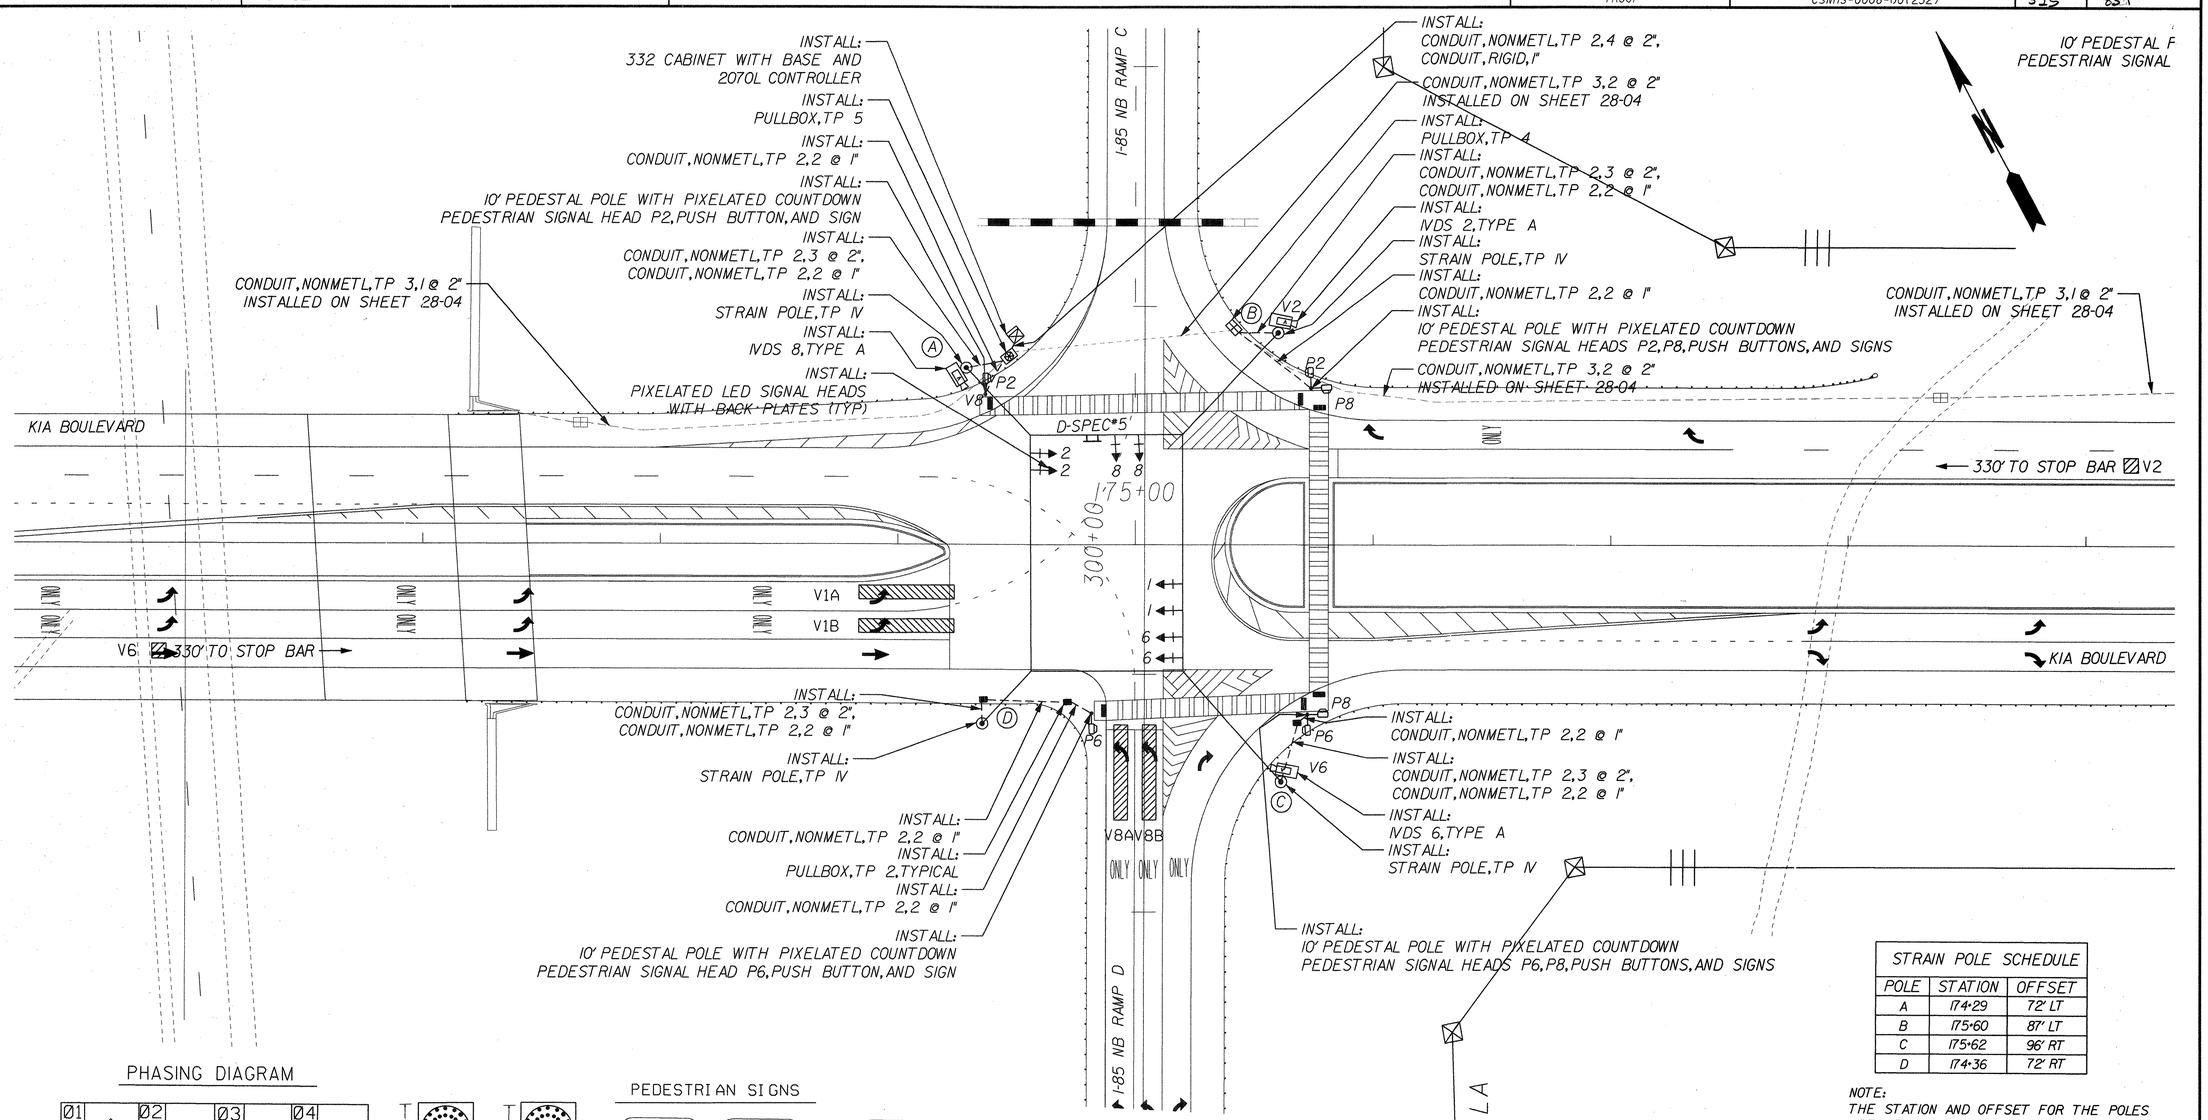

STRAIN POLE SCHEDULE		
POLE	STATION	OFFSET
A	174+29	72' LT
B	175+60	87' LT
C	175+62	96' RT
D	174+36	72' RT

NOTE:
THE STATION AND OFFSET FOR THE POLES
ARE MEASURED WITH RESPECT TO THE MAINLINE

PHASING DIAGRAM

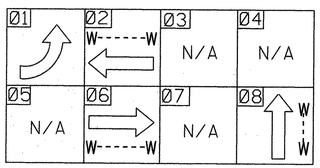

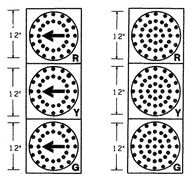

PEDESTRIAN SIGNS

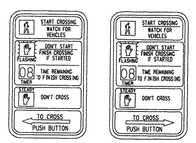

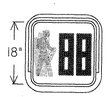

APPROACH CRITERIA	
APPROACH	SPEED
KIA BLVD WB	45
KIA BLVD EB	45
I-85 NB RAMP D	35

NOTE:
LUMINAIRE ARM MAY BE REQUIRED FOR IVDS INSTALLATIONS
TO ENSURE PROPER DETECTION ZONE ALIGNMENT

ARCADIS
Infrastructure, environment, facilities

SCALE IN FEET
0 30 60 120

REVISION DATES

STATE OF GEORGIA
DEPARTMENT OF TRANSPORTATION
OFFICE: URBAN DESIGN

SIGNAL PLANS

TRAFFIC INSTALLATION #5
I-85 NORTHBOUND RAMP
AT KIA BLVD

DRAWING No. **27-09**

AS-BUILT

GPLN