$DATE$	$TIME$	PRF	DGN	COUNTY	PROJECT NUMBER	SHEET NO.	TOTAL SHEETS
$USER$		$$PENTABLE$$		TROUP	CSNHS-0008-00(232)	527	839

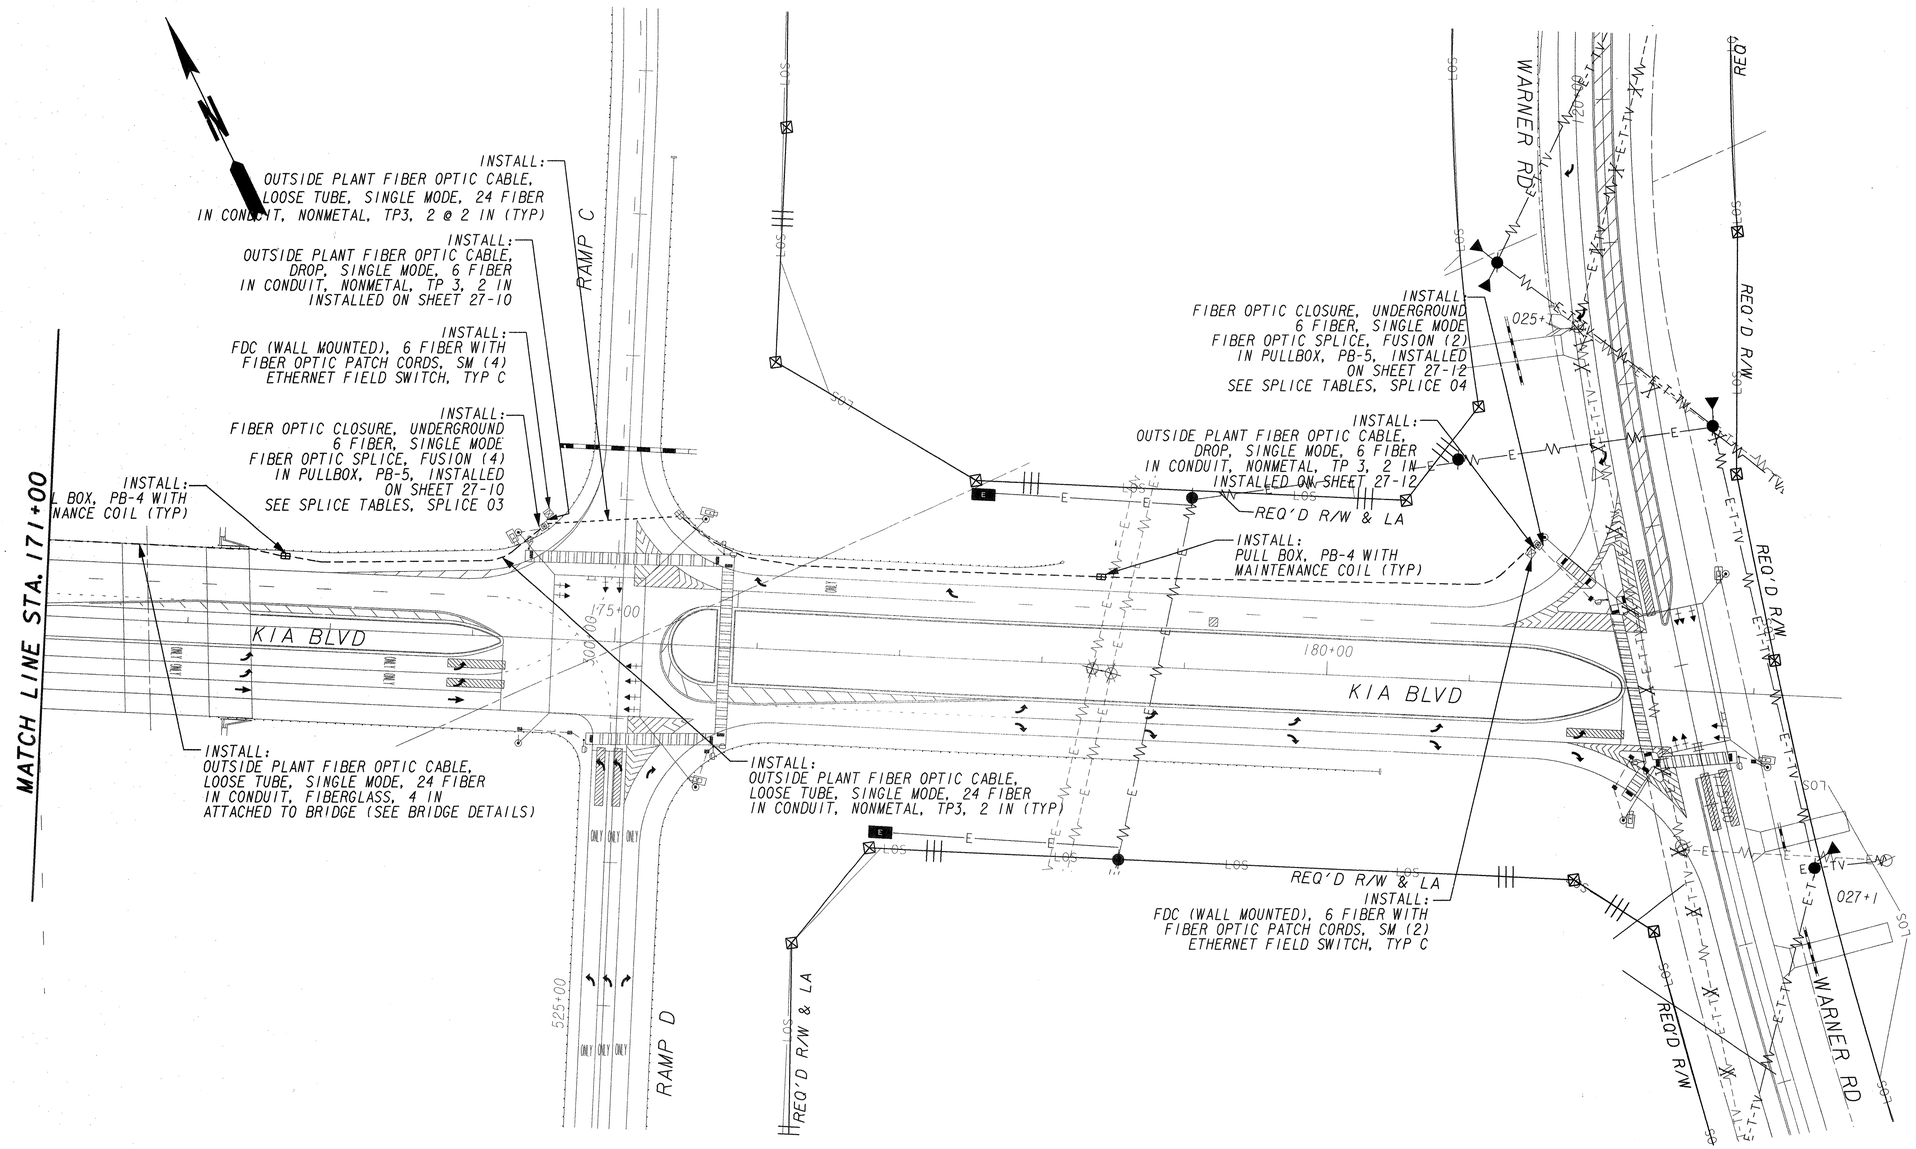

AS-BUILT

ARCADIS
Infrastructure, environment, facilities

SCALE IN FEET
0 50 100 200

REVISION DATES

STATE OF GEORGIA
DEPARTMENT OF TRANSPORTATION
OFFICE: URBAN DESIGN

ATMS PLANS

I-85 INTERCHANGE
AT CR 98/GABBETTVILLE RD

DRAWING No.
28-04