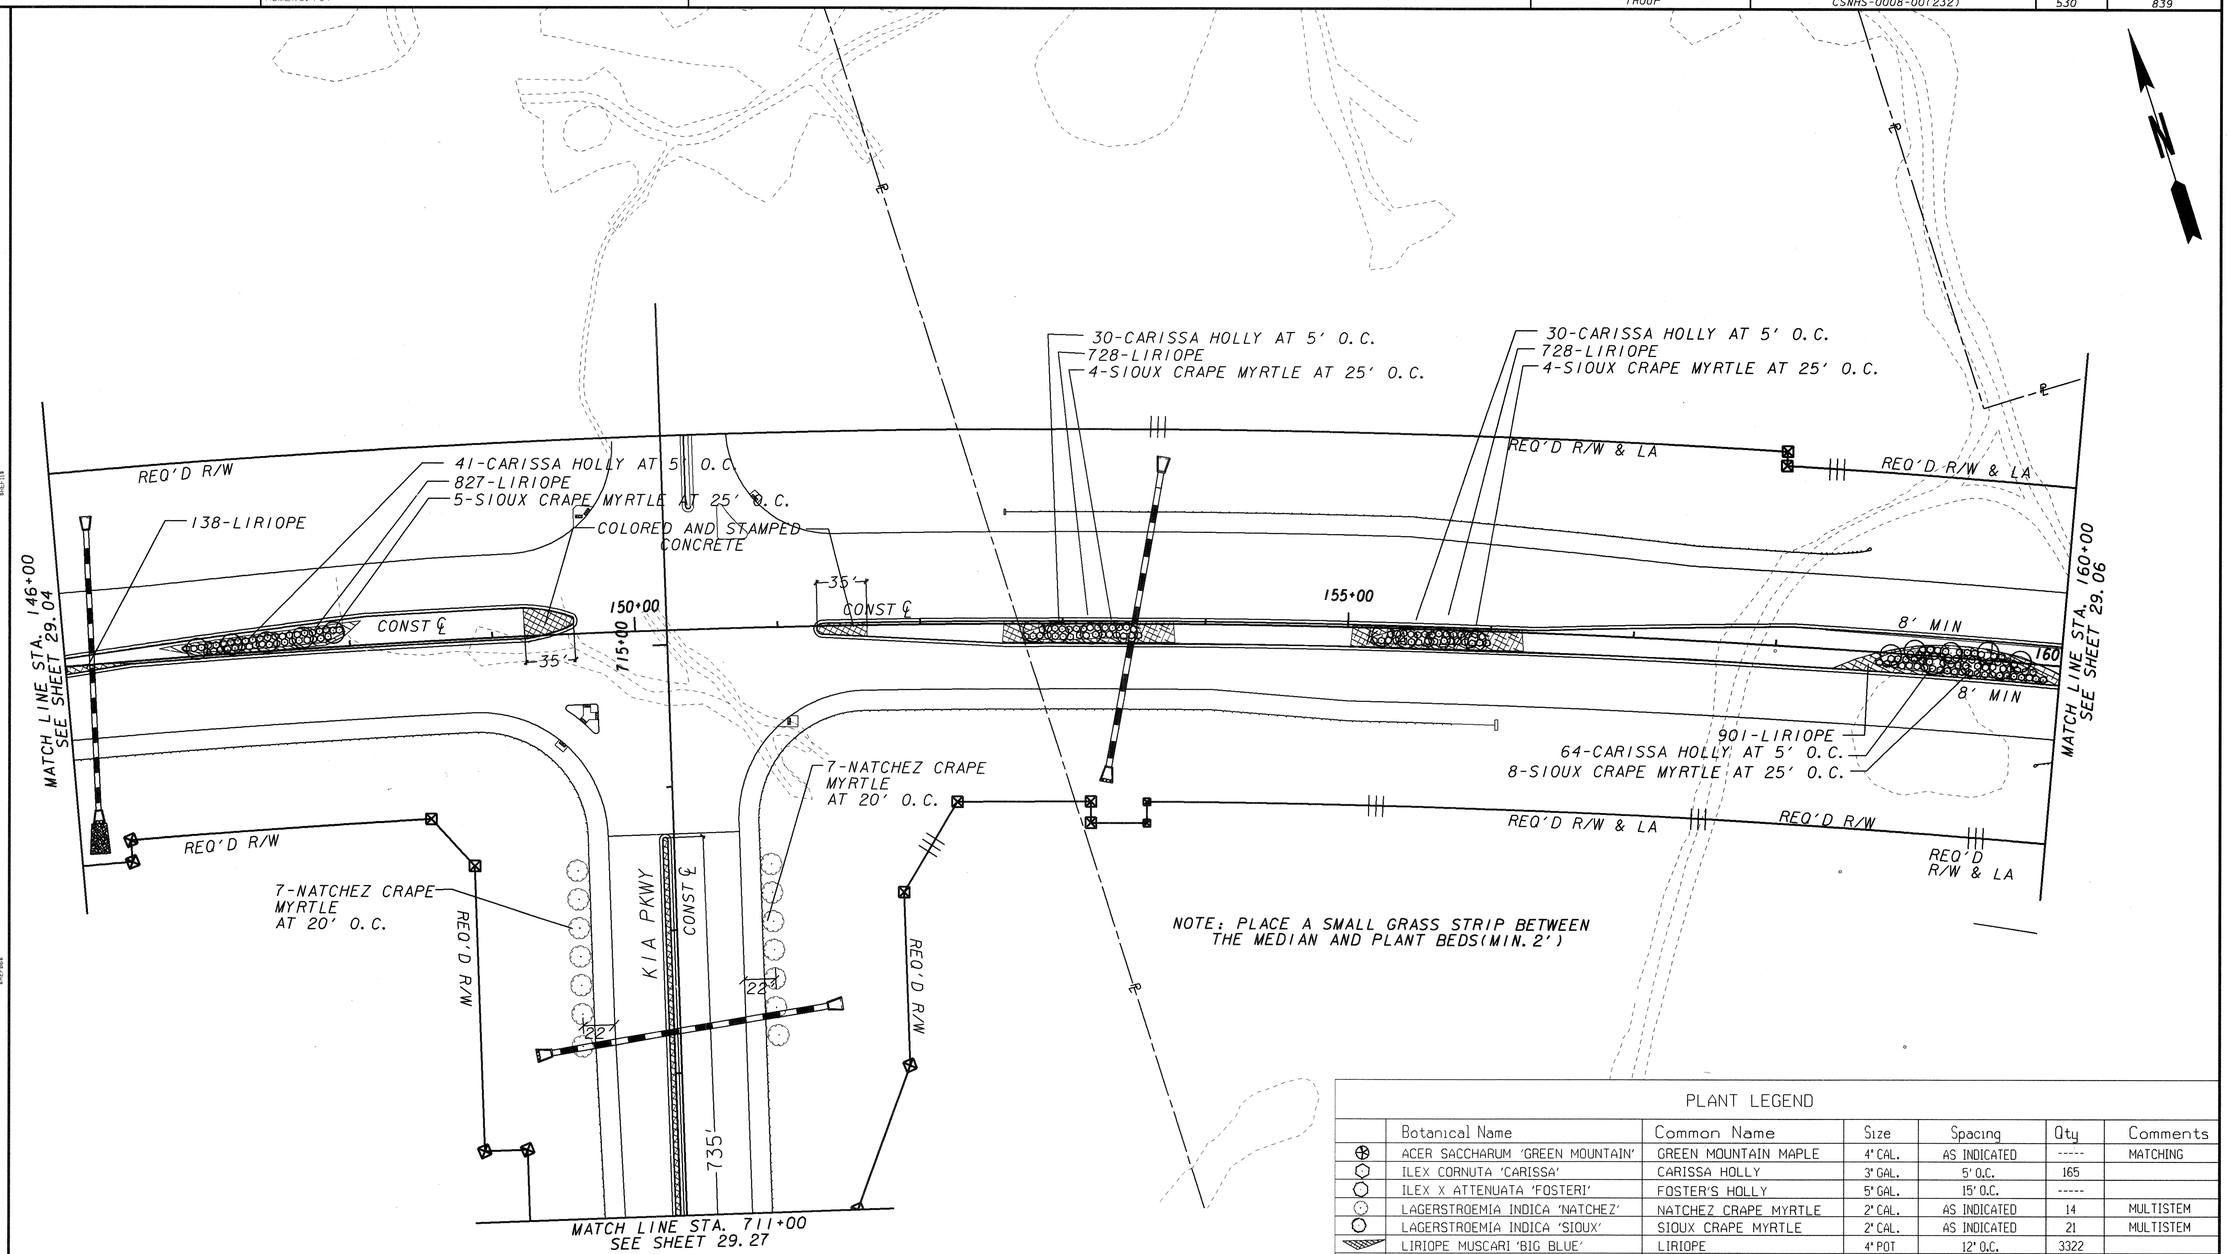

PLANT LEGEND

	Botanical Name	Common Name	Size	Spacing	Qty	Comments
	ACER SACCHARUM 'GREEN MOUNTAIN'	GREEN MOUNTAIN MAPLE	4" CAL.	AS INDICATED	-----	MATCHING
	ILEX CORNUTA 'CARISSA'	CARISSA HOLLY	3' GAL.	5' O.C.	165	
	ILEX X ATTENUATA 'FOSTERI'	FOSTER'S HOLLY	5' GAL.	15' O.C.	-----	
	LAGERSTROEMIA INDICA 'NATCHEZ'	NATCHEZ CRAPE MYRTLE	2" CAL.	AS INDICATED	14	MULTISTEM
	LAGERSTROEMIA INDICA 'SIOUX'	SIOUX CRAPE MYRTLE	2" CAL.	AS INDICATED	21	MULTISTEM
	LIRIOPE MUSCARI 'BIG BLUE'	LIRIOPE	4" POT	12" O.C.	3322	
	PRUNUS X YEDOENSIS	YOSHINO CHERRY	2" CAL.	25' O.C.	-----	MATCHING
	QUERCUS NUTALLII	NUTTALL OAK	4" CAL.	AS INDICATED	-----	MATCHING
	QUERCUS PHELLOS	WILLOW OAK	4" CAL.	AS INDICATED	-----	MATCHING

ARCADIS
Infrastructure, environment, facilities

SCALE IN FEET
0 50 100 200

REVISION DATES
04-09-08
08-27-08

STATE OF GEORGIA
DEPARTMENT OF TRANSPORTATION
OFFICE: URBAN DESIGN

LANDSCAPING PLANS

I-85 INTERCHANGE
AT CR 98/GABBETTVILLE RD

DRAWING No. 29-05

AS-BUILT

PLAN DATE: 09-07-07