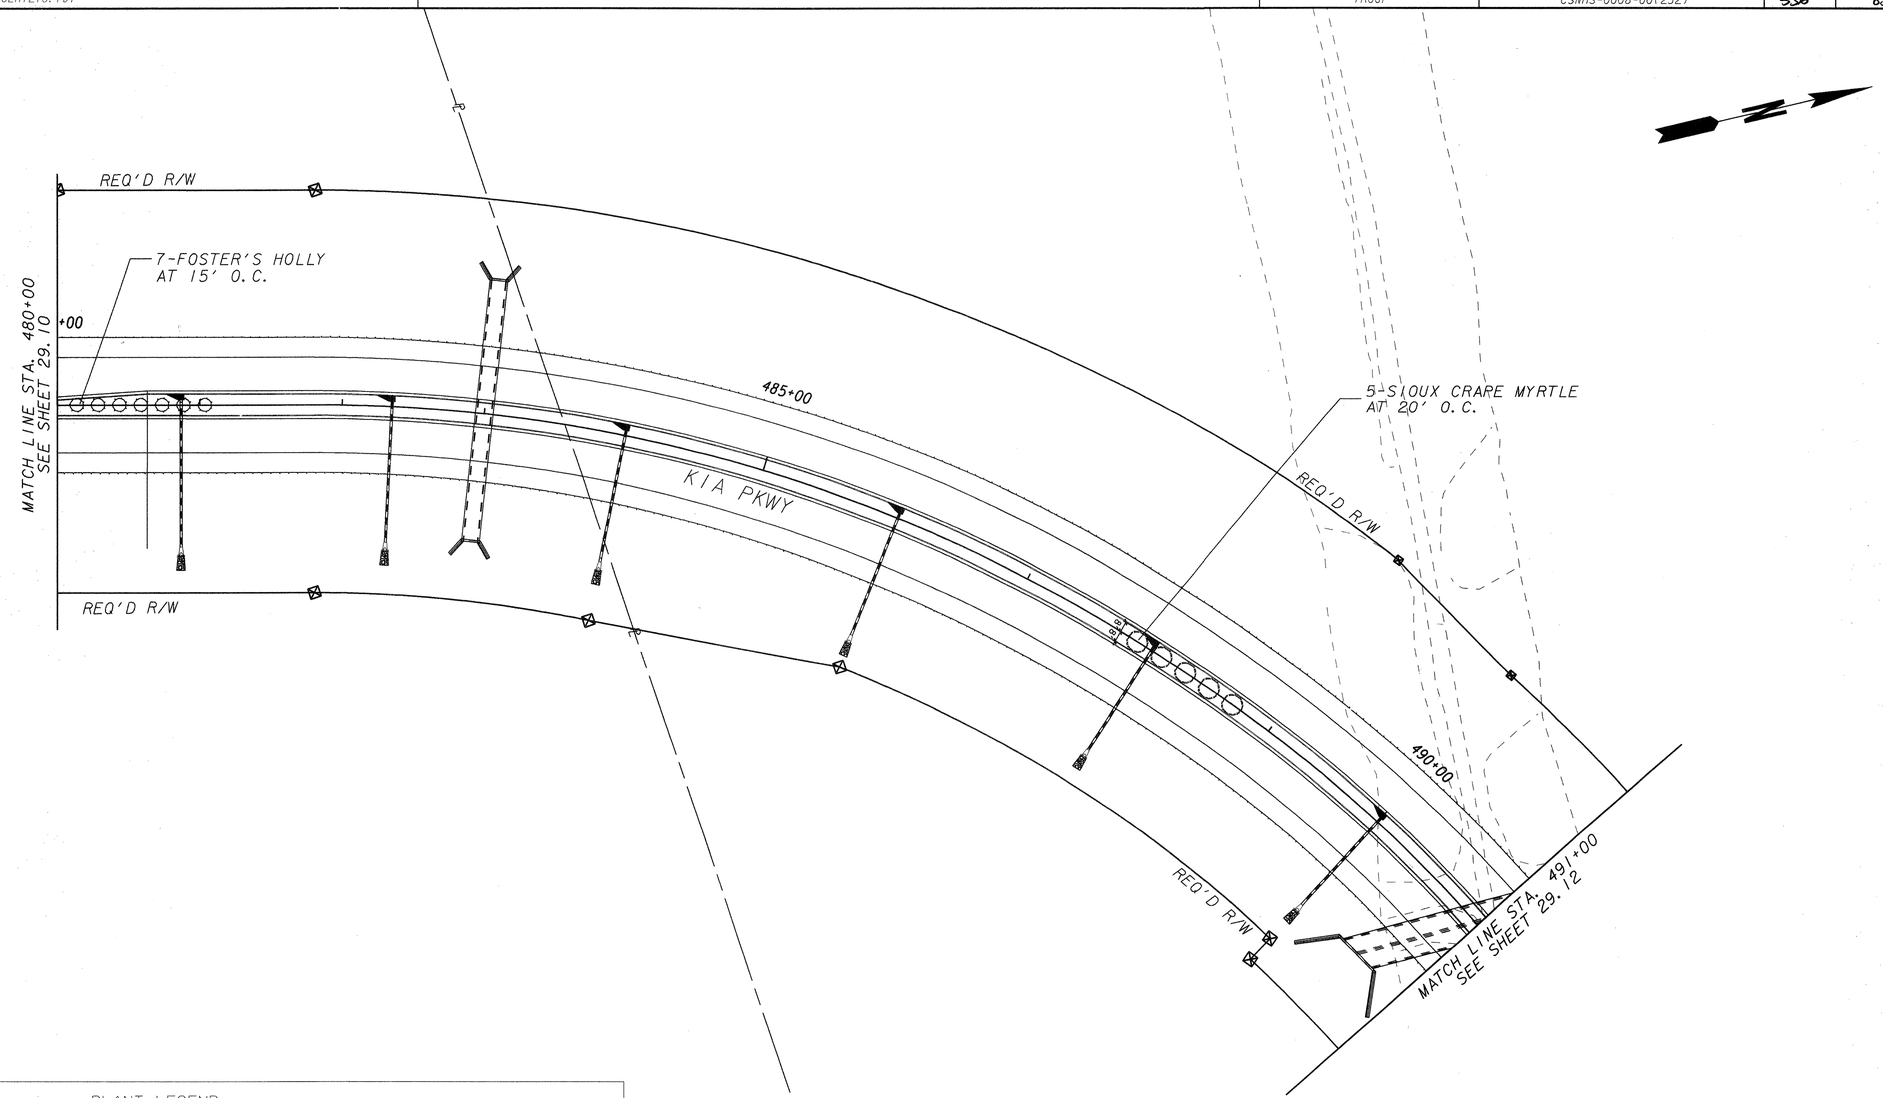

PLANT LEGEND

	Botanical Name	Common Name	Size	Spacing	Qty	Comments
	ACER SACCHARUM 'GREEN MOUNTAIN'	GREEN MOUNTAIN MAPLE	4" CAL.	AS INDICATED	-----	MATCHING
	ILEX CORNUTA 'CARISSA'	CARISSA HOLLY	3" GAL.	5' O.C.	-----	
	ILEX X ATTENUATA 'FOSTERI'	FOSTER'S HOLLY	5" GAL.	15' O.C.	7	
	LAGERSTROEMIA INDICA 'NATCHEZ'	NATCHEZ CRAPE MYRTLE	2" CAL.	AS INDICATED	-----	MULTISTEM
	LAGERSTROEMIA INDICA 'SIOUX'	SIOUX CRAPE MYRTLE	2" CAL.	AS INDICATED	5	MULTISTEM
	LIRIOPE MUSCARI 'BIG BLUE'	LIRIOPE	4" POT	12" O.C.	-----	
	PRUNUS X YEDOENSIS	YOSHINO CHERRY	2" CAL.	25' O.C.	-----	MATCHING
	QUERCUS NUTALLII	NUTTALL OAK	4" CAL.	AS INDICATED	-----	MATCHING
	QUERCUS PHELLOS	WILLOW OAK	4" CAL.	AS INDICATED	-----	MATCHING

ARCADIS
Infrastructure, environment, facilities

SCALE IN FEET
0 50 100 200

REVISION DATES

STATE OF GEORGIA
DEPARTMENT OF TRANSPORTATION
OFFICE: URBAN DESIGN

LANDSCAPING PLANS

I-85 INTERCHANGE
AT CR 98/GABBETTVILLE RD

DRAWING No. 29-11

AS-BUILT