COUNTY	PROJECT NUMBER	SHEET NO.	TOTAL SHEETS
TROUP	CSNHS-0008-00(232)	549	839

PLANT LEGEND

	Botanical Name	Common Name	Size	Spacing	Qty	Comments
	ACER SACCHARUM 'GREEN MOUNTAIN'	GREEN MOUNTAIN MAPLE	4" CAL.	AS INDICATED	-----	MATCHING
	ILEX CORNUTA 'CARISSA'	CARISSA HOLLY	3" GAL.	5' O.C.	-----	
	ILEX X ATTENUATA 'FOSTERI'	FOSTER'S HOLLY	5" GAL.	15' O.C.	-----	
	LAGERSTROEMIA INDICA 'NATCHEZ'	NATCHEZ CRAPE MYRTLE	2" CAL.	AS INDICATED	28	MULTISTEM
	LAGERSTROEMIA INDICA 'SIOUX'	SIOUX CRAPE MYRTLE	2" CAL.	AS INDICATED	10	MULTISTEM
	LIRIOPE MUSCARI 'BIG BLUE'	LIRIOPE	4" POT	12" O.C.	-----	
	PRUNUS X YEDOENSIS	YOSHINO CHERRY	2" CAL.	25' O.C.	-----	MATCHING
	QUERCUS NUTALLII	NUTTALL OAK	4" CAL.	AS INDICATED	-----	MATCHING
	QUERCUS PHELLOS	WILLOW OAK	4" CAL.	AS INDICATED	-----	MATCHING

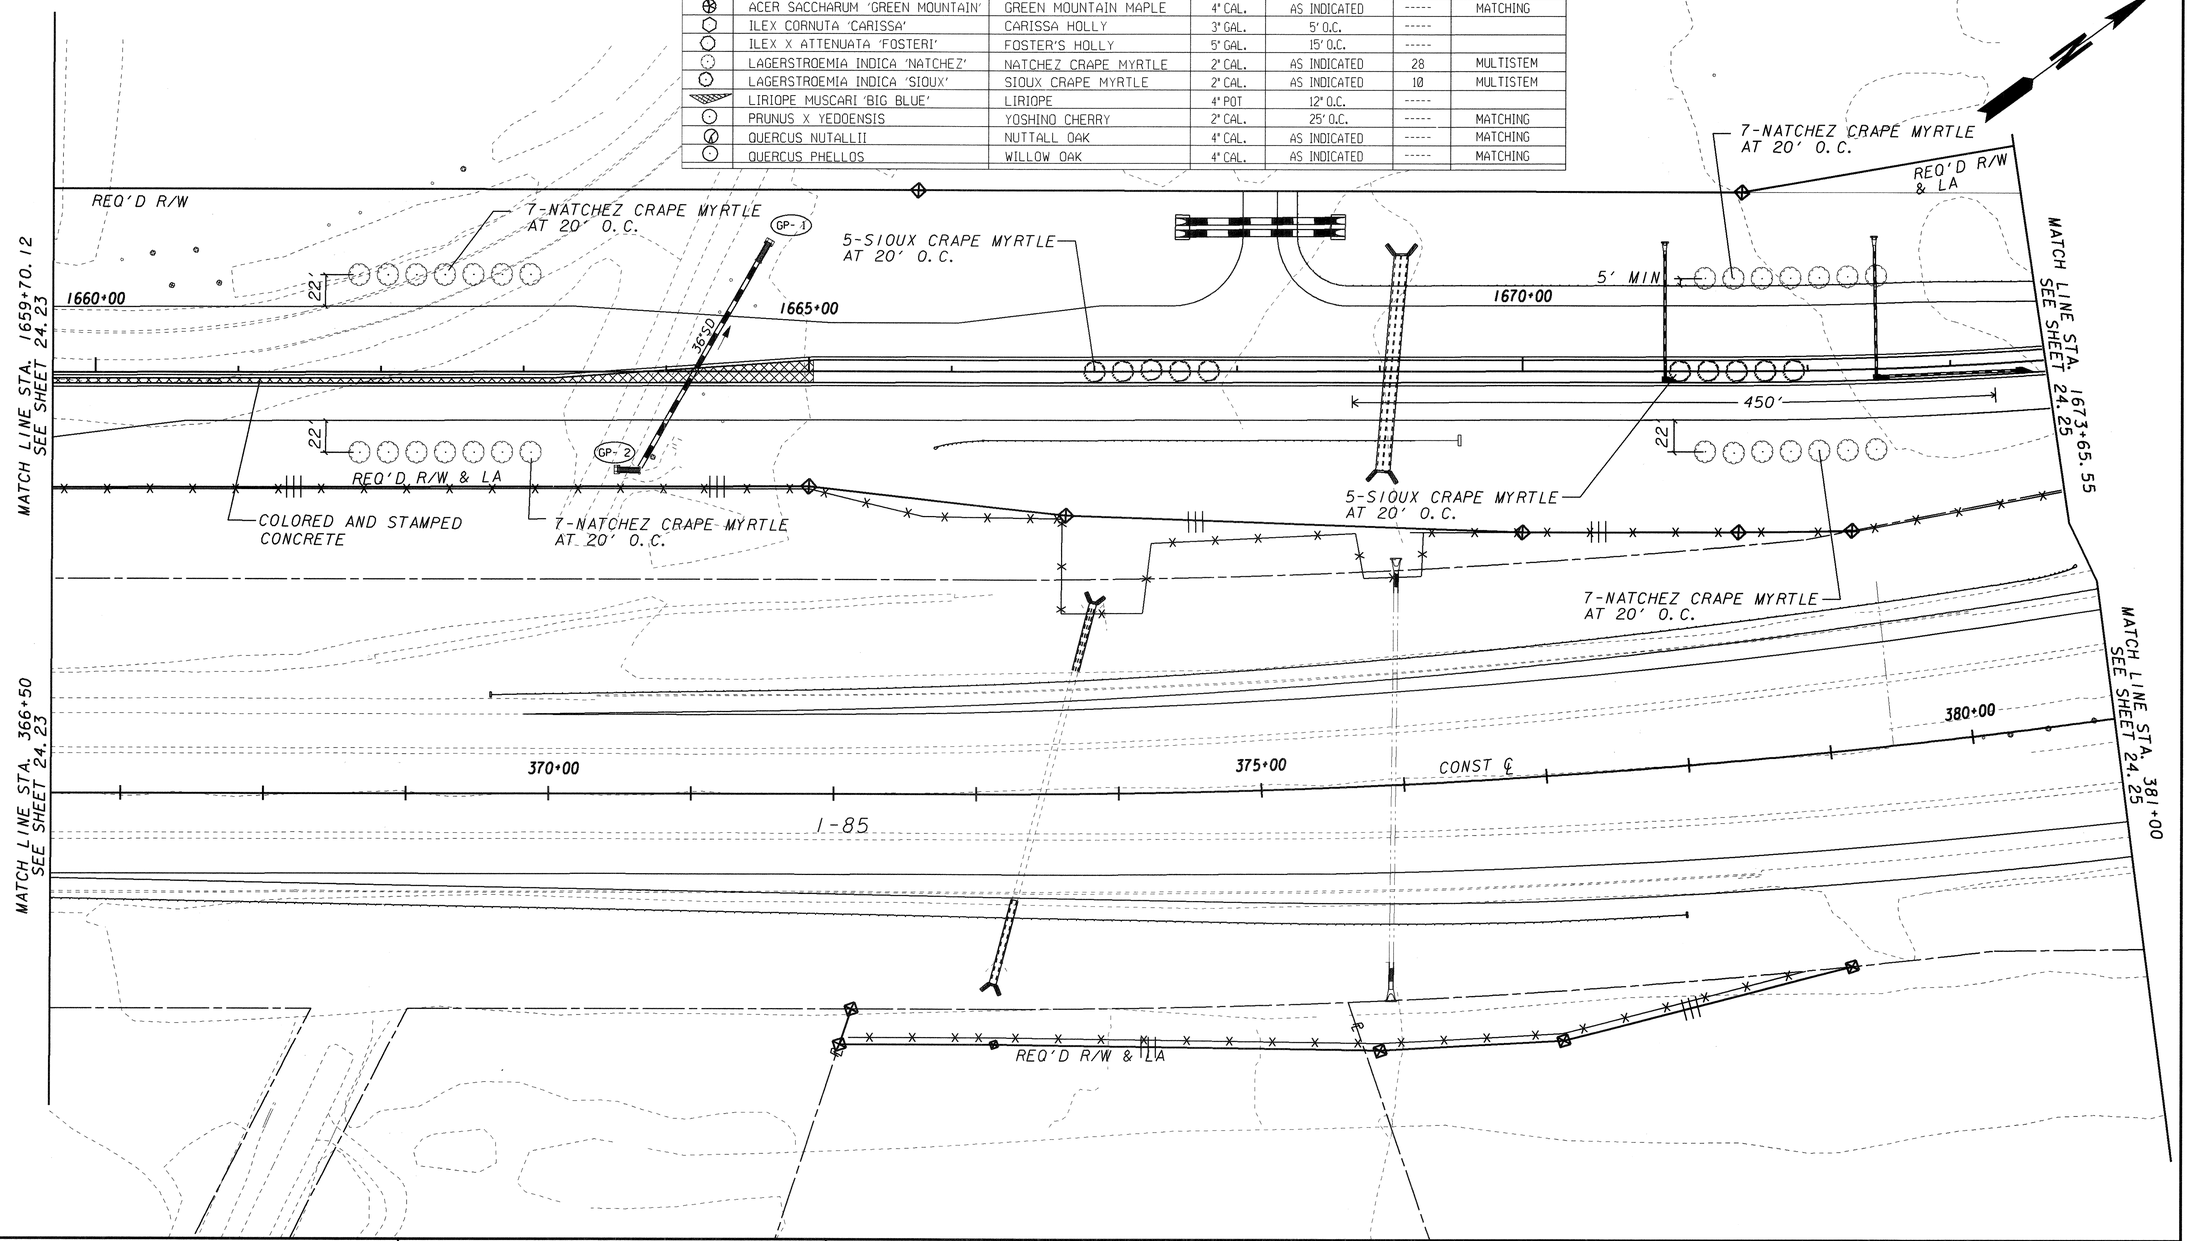

ARCADIS
Infrastructure, environment, facilities

SCALE IN FEET
0 50 100 200

REVISION DATES		
04-09-08		
12-12-08		

STATE OF GEORGIA
DEPARTMENT OF TRANSPORTATION
OFFICE: URBAN DESIGN

LANDSCAPING PLANS

I-85 INTERCHANGE
AT CR 98/GABBETTVILLE RD

DRAWING No. 29-24

AS-BUILT

PLAN DATE: 09-07-07

GPLN