STATE	PROJECT NUMBER	SHEET NO.	TOTAL SHEETS
GA.	CSNHS-0008-00(232)	575	839

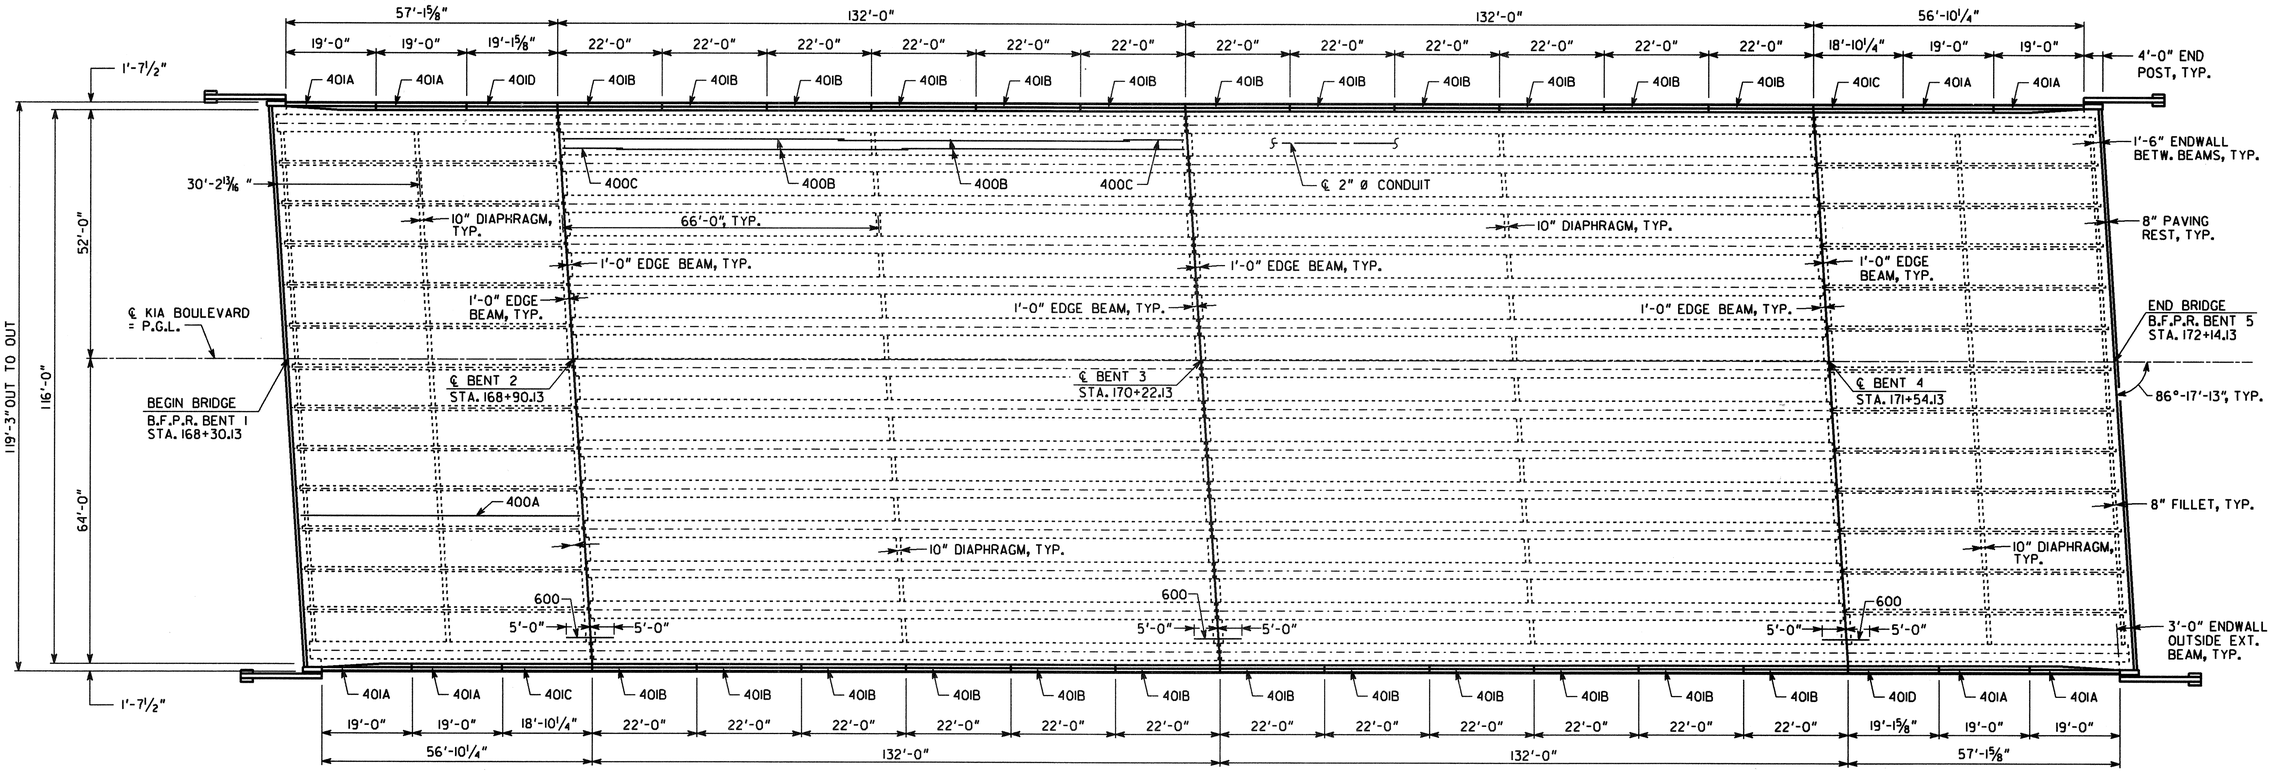

DECK PLAN

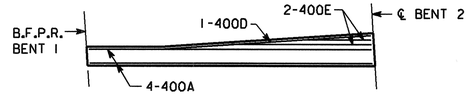

MEDIAN AT SPAN 1

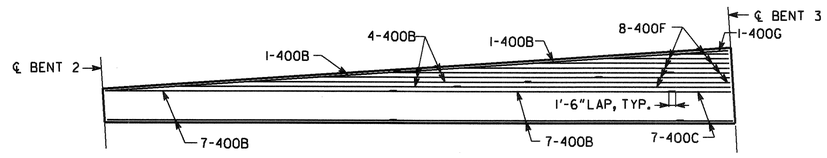

MEDIAN AT SPAN 2

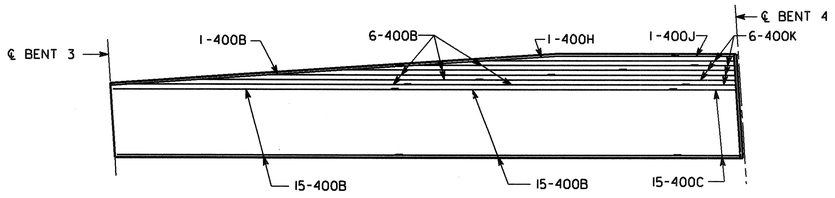

MEDIAN AT SPAN 3

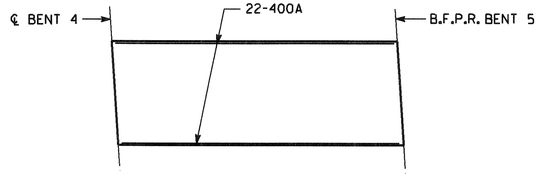

MEDIAN AT SPAN 4

SUPERSTRUCTURE QUANTITIES

ITEM	SPAN 1	SPAN 2	SPAN 3	SPAN 4	TOTAL
LUMP - SUPERSTR CONCRETE, CY, CLASS AA	226.0	483.7	501.5	244.8	1456.0
LUMP - SUPERSTR REINF STEEL, LB	54826	103953	102949	56179	317907

NOTE: END POST CONCRETE AND REINFORCEMENT INCLUDED IN END SPAN QUANTITIES. 600 BARS ARE INCLUDED IN SPANS 1, 2 AND 4.

APPROVED FOR CONSTRUCTION 1/19/08

NOTES:

1. MEDIAN NOT SHOWN IN DECK PLAN.
2. DIAPHRAGMS ARE PARALLEL TO BENTS.

BRIDGE NO. 1

ARCADIS
2849 PACES FERRY ROAD, SUITE 400
ATLANTA, GEORGIA 30339
TEL: 770/431-8666 FAX: 770/435-2666

GEORGIA
DEPARTMENT OF TRANSPORTATION
PRECONSTRUCTION DIVISION-OFFICE OF BRIDGE DESIGN

DATE | BY | REVISIONS

DECK PLAN
CR 98 (KIA BOULEVARD) OVER I-85

TROUP COUNTY — CSNHS-0008-00(232)

SCALE: NO SCALE — JULY 2007

DESIGNED	JPT	CHECKED	RHC	REVIEWED	WMD
DRAWN	MLF	DESIGN GROUP	SWW	APPROVED	PVL

BRIDGE SHEET 3 OF 20

PLAN DATE: 01-25-08

AS-BUILT

Filename: G:\Tro\63732-KIA\Bridge\Final\Bridge 1\63732BI-dp.dgn
Time: 9:20:23 AM
Date: 1/24/2008
User Name: MLF