STATE	PROJECT NUMBER	SHEET NO.	TOTAL SHEETS
GA.	CSNHS-0008-00(232)	578	839

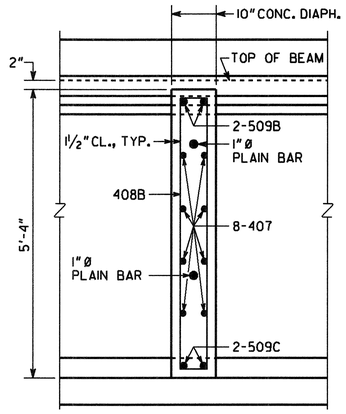

SLAB REINFORCEMENT NOT SHOWN.

SECTION THRU DIAPHRAGM
SPANS 2 AND 3

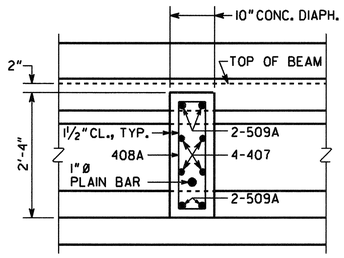

SLAB REINFORCEMENT NOT SHOWN.

SECTION THRU DIAPHRAGM
SPANS 1 AND 4

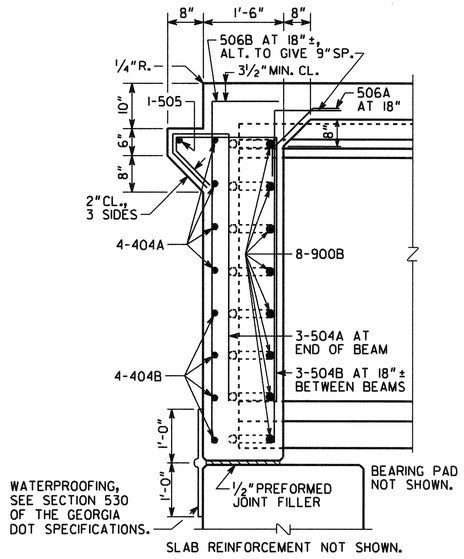

SLAB REINFORCEMENT NOT SHOWN.

SECTION AT ENDWALL
EXTERIOR BEAM

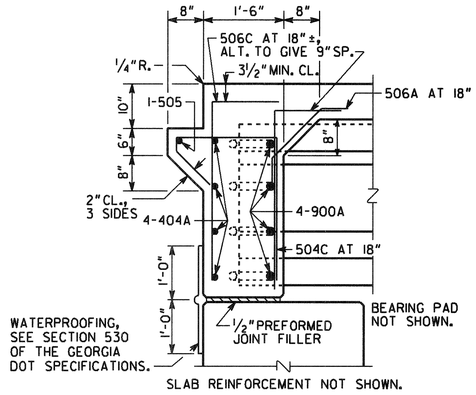

SLAB REINFORCEMENT NOT SHOWN.

SECTION AT ENDWALL
INTERIOR BEAM

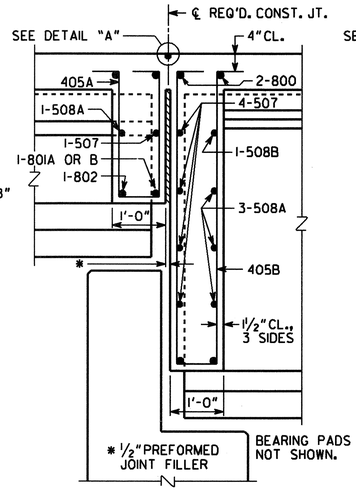

SLAB REINFORCEMENT NOT SHOWN.

SECTION THRU EDGE BEAM
BENTS 2 AND 4

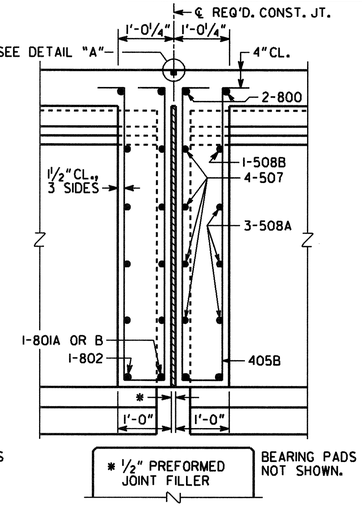

SLAB REINFORCEMENT NOT SHOWN.

SECTION THRU EDGE BEAM
BENT 3

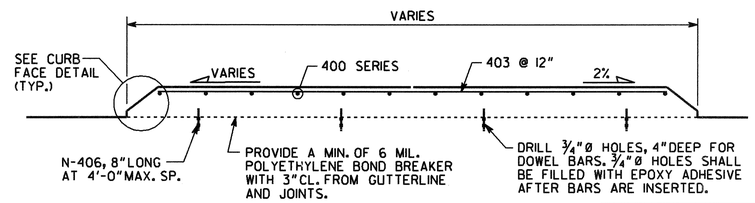

NOTE: TOP OF MEDIAN SLOPE MATCHES TOP OF DECK.

RAISED MEDIAN DETAILS

MEDIAN WIDTH	N
4'	2
VARIABLE	3
22'	4

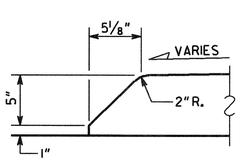

CURB FACE DETAIL

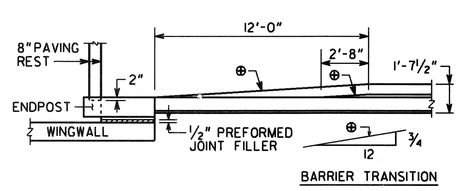

BARRIER TRANSITION

BARRIER TRANSITION DETAIL

USE ANVIL INTERNATIONAL UNIVERSAL CONCRETE INSERT FIG. 282 OR EQUAL. HANGERS SHALL BE SPACED AT A MAXIMUM OF 8'-0" O.C. SEE TRAFFIC SIGNAL PLANS FOR CONDUIT DETAILS.

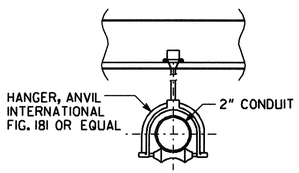

CONDUIT SUPPORT DETAILS

* SEAL AS PER GEORGIA DOT SPECIFICATIONS SECTION 449.2.D. SEAL SHALL BE 2" (H) BY 1¼" WIDE PRIOR TO INSTALLATION.

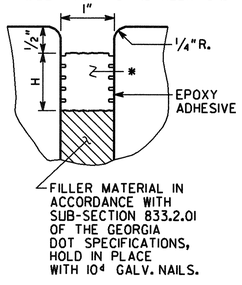

SECTION THROUGH EXPANSION JOINT AT APPROACH SLAB

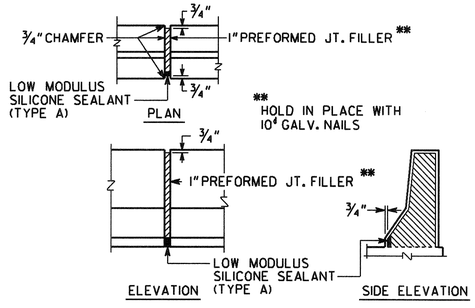

DETAILS OF 1"EXPANSION JOINT IN BARRIER

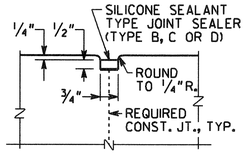

DETAIL "A"

* TAPERS TO 0" AT END POST

** AT CONTRACTOR'S OPTION, 10"RADIUS MAY BE REPLACED BY STRAIGHT INTERSECTING SLOPES.

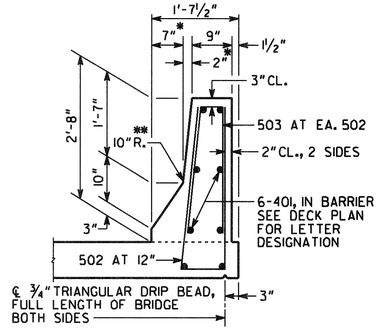

BARRIER DETAIL

APPROVED FOR CONSTRUCTION 1/19/08

BRIDGE NO. 1

ARCADIS
2849 PACES FERRY ROAD, SUITE 400
ATLANTA, GEORGIA 30339
TEL: 770/431-8666 FAX: 770/435-2666

GEORGIA
DEPARTMENT OF TRANSPORTATION
PRECONSTRUCTION DIVISION-OFFICE OF BRIDGE DESIGN

SUPERSTRUCTURE DETAILS
CR 98 (KIA BOULEVARD) OVER I-85

TROUP COUNTY — CSNHS-0008-00(232)

SCALE: NO SCALE — JULY 2007

BY	DATE	REVISIONS

DESIGNED	JPT	CHECKED	RHC	REVIEWED	WMD
DRAWN	MLF	DESIGN GROUP	SWW	APPROVED	PVL

BRIDGE SHEET 6 OF 20

PLAN DATE: 01-25-08

AS-BUILT

Filename: g:\tro\63732-kio\bridge\final\bridge 1\63732bi-rnd.dgn
Date: 1/24/2008 Time: 8:30:11 AM
User Name: MLF