STATE	PROJECT NUMBER	SHEET NO.	TOTAL SHEETS
GA.	CSNHS-0008-00(232)	601	839

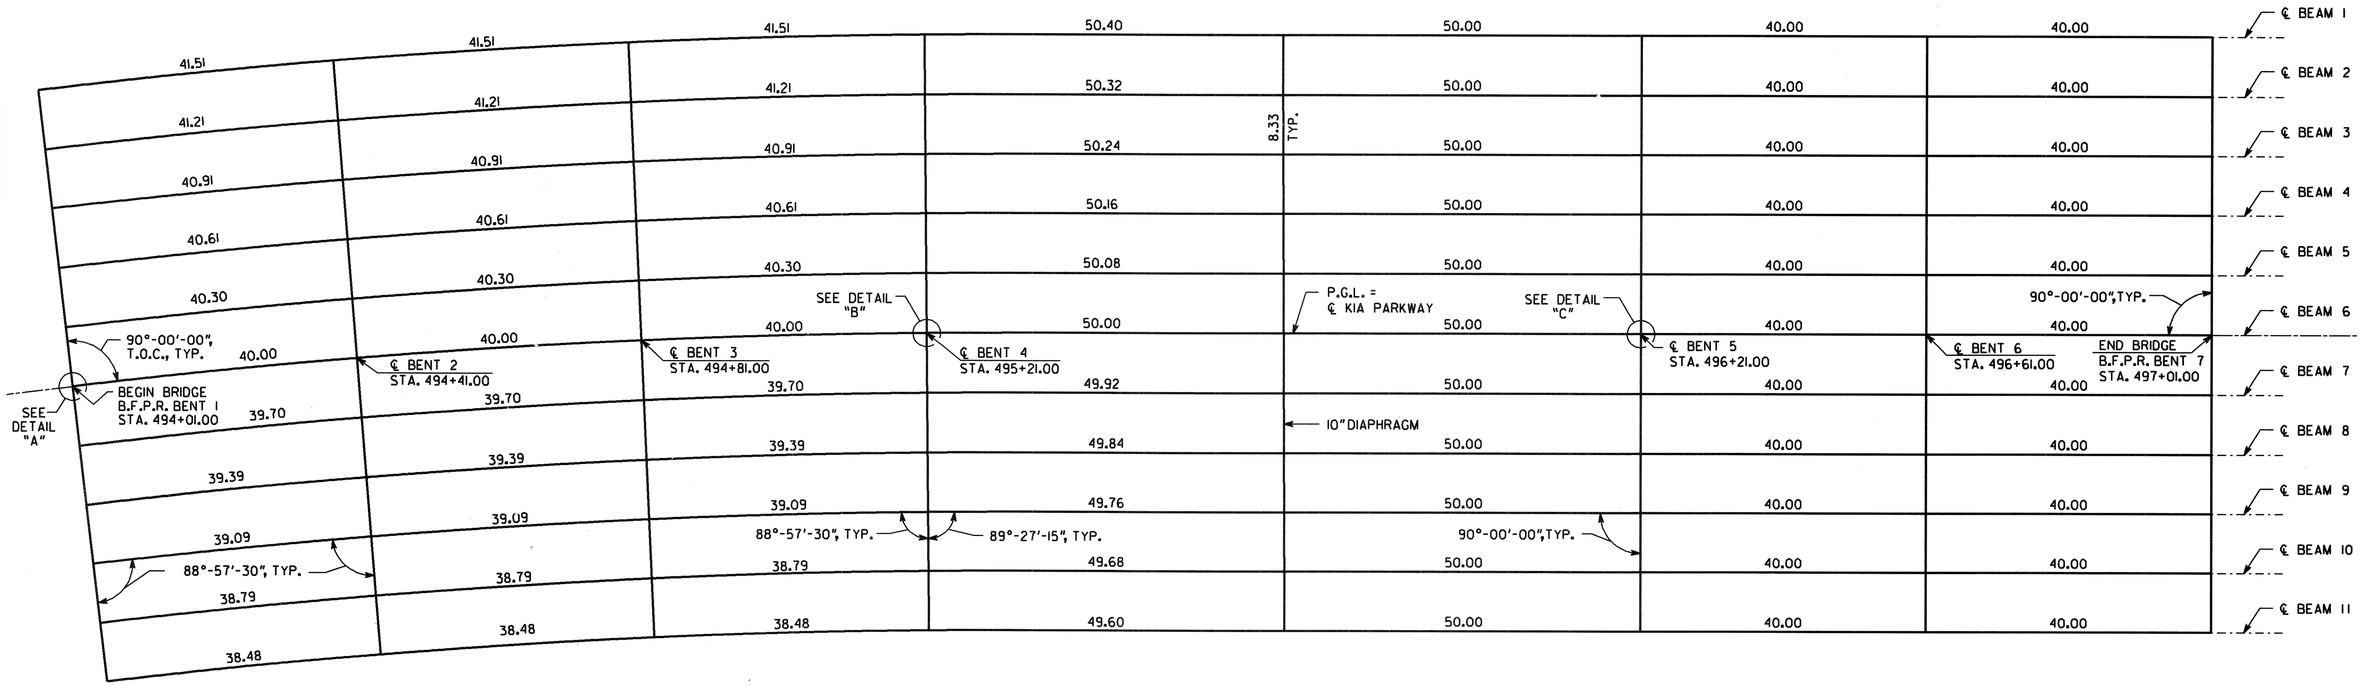

FRAMING PLAN

NOTES:

1. DIMENSIONS ALONG BEAM IN SPAN 4 ARE FROM ℄ DIAPHRAGM TO ℄ BENT. DIMENSIONS ALONG BEAM IN OTHER SPANS ARE FROM ℄ BENT TO ℄ BENT OR B.F.P.R.
2. BEAMS IN SPANS 1, 2, AND 3 ARE CHORDS OF CONCENTRIC CIRCLES SPACED AT 8'-4". BEAMS IN SPAN 4 ARE PARALLEL TO THE CENTERLINE IN THE TANGENT. SEE DETAILS "A", "B", AND "C" FOR OFFSET OF BEAM 6 TO ℄ BRIDGE. BEAMS IN SPANS 5 AND 6 ARE PARALLEL TO ℄ BRIDGE.
3. BENTS ARE RADIAL.

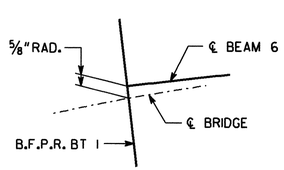

DETAIL "A"

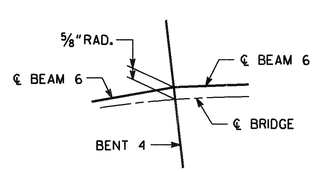

DETAIL "B"

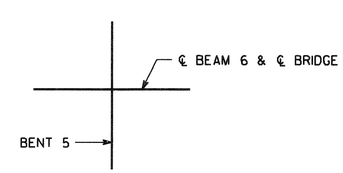

DETAIL "C"

APPROVED FOR CONSTRUCTION 1/11/08

BRIDGE NO. 2

ARCADIS
2849 PACES FERRY ROAD, SUITE 400
ATLANTA, GEORGIA 30339
TEL: 770/431-8666 FAX: 770/435-2666

GEORGIA
DEPARTMENT OF TRANSPORTATION
PRECONSTRUCTION DIVISION-OFFICE OF BRIDGE DESIGN

FRAMING PLAN
KIA PARKWAY OVER LONG CANE CK.

TROUP COUNTY CSNHS-0008-00(232)

SCALE: NO SCALE JULY 2007

DESIGNED	RHC	CHECKED	JPT	REVIEWED	WMD
DRAWN	MLF	DESIGN GROUP	SWW	APPROVED	PVL

BRIDGE SHEET 8 OF 21

DATE | REVISIONS | BY

PLAN DATE: 01-25-08

AS-BUILT

Filename: g:\tra\63732-kia\bridge\final\bridge 2\63732b2-fp.dgn
Date: 1/24/2008 Time: 8:27:59 AM
User Name: MLF