1 Sep 03 07:48:30 1999 \\GDOT_GO_SV20\OCF\OSD_Mulgar.ocf posta M:\standard\English\ENGLISH\9102.prf

STATE	PROJECT NUMBER	SHEET NO.	TOTAL SHEETS
GA.		771	839

GENERAL NOTES:

1. ALL TRAFFIC CONTROL DEVICES SHALL BE MADE AND ERECTED IN ACCORDANCE WITH THE DETAILS SHOWN ON THE PLANS; THE MUTCD; THE GEORGIA STANDARD SPECIFICATIONS, AND/OR SPECIAL PROVISIONS. (SEE SECTION 150.)
2. ALL TRAFFIC CONTROL DEVICES SHALL BE AS SHOWN, OR AS DIRECTED BY THE ENGINEER. ADDITIONAL DEVICES MAY BE REQUIRED AS DIRECTED BY THE ENGINEER.
3. ALL PORTABLE MOUNTED SIGNS SHALL BE MOUNTED SO THAT THE BOTTOM OF THE SIGN WILL BE BETWEEN 1 FT. AND 3 FT. ABOVE THE PAVEMENT EDGE. ALL TEMPORARY POST MOUNTED SIGNS SHALL BE MOUNTED SO THAT THE BOTTOM OF THE SIGN BE 7' MINIMUM ABOVE PAVEMENT EDGE.
4. WHEN THE CONSTRUCTION AREA HAS ENTRANCE/EXIT RAMPS OR INTERSECTIONS, WORK WILL BE PERFORMED IN SUCH A MANNER TO PERMIT TRAFFIC TO OPERATE WITH THE LEAST AMOUNT OF INCONVENIENCE AS POSSIBLE. ADDITIONAL CHANNELIZATION AND SIGNING SHALL BE INSTALLED, AS REQUIRED, TO ALLOW TRAFFIC TO REMAIN AS OPERATIONAL AS POSSIBLE. WHEN ENTRANCE RAMPS/INTERSECTIONS ARE INOPERABLE, FLAGGERS WILL BE UTILIZED TO CONTROL AND PROHIBIT MOVEMENT INTO THE PROJECT AT THAT POINT UNTIL CONSTRUCTION HAS CLEARED THE RESTRICTION SUFFICIENT TO RETURN TO OPERATIONAL STATUS.
5. FOR NIGHT TIME OPERATIONS, ALL CHANNELIZING DEVICES I' VANCE OF AND THROUGHOUT THE WORK AREA SHALL BE STRIPED DRUMS AND SHALL HAVE 10"x10" YELLOW PANELS W.IH TIPE V SHEETING ON THE TAPERS ONLY. SPACING OF DEVICES SHALL BE AS SHOWN DURING DAYLIGHT HOURS, CONES (28" IN.) MAY BE USED IN ADVANCE OF AND THROUGHOUT WORK AREA.
6. SIGNS SHOWN HERE ARE IN ADDITION TO ALL ADVANCE WARNING SIGNS REQUIRED IN SECTION 150. WARNING FLAGS OR / AND FLASHING LIGHTS ON SIGNS SHALL BE AS REQUIRED BY SECTION 150.
7. FLAGGERS SHALL BE PROVIDED AS NECESSARY TO PROHIBIT WRONG DIRECTION OF TRAFFIC THRU WORK AREAS.
8. WHEN NOT IN USE, PORTABLE SIGNS SHALL BE REMOVED FROM THE TRAVELWAY SO THAT THE MESSAGE IS NOT VISIBLE TO THE MOTORIST. INTRIM SIGNS THAT ARE PERMANENT MOUNTED SHALL BE COVERED WHEN NOT APPLICABLE. SEE SECTION 150.
9. PAYMENT FOR TRAFFIC CONTROL SHALL BE PER SECTION 150
10. PAVEMENT MARKINGS FOR TEMPORARY TRAFFIC CONTRO.. IF ..ED ..LL BE IN ACCORDANCE WITH SECTION 150 AND AS DIRECTED BY THE ENGINEER OR SHOWN IN THE PLANS.

11.(a) ON PROJECTS WITH LOW OR SOFT SHOULDERS, THE CONTRACT.. SHALL ERECT IMMEDIATELY AHEAD OF CONSTRUCTION OPERATIONS "LOW/SOFT SHOULDER" WARNING SIGNS AT THE PROJECT TERMINI, AT INTERVALS NOT TO EXCEED ONE MILE AND IMMEDIATELY PAST EACH CROSSROAD.

(b) WHERE THE CONTRACTOR IS NOT RESPONSIBLE FOR SHOULDER CONSTRUCTION THE DEPARTMENT WILL FURNISH THESE SIGNS FOR THE CONTRACTOR TO PICK-UP, TRANSPORT AND ERECT, THE DEPARTMENT WILL LATER REMOVE AND RETAIN THE SIGNS.

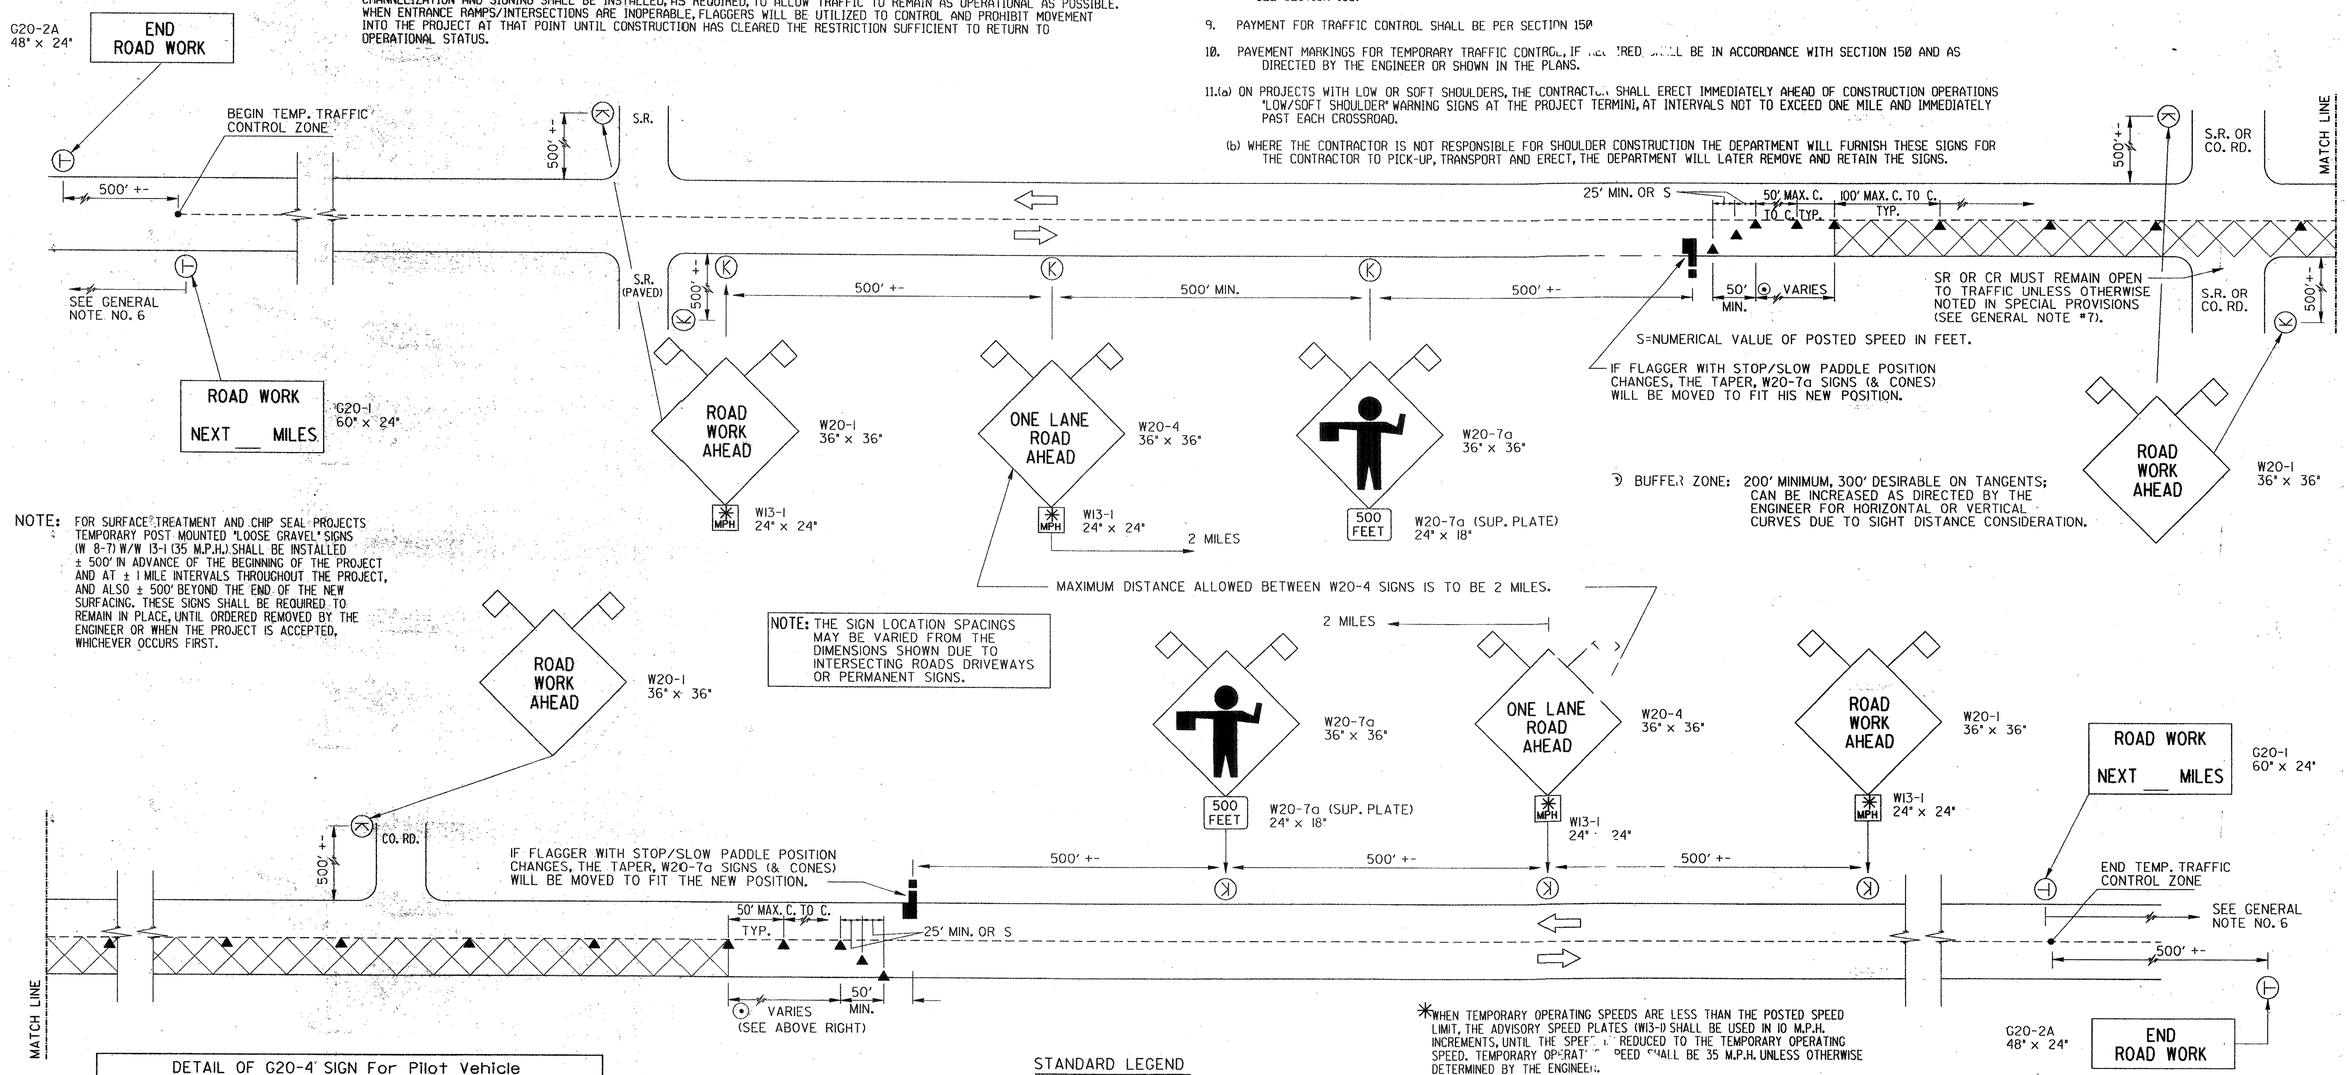

NOTE: FOR SURFACE TREATMENT AND CHIP SEAL PROJECTS TEMPORARY POST MOUNTED "LOOSE GRAVEL" SIGNS (W 8-7) W/W 13-1 (35 M.P.H.) SHALL BE INSTALLED ± 500' IN ADVANCE OF THE BEGINNING OF THE PROJECT AND AT ± 1 MILE INTERVALS THROUGHOUT THE PROJECT, AND ALSO ± 500' BEYOND THE END OF THE NEW SURFACING. THESE SIGNS SHALL BE REQUIRED TO REMAIN IN PLACE, UNTIL ORDERED REMOVED BY THE ENGINEER OR WHEN THE PROJECT IS ACCEPTED, WHICHEVER OCCURS FIRST.

NOTE: THE SIGN LOCATION SPACINGS MAY BE VARIED FROM THE DIMENSIONS SHOWN DUE TO INTERSECTING ROADS DRIVEWAYS OR PERMANENT SIGNS.

*WHEN TEMPORARY OPERATING SPEEDS ARE LESS THAN THE POSTED SPEED LIMIT, THE ADVISORY SPEED PLATES (W13-1) SHALL BE USED IN 10 M.P.H. INCREMENTS, UNTIL THE SPEE.. .. REDUCED TO THE TEMPORARY OPERATING SPEED. TEMPORARY OPERAT.. SPEED SHALL BE 35 M.P.H. UNLESS OTHERWISE DETERMINED BY THE ENGINEER.

DETAIL OF G20-4 SIGN For Pilot Vehicle
IF REQUIRED OR USED ON PROJECT

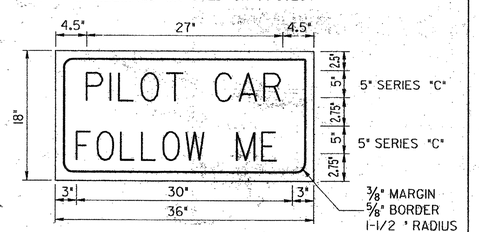

STANDARD LEGEND

- 18" X 18" FLOURESCENT RED/ORANGE OR ORANGE/RED WARNING FLAG REQUIRED ON ALL PORTABLE MOUNTED SIGNS
- ● STRIPED DRUM
- ⊢ PERMANENT TYPE POST MOUNTED SIGN (7' MOUNT HEIGHT)
- Ⓣ TEMPORARY POST MOUNTED SIGN - NO FLAGS REQUIRED (7' MOUNT HEIGHT)
- Ⓚ PORTABLE MOUNTED SIGN - FLAGS REQUIRED (1' TO 3' MOUNT HEIGHT)
- WORK AREA
- ▲ TRAFFIC CONE - 28" MIN. - DAYTIME USE ONLY
- FLAGGER WITH STOP-SLOW PADDLE

DATE	REVISION	BY

DEPARTMENT OF TRANSPORTATION
STATE OF GEORGIA

STANDARD TRAFFIC CONTROL DETAIL

FOR LANE CLOSURE ON TWO-LANE HIGHWAY

NO SCALE — REV. & REDR. JULY, 1999

DES. ___ DRW. ___ TRA. ___ CHK. ___

(SUBMITTED) STATE ROAD & AIRPORT DESIGN ENGINEER
(APPROVED) CHIEF ENGINEER

NUMBER 9102

AS-BUILT