5/6/2008
wcrenshaw

63732-K1A
AGMENG.tbl

G:\TRA\63732-K1A\rdy\008232EC01.dgn

COUNTY	PROJECT NUMBER	SHEET NO.	TOTAL SHEETS
TROUP	CSNHS-0008-00(232)	773	839

DEPARTMENT OF TRANSPORTATION
STATE OF GEORGIA

EROSION, SEDIMENT & POLLUTION CONTROL PLAN

I-85 INTERCHANGE
AT CR 98 / GABBETTVILLE ROAD
CSNHS-0008-00(232) TROUP COUNTY

FEDERAL AID PROJECT

Georgia D.O.T. P.I. No. 0008232
FEDERAL ROUTE No. N/A
STATE ROUTE No. N/A

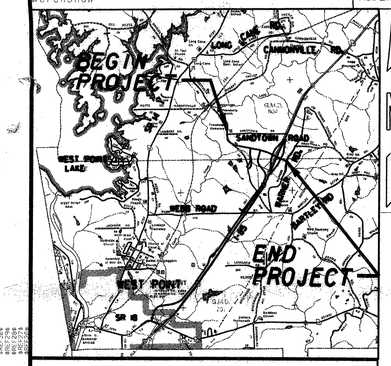

LOCATION SKETCH

NOTE: THE CO-ORDINATES LISTED ARE WEST ZONE GRID CO-ORDINATES BASED ON THE GA. STATE PLANE CO-ORDINATE SYSTEM OF:
HORIZONTAL DATUM : NAD 83/94
VERTICAL DATUM : NAVD 88

MIDPOINT COORDINATE
STATION 142+26.40
N 1067272.7619
E 2004811.8969

Primary Permittee:
C. W. Matthews Contracting Co. Inc.
1600 Kenview Drive
Marietta, GA 3060
770.422.7520

24-Hour local contact responsible for erosion, sedimentation and pollution controls:
Curtis Averett
404.978.3894

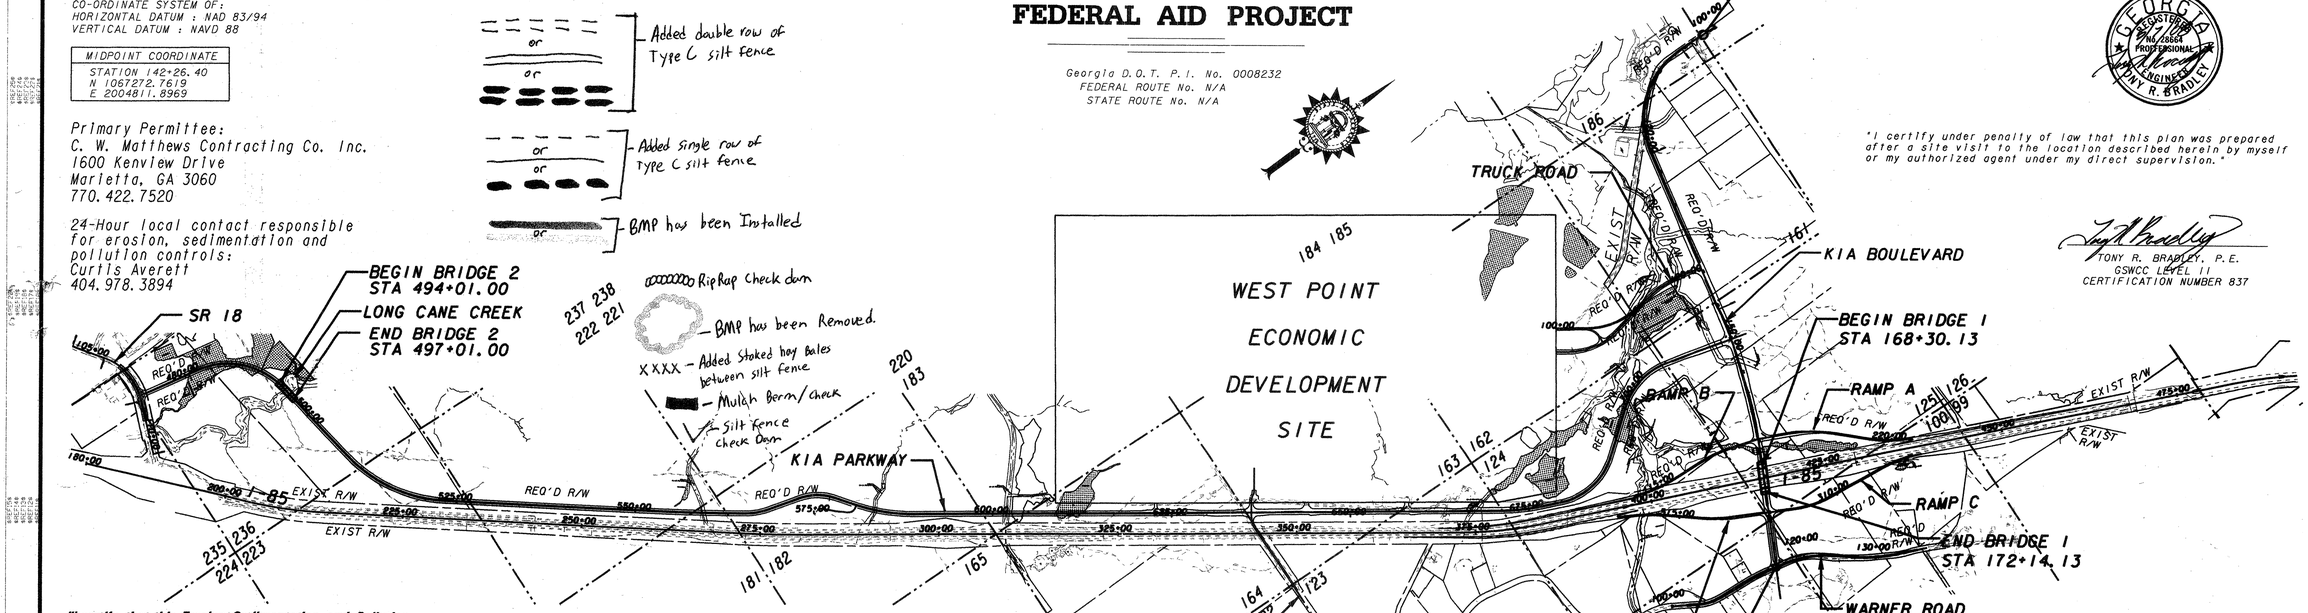

"I certify under penalty of law that this plan was prepared after a site visit to the location described herein by myself or my authorized agent under my direct supervision."

TONY R. BRADLEY, P.E.
GSWCC LEVEL II
CERTIFICATION NUMBER 837

GEORGIA REGISTERED PROFESSIONAL ENGINEER No. 28664 TONY R. BRADLEY

AS-BUILT

"I certify that this Erosion, Sedimentation and Pollution Control plan Has been prepared in accordance with part IV GAR 100002"

"I certify that the permittee's Erosion, Sedimentation and Pollution Control Plan provides for an appropriate and comprehensive system of best management practices required by the Georgia Water Quality Control Act and the document "Manual for Erosion and Sediment Control in Georgia" (Manual) published by the State Soil and Water Conservation Commission as of January 1 of the year in which the land-disturbing activity was permitted, provides for the sampling of the receiving water(s) or the sampling of the storm water outfalls and that the designed system of best management practices and sampling methods is expected to meet the requirements contained in the General NPDES Permit No. GAR 100002."

"I certify that the permittee's Erosion, Sedimentation and Pollution Control Plan provides for the monitoring of: (a) all perennial and intermittent streams and other water bodies shown on the USGS topographic map and all other field verified perennial and intermittent streams and other water bodies, or (b) where any such specific identified perennial or intermittent stream and other water body is not proposed to be sampled, I have determined in my professional judgement, utilizing the factors required in the General NPDES Permit No. GAR 100002, that the increase in the turbidity of each specific identified sampled receiving water will be representative of the increase in the turbidity of a specific identified un-sampled receiving water."

"I certify under penalty of law that this document and all attachments were prepared under my direction or supervision in accordance with a system designed to assure that the qualified personnel properly gather and evaluate the information submitted. Based on my inquiry of the person or persons who manage the system, or those persons directly responsible for gathering the information, the information submitted is, to the best of my knowledge and belief, true, accurate, and complete. I am aware that there are significant penalties for submitting false information, including the possibility of fine and imprisonment for knowing violations."

ARCADIS
Infrastructure, environment, facilities

SCALE IN FEET
0 1000 2000 4000

COUNTY NO. 285 LENGTH OF PROJECT PI NO 0008232-TROUP COUNTY	KIA BLVD	KIA PKWY
	MILES	MILES
NET LENGTH OF ROADWAY	1.45	4.52
NET LENGTH OF BRIDGES	0.07	0.06
NET LENGTH OF PROJECT	1.52	4.58
NET LENGTH OF EXCEPTIONS	0.00	0.00
GROSS LENGTH OF PROJECT	1.52	4.58

Signature
David E. Studstill, GSWCC LEVEL II Certification #0000000167

PLANS COMPLETED 2-19-07
REVISIONS

DATE	PAGE NUMBER	SIGNATURE	GSWCC LEVEL II #
05/06/08	773,774,775,776		837