8/29/2007	1:37:09 PM	PRF	g:\tra\63732-kla\rdy\008232er21.dgn	COUNTY	PROJECT NUMBER	SHEET NO.	TOTAL SHEETS
jlangley		88EH1218.tbl		TROUP	CSNHS-0008-00(232)	803	839

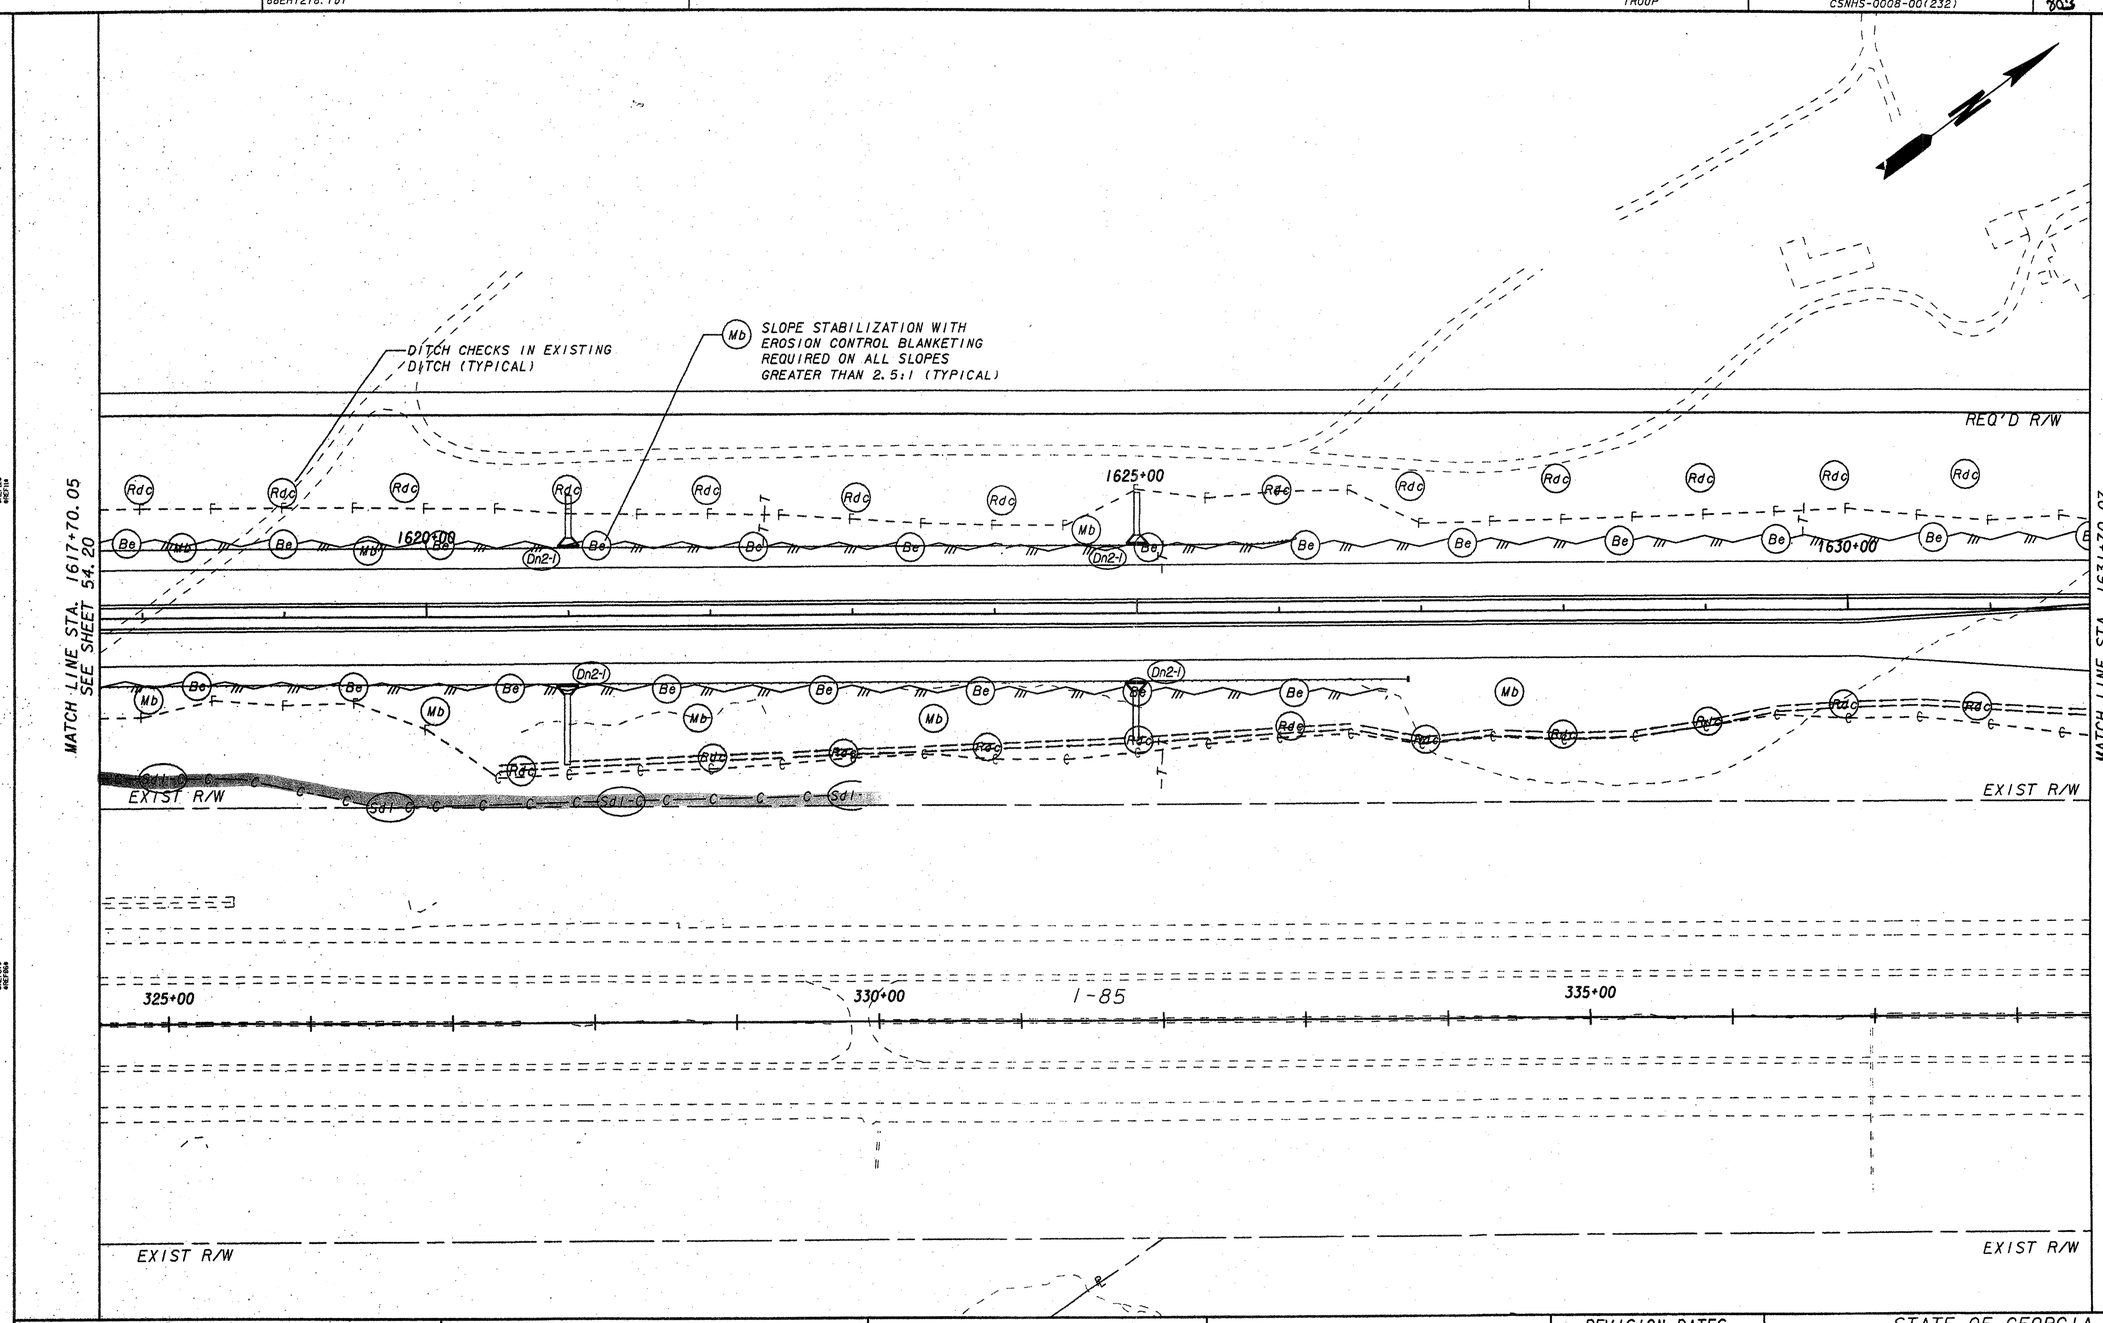

ARCADIS
Infrastructure, environment, facilities

SCALE IN FEET
0 50 100 200

REVISION DATES

STATE OF GEORGIA
DEPARTMENT OF TRANSPORTATION
OFFICE: URBAN DESIGN

BMP LOCATION DETAILS

I-85 INTERCHANGE
AT CR 98/GABBETTVILLE RD

DRAWING NO. 54-21

AS-BUILT

PLAN DATE - 09-07-07