8/29/2007 1:36:47 PM PRF	g:\tro\63732-kia\rdy\008232er06.dgn	COUNTY	PROJECT NUMBER	SHEET NO.	TOTAL SHEETS
jlangley 88EH1218.tbl		TROUP	CSNHS-0008-00(232)	788A	839

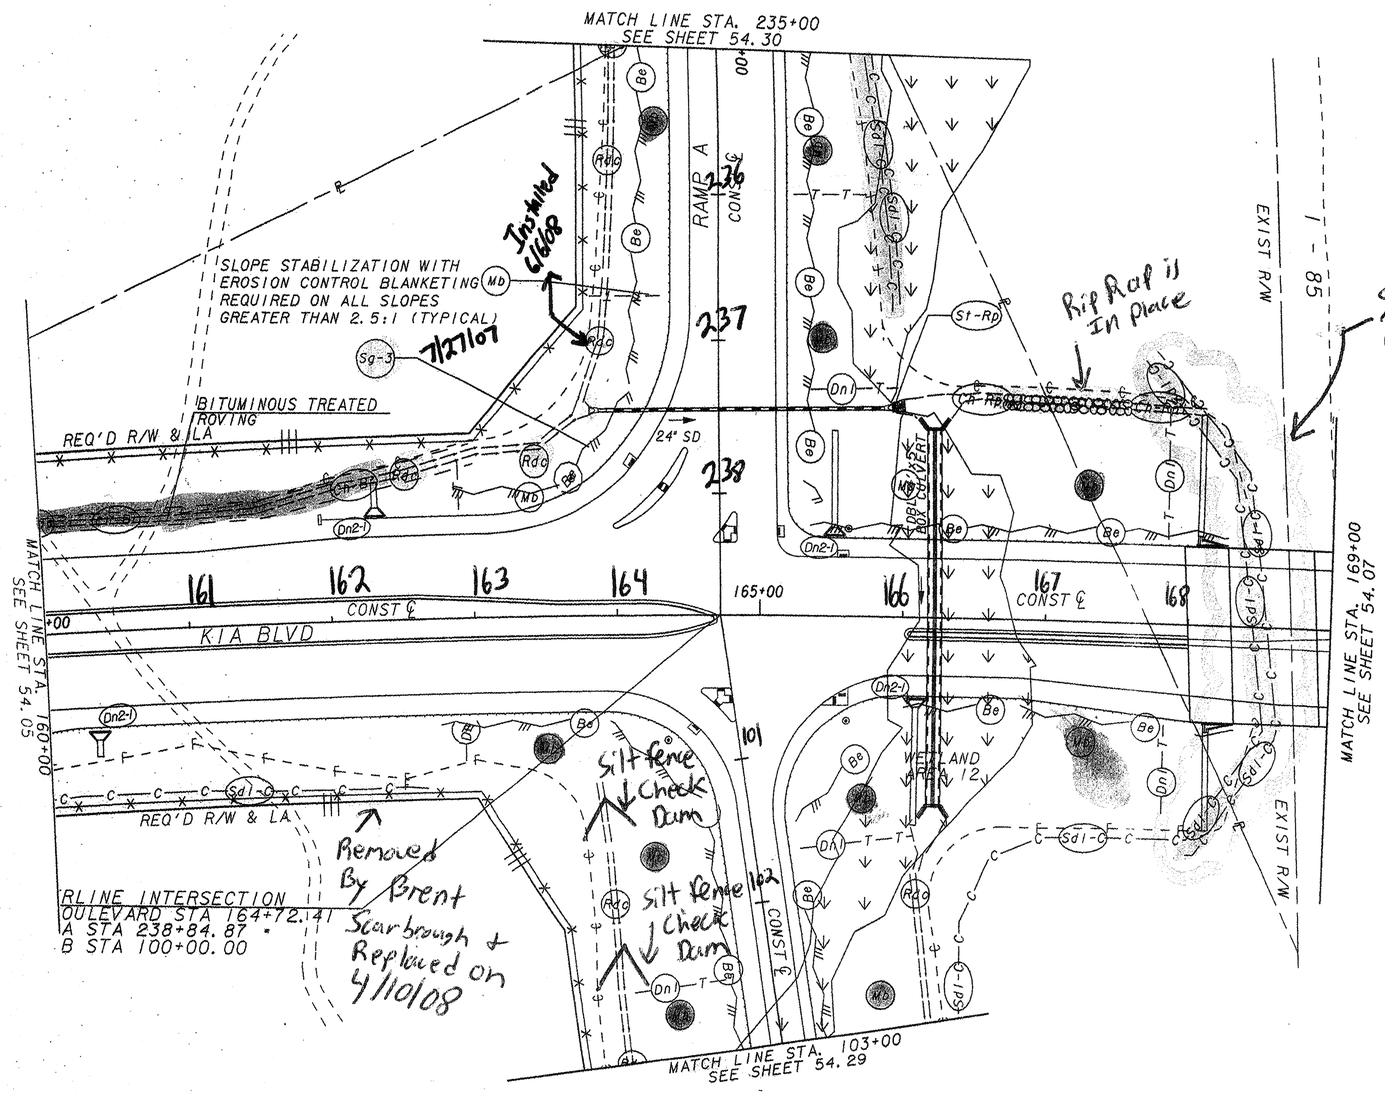

AS-BUILT

ARCADIS
Infrastructure, environment, facilities

SCALE IN FEET
0 50 100 200

REVISION DATES		

STATE OF GEORGIA
DEPARTMENT OF TRANSPORTATION
OFFICE: URBAN DESIGN

BMP LOCATION DETAILS

I-85 INTERCHANGE
AT CR 98/GABBETTVILLE RD

DRAWING No. 54-06