STATE	PROJECT NUMBER	SHEET NO.	TOTAL SHEETS
GA.		828	839

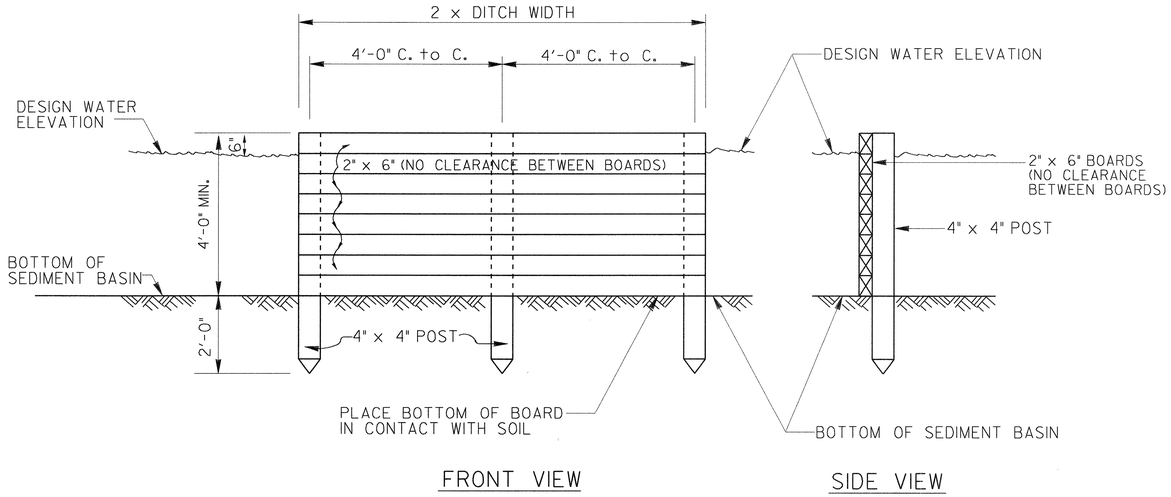

INLET BAFFLE

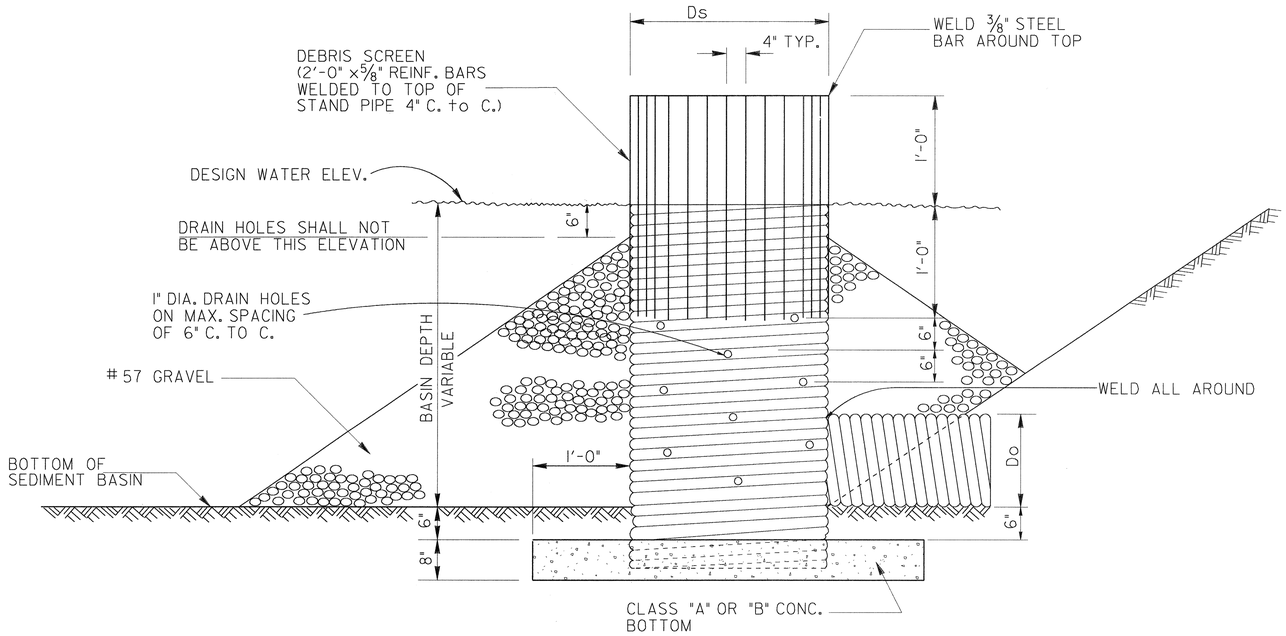

PRIMARY SPILLWAY
FOR
SEDIMENT BASIN TYPE-I

USES:

PRIMARY SPILLWAYS, TYPE-I, ARE TO BE USED WITH SEDIMENT BASINS, TYPE-I. (SEE SEPARATE SHEET).

AS-BUILT

G.L.O.	REVISED INLET BAFFLE AND PRIMARY SPILLWAY	1-20-06	
J.M.W.	REVISED SPILLWAY FILTER	2-17-95	
J.M.W.	ADDED "USES" GUIDE	5-14-93	
R.M.D.	GEN. REVISION	6- 2 89	
J.M.W.	DELETED TYPE 2	4- 6-89	
J.M.W.	REVISED SEDIMENT	11-19-73	
BY	REVISION	DATE	

DEPARTMENT OF TRANSPORTATION
STATE OF GEORGIA

INLET BAFFLE
PRIMARY SPILLWAY TYPE - I

J.M.W.
J.L.P.

NUMBER
D-21