STATE	PROJECT NUMBER	SHEET NO.	TOTAL SHEETS
GA.		831	839

TYPICAL LOCATIONS IN DITCHES

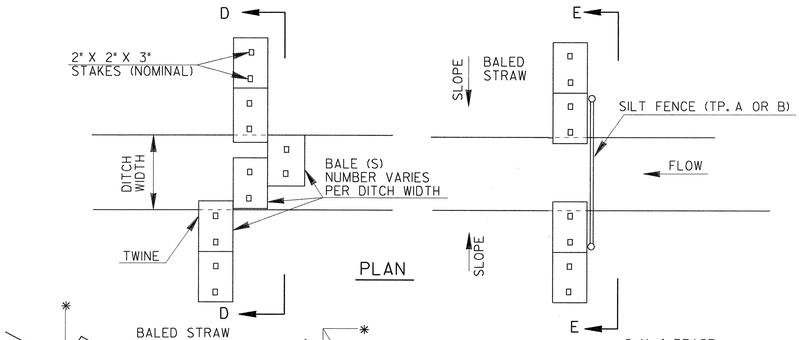

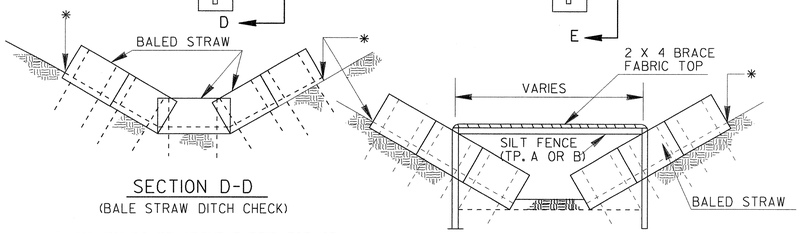

SECTION D-D
(BALE STRAW DITCH CHECK)

*-ELEVATION TO BE ABOVE FABRIC TOP OR BALE TOP IN DITCH CENTER.

SECTION E-E
(SILT FENCE DITCH CHECK)

NOTE:
BALED STRAW DITCH CHECKS ARE FOR USE ON GRADES OF 1PERCENT OR LESS AT SPACINGS OF 100 FEET + -.

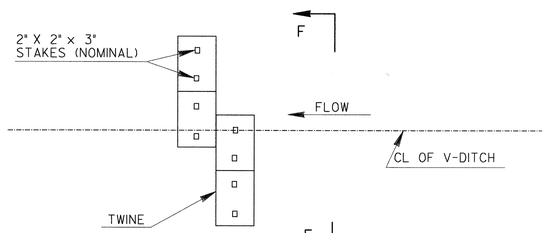

PLAN

NOTE:
EMBED BALES 4" TO 6.

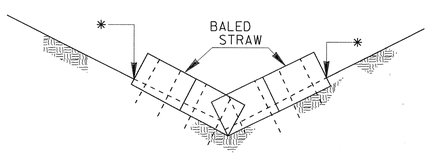

SECTION F-F

TYPICAL LOCATIONS AT TOE OF SLOPES

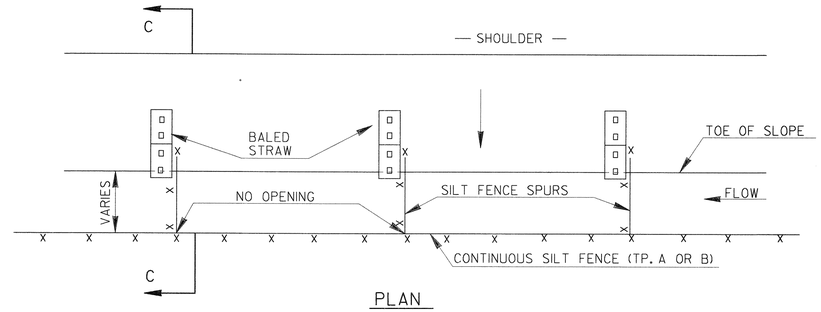

PLAN

NOTE:
EMBED BALES 4" TO 6".

GRADE OF DITCH OR SLOPE	TYPE OF SILT FENCE	SPACING (METERS)
LESS THAN 1%	TYPE B	100' +-
1% TO 2%	TYPE A	100' +-
2% TO 3%	TYPE A	50' +-
3% TO 4%	TYPE C	50' +-
4% TO 5%	TYPE C	25' +-

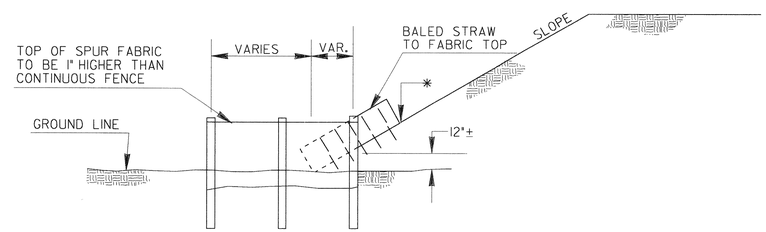

SECTION C-C

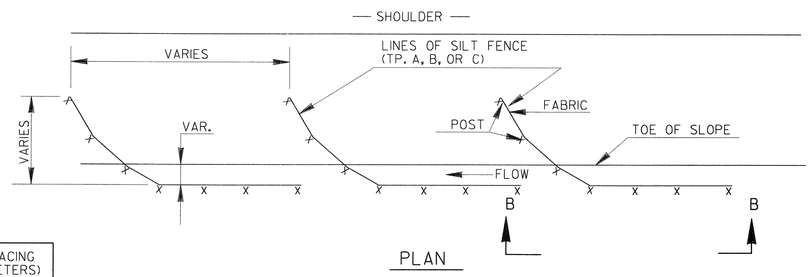

PLAN

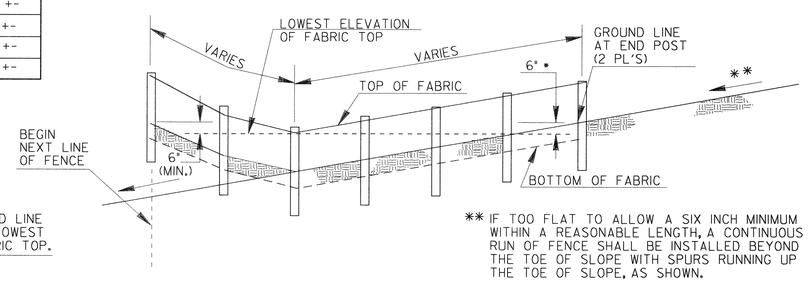

** IF TOO FLAT TO ALLOW A SIX INCH MINIMUM WITHIN A REASONABLE LENGTH, A CONTINUOUS RUN OF FENCE SHALL BE INSTALLED BEYOND THE TOE OF SLOPE WITH SPURS RUNNING UP THE TOE OF SLOPE, AS SHOWN.

SECTION B-B

TYPICAL LOCATION AROUND DROP INLETS

ALT. TO PREFABRICATED INLET SEDIMENT TRAP FOR AREAS WITH SLOPES ≤ 5%

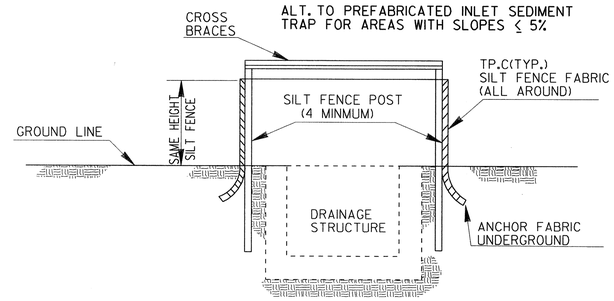

ELEVATION

CROSS BRACES:

TWO - 2 X 4's WITH ENDS TO FIT POST, PROVIDING STURDY SUPPORT, OR AN APPROVED ALTERNATE

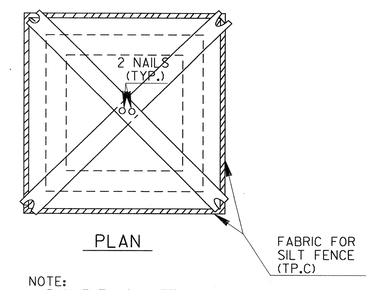

PLAN

NOTE:
PAYMENT AS INLET SEDIMENT TRAP PER EACH.

NOTE:

SEE SEPARATE SHEET ENTITLED "TEMPORARY SILT FENCE, BALED STRAW EROSION CHECK, BRUSH BARRIER DETAILS" FOR BALED STRAW AT TOE OF SLOPE, FOR SILT FENCE ERECTION DETAILS, OR FOR BRUSH BARRIERS, WHERE REQUIRED.

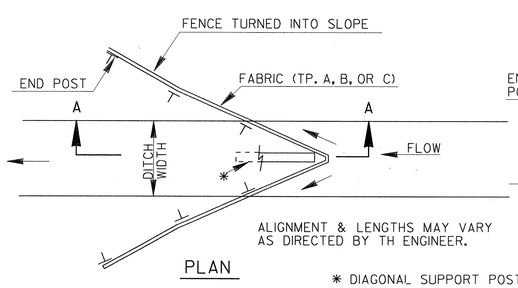

ALIGNMENT & LENGTHS MAY VARY AS DIRECTED BY TH ENGINEER.

PLAN

* DIAGONAL SUPPORT POST

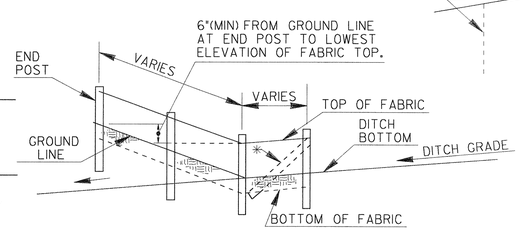

SECTION A-A

MGR	REV. SILT FENCE REQ.	10-22-02
RMU	REV. & REDR.	9-01
J.M.W.	ADD "USES" GUIDE	5-14-93
BY	REVISION	DATE

CONSTRUCTION DETAILS

TYPICAL LOCATION DETAILS FOR SILT FENCES / BALED STRAW

(SHEET 2 OF 2)
NO SCALE

AUGUST 1989

D-24(b)

AS-BUILT