Mon Jun 28 13:26:08 1993 600 BPR-02 DIRDDAD streamprf

STATE	PROJECT NUMBER	SHEET NO.	TOTAL SHEETS
GA.		833	839

AS-BUILT

TEMPORARY DIVERSION CHANNEL PLASTIC LINING

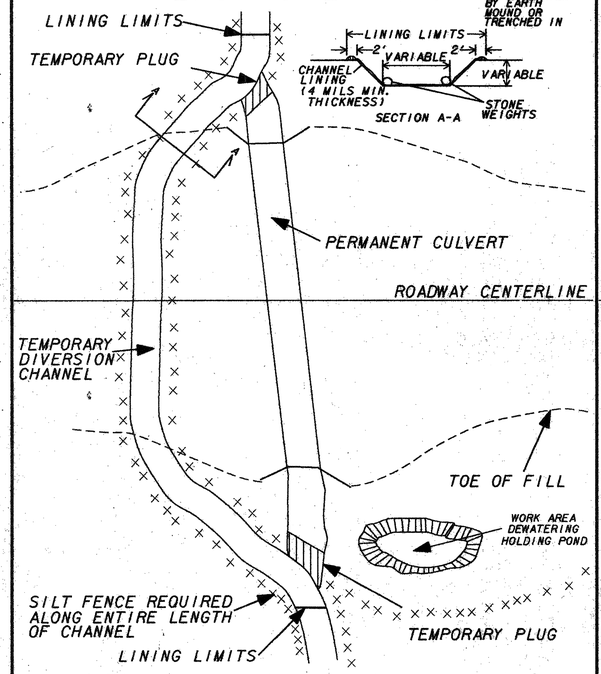

CULVERT CONSTRUCTED OUTSIDE EXISTING STREAM

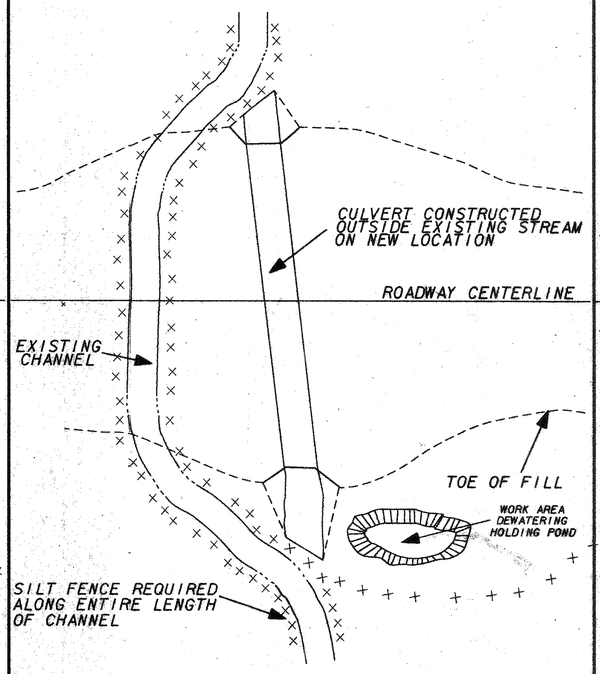

TEMPORARY CULVERT FOR STREAM DIVERSION

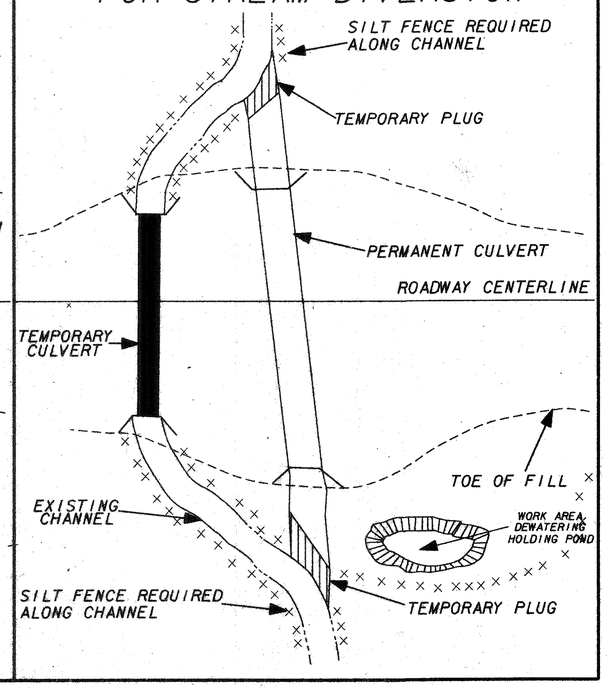

PIPE OR BOX CULVERT EXTENSION

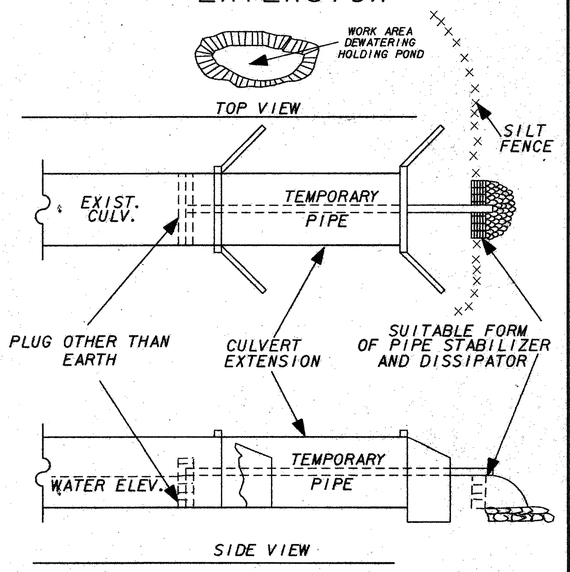

1. THESE DETAILS ARE NOT CONSTRUCTION DRAWINGS. THEY ARE ROUGH SKETCHES OF IDEAS. ALTERNATES MAY BE SUBMITTED BY THE CONTRACTOR IN THE EROSION CONTROL PLAN.
2. DIVERSION CHANNELS TO BE INCLUDED IN THE COST OF CULVERT. WHEN REQUIRED.
3. THE PLASTIC LINING SHALL BE PVC OR PE MATERIAL WITH A MINIMUM THICKNESS OF 6 MILS.
4. THE LAP OF THE SHEETS OF PLASTIC LINING SHALL BE A MINIMUM OF 2 FEET.
5. THE DIVERSION CHANNEL SHOULD BE THE SAME WIDTH AND DEPTH AS THE EXISTING CHANNEL.

BY	DATE	REVISION
M.W.	JUNE 28, 1993	
M.W.	MAY 14, 1993	
M.W.	OCTOBER 23, 1992	
M.W.	JUNE 28, 1989	

GEORGIA DEPARTMENT OF TRANSPORTATION

EXAMPLES OF DIVERSION CHANNELS

D-38