TIME STAMP: 05-AUG-2009 11:35 PLOTTED BY: DTMcIntosh	PLOT NAME: 008274XS0121 PEN TABLE: 8825Full.pen	DGN NAME: R:\AT740001\dgn\008274XS01.dgn DGN LEVELS: [1-64]	SCALE:	REVISION DATES 6/10/08	COUNTY HENRY	PROJECT NUMBER CSNHS-0008-00(274)	SHEET NO. 63	TOTAL SHEETS 149

6/10/08 - NOISE WALL 'A' REVISED PER NOISE WALL SHOP DRAWINGS

SHEET NO.

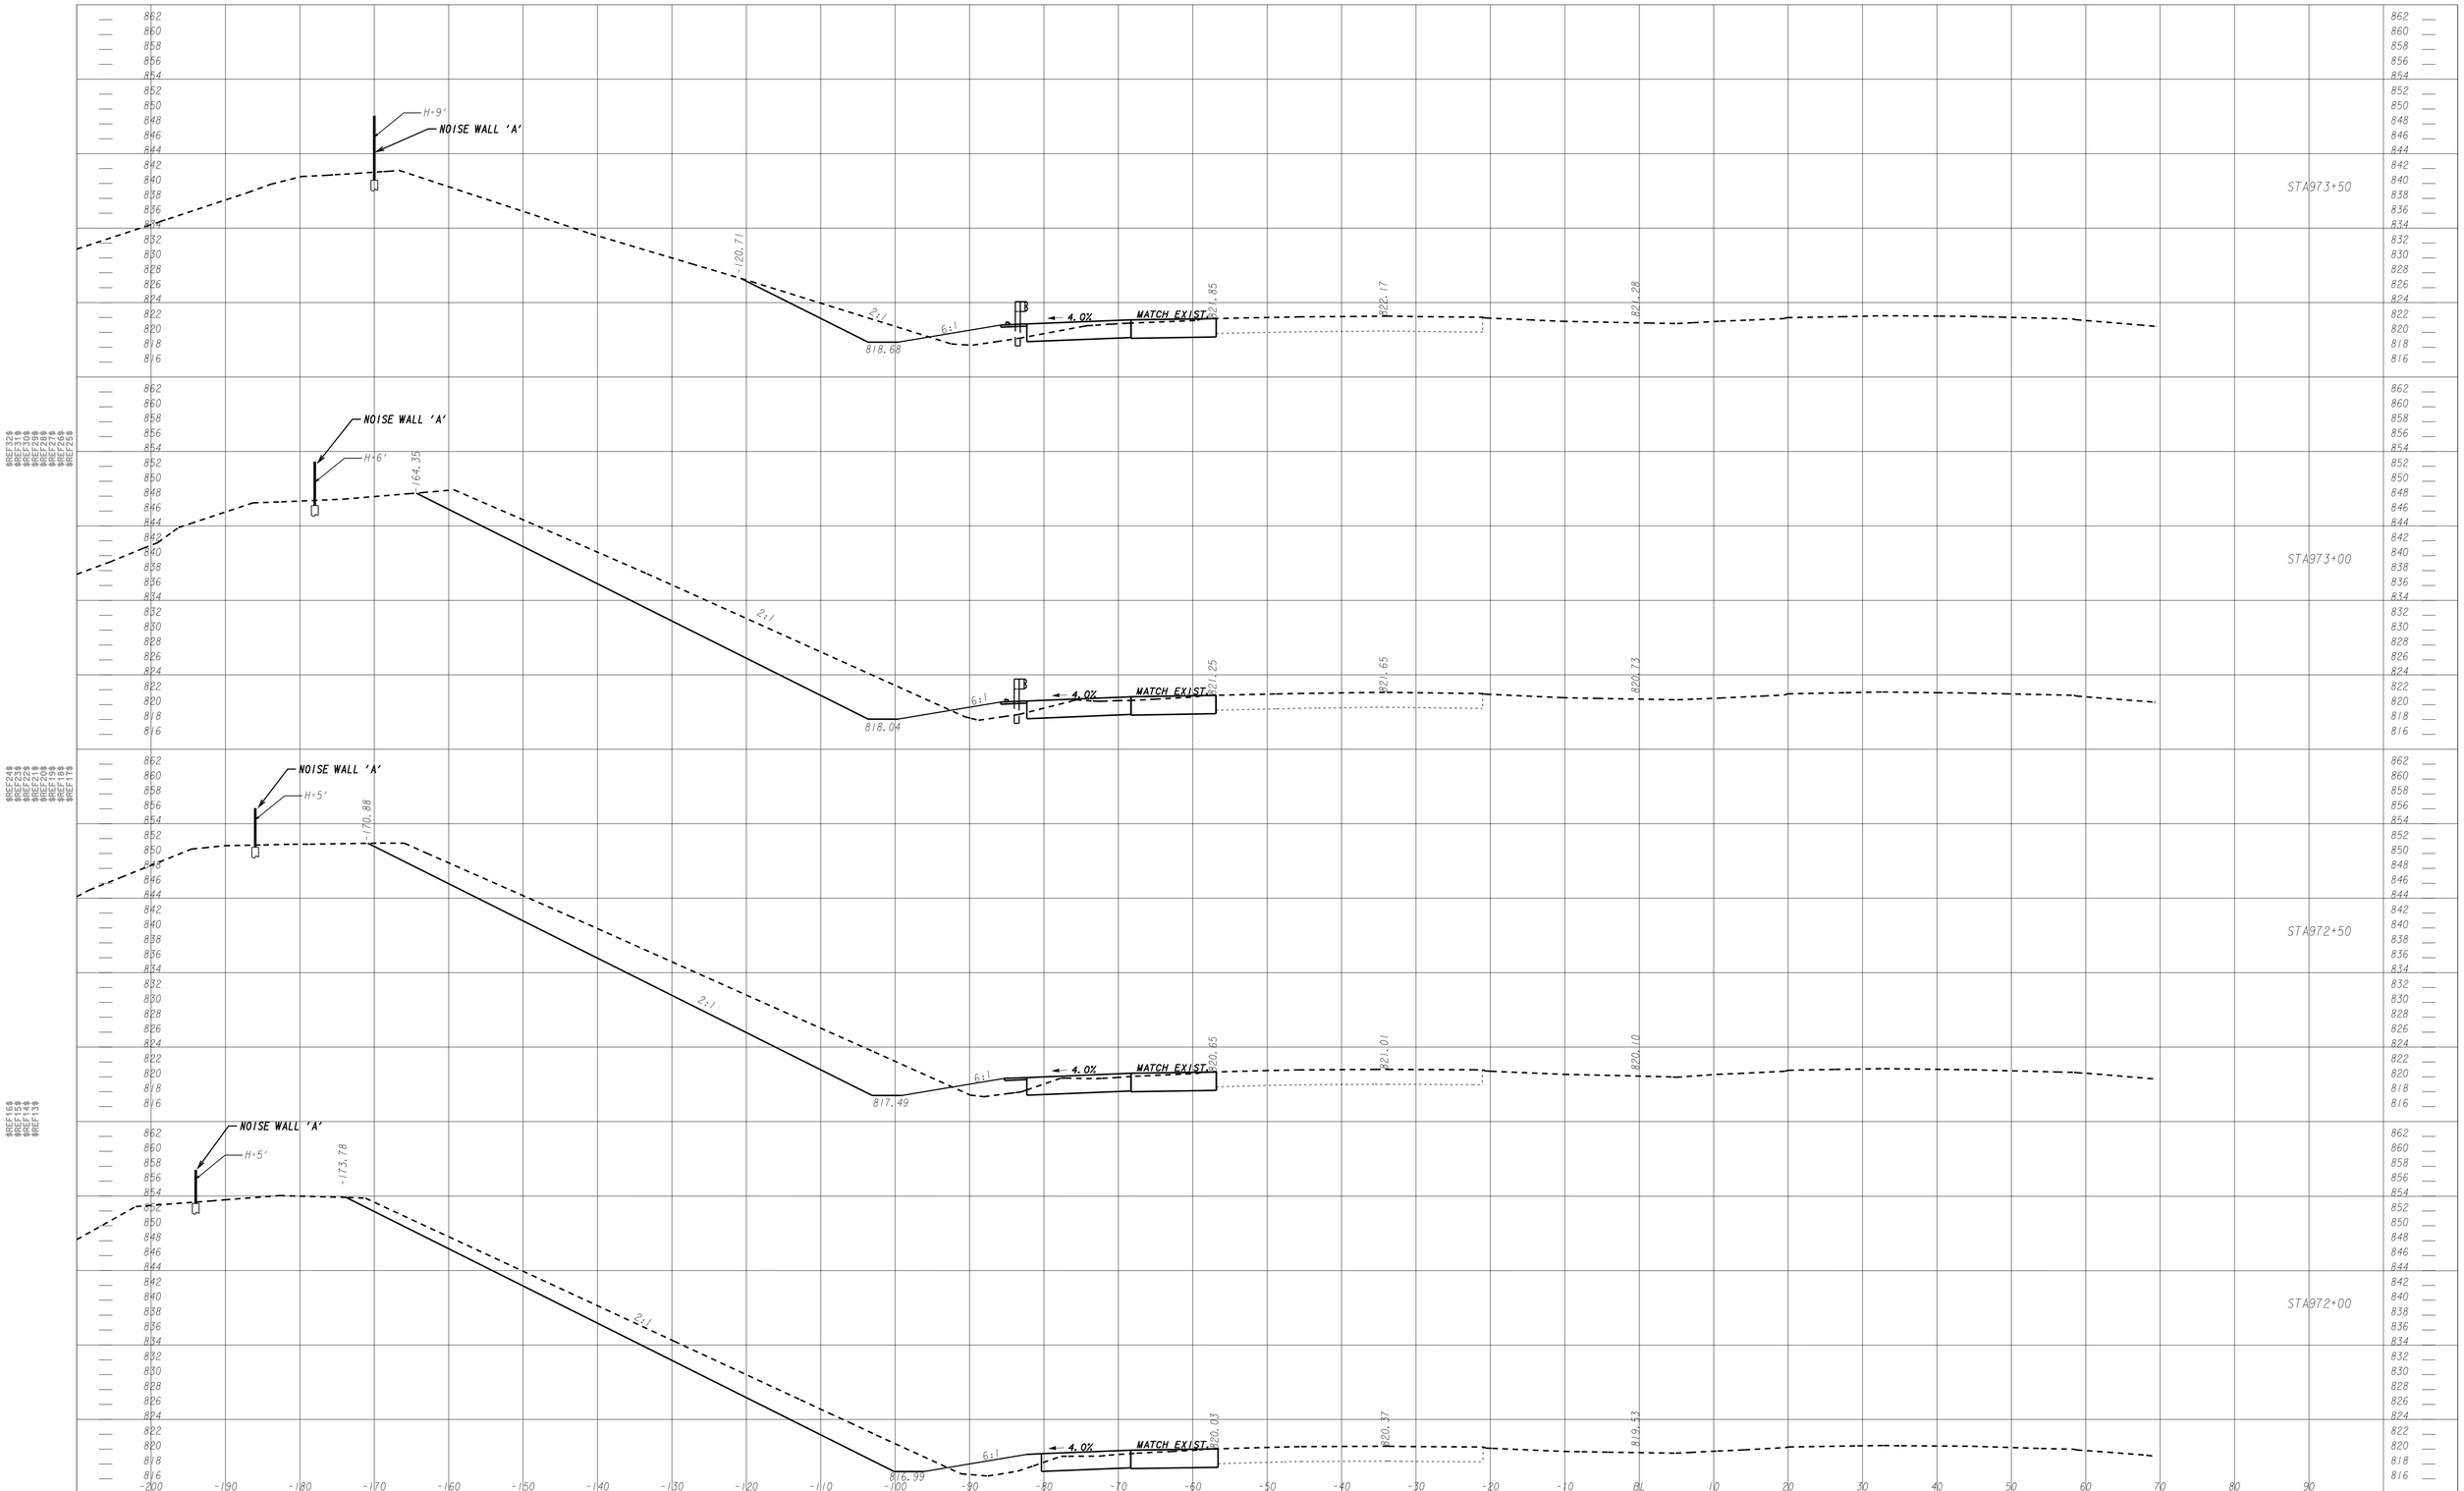

THE LPA GROUP

TRANSPORTATION CONSULTANTS
3595 ENGINEERING DRIVE
NORCROSS, GEORGIA 30092
(770) 263-9118

SCALE 1 Inch = 10 feet Vert.
SCALE 1 Inch = 10 feet Horiz.

STATE OF GEORGIA
DEPARTMENT OF TRANSPORTATION
OFFICE OF URBAN DESIGN

MAINLINE CROSS-SECTIONS

DRAWING No.
23-22