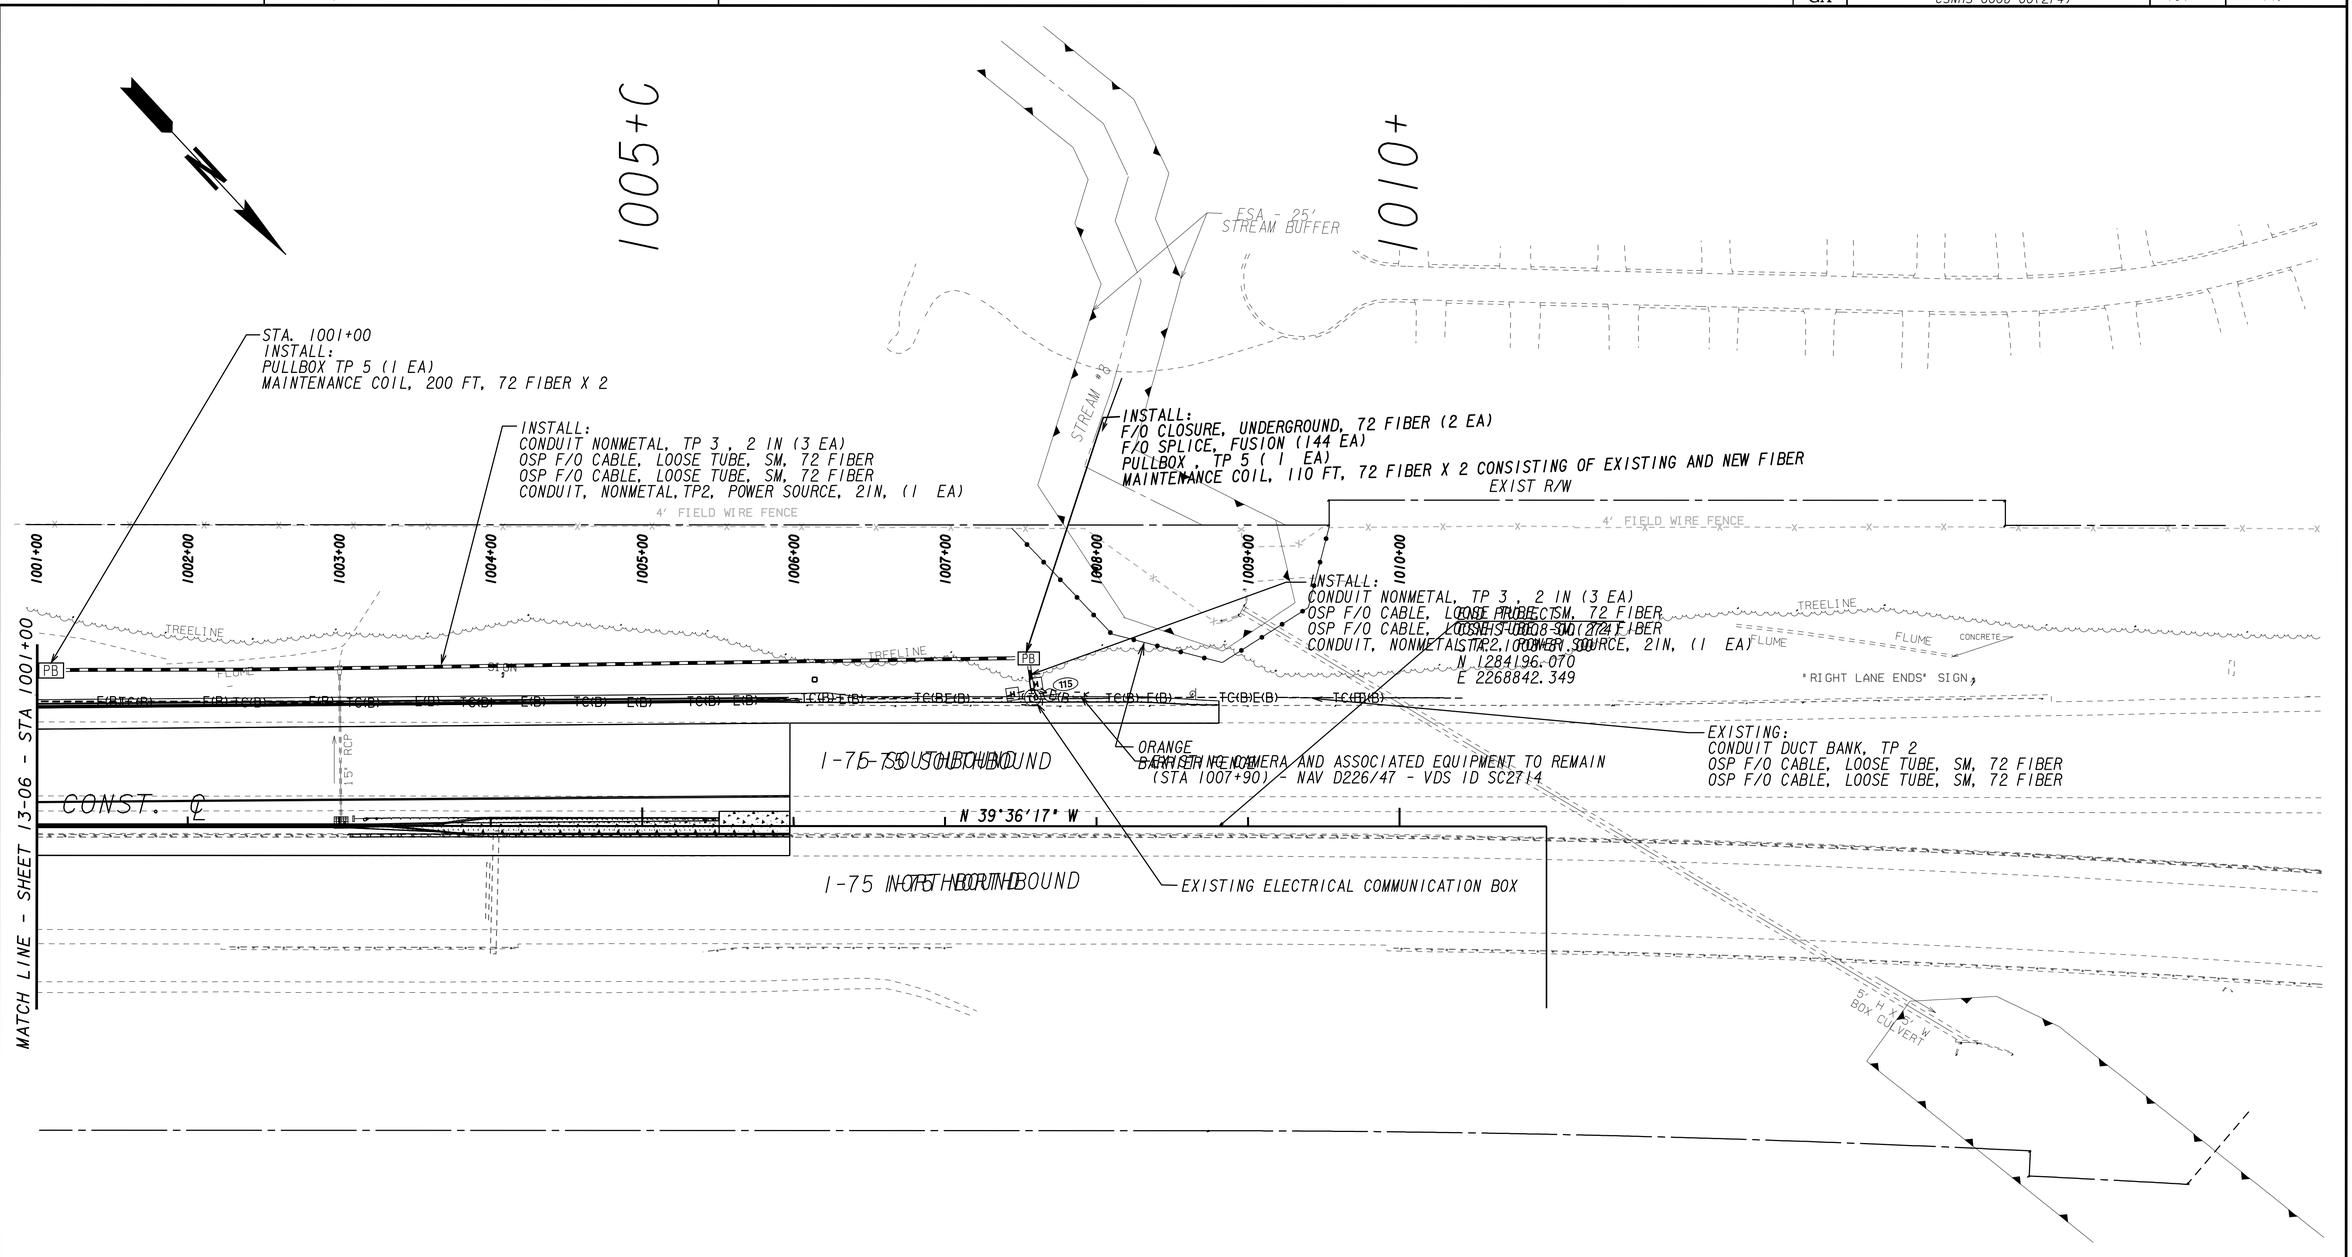

REVISION NOTE: MAINTENANCE COIL AT SPLICE POINT CHANGED TO 110 FEET CONSISTING OF EXISTING AND NEW FIBER.

REQUIRED R/W LINE	
CONSTRUCTION LIMITS	--℄--F--
EASEMENT FOR CONSTR & MAINTENANCE OF SLOPES	
EASEMENT FOR CONSTR OF SLOPES	
EASEMENT FOR CONSTR OF DRIVES	
PROPERTY AND EXISTING R/W LINE	P E
BEGIN LIMIT OF ACCESS	BLA
END LIMIT OF ACCESS	ELA
LIMIT OF ACCESS	
R/W AND LIMIT OF ACCESS	
HISTORICAL BOUNDARY	

A&R Engineering, Inc.
2160 Kingston Court, Suite O
Marietta, GA 30067
Tel: (770) 690-9255 Fax: (770) 690-9210
www.arengineering.com

SCALE IN FEET
0 50 100 200

REVISION DATES		
09-05-08		

STATE OF GEORGIA
DEPARTMENT OF TRANSPORTATION
OFFICE OF TRAFFIC OPERATIONS

ITS PLAN

CSNHS-0008-00(274)
COUNTY - HENRY
DATE - 2/28/08

DRAWING No. 28-07

3/1/2007 GPLN