STATE	PROJECT NUMBER	SHEET NO.	TOTAL SHEETS
GA	CSNHS-0008-00(415)	83	472

RELEASED FOR CONSTRUCTION 11/04/09

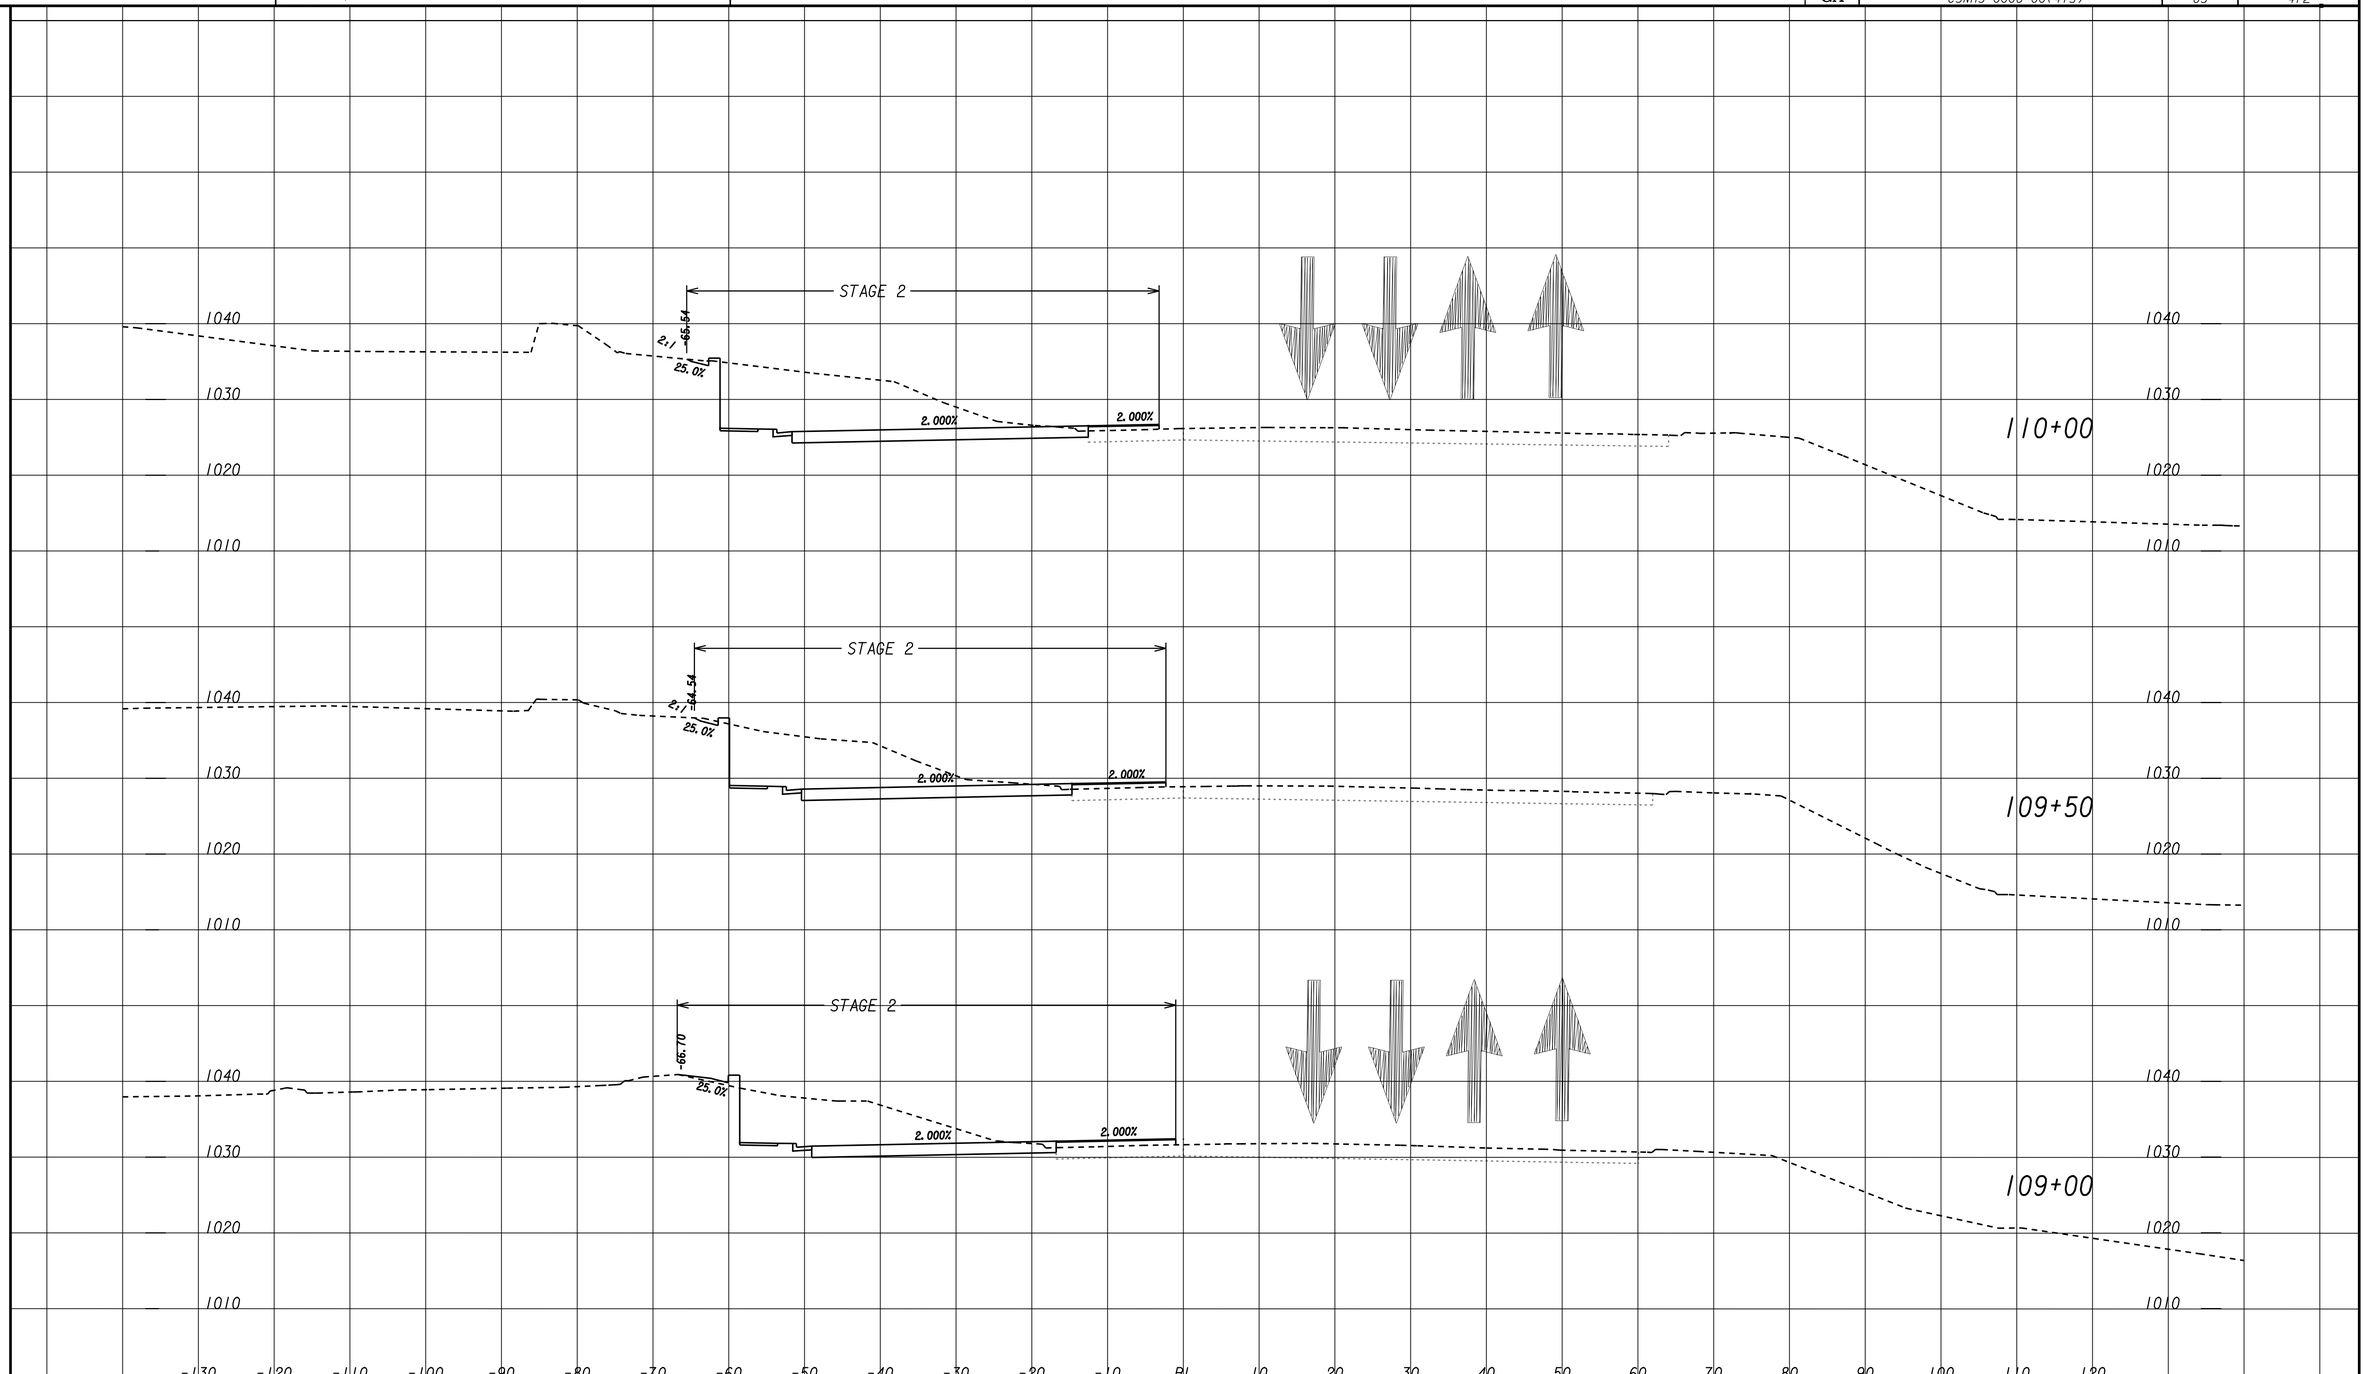

THE LPA GROUP
TRANSPORTATION CONSULTANTS
3595 ENGINEERING DRIVE
NORCROSS, GEORGIA 30092
(770) 263-9118

SCALE 1 inch = 10 feet Vert.
SCALE 1 inch = 10 feet Horiz.

REVISION DATES

STATE OF GEORGIA
DEPARTMENT OF TRANSPORTATION
OFFICE: INNOVATIVE PROGRAM DELIVERY

CROSS SECTIONS CONSTRUCTION STAGING

HAMMOND DRIVE
STAGE 2

DRAWING No. 19-26

3/1/2007 SUXSEW