STATE	PROJECT NUMBER	SHEET NO.	TOTAL SHEETS
GA.			

RELEASED FOR CONSTRUCTION 11/04/09

SHEET NO. 330 OF 472

Y:\Roadways\ATT40002\008415\Dgn\Const Details\A-2.dgnA-2 JParks 11/2/2011 8:22:53 AM

DETAIL OF 6" OR 8" CONCRETE VALLEY GUTTER WITH CURB

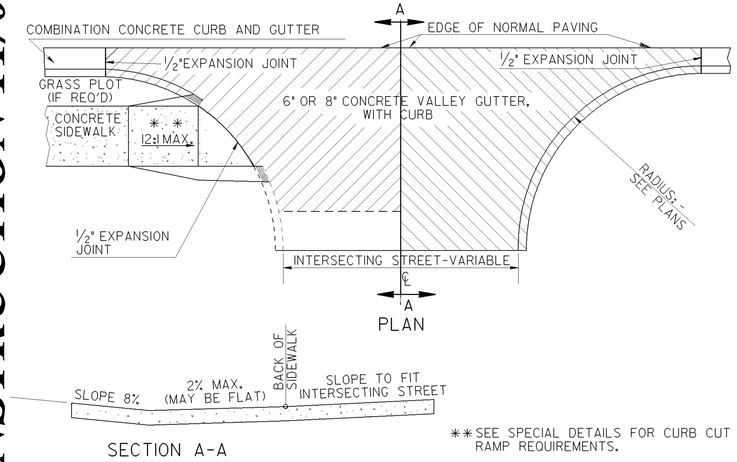

**SEE SPECIAL DETAILS FOR CURB CUT RAMP REQUIREMENTS.

DETAIL OF PLACING PAVEMENT ADJACENT TO GUTTER

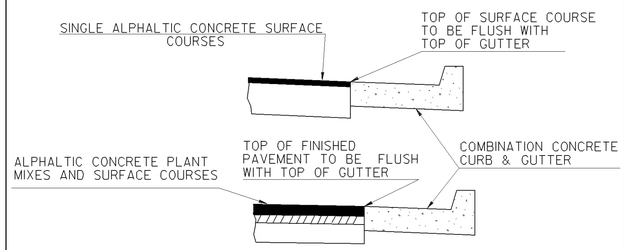

DETAIL OF ADDITIONAL PAVING AT STREET INTERSECTION

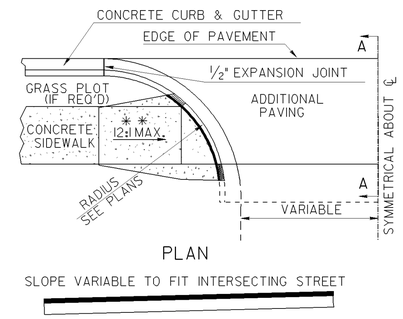

NOTE:
ADDITIONAL PAVING TO EXTEND TO END OF RETURN WHEN NO CONCRETE SIDEWALK IS SET UP.

**SEE SPECIAL DETAILS FOR CURB CUT RAMP REQUIREMENTS.

DETAIL OF 6" OR 8" CONCRETE VALLEY GUTTER WITHOUT CURB

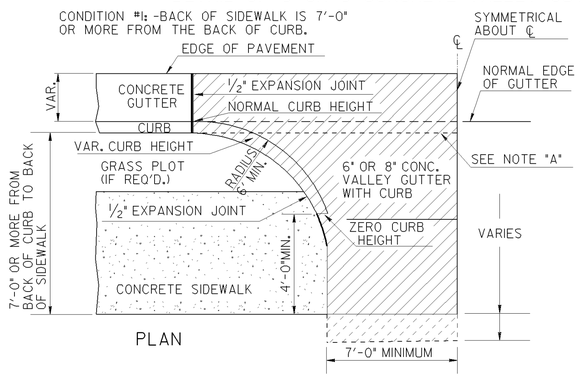

CONDITION #1-BACK OF SIDEWALK IS 7'-0" OR MORE FROM BACK OF CURB.

ZERO CURB HT. TO BE A MINIMUM OF 3'-2" FROM GUTTER LINE. IF CURB TRANSITION EXTENDS PAST EDGE OF SIDEWALK. THE TOP OF THE VARIABLE HEIGHT CURB IS TO REMAIN FLUSH WITH THE TOP OF THE SIDEWALK THROUGHT OUT TRANSITION. ZERO CURB HEIGHT WILL BE A MINIMUM OF 4'-0" FROM BACK OF SIDEWALK.

NOTE: "A"
CONSTRUCTION JOINT OPTIONAL: -WHEN IMPLEMENTED #4 TIE BARS WILL BE REQUIRED AS SHOWN BELOW TO BE INCLUDED IN UNIT PRICE FOR VALLEY GUTTER. IF CURB IS POURED THROUGH VALLEY GUTTER, THE TOP PORTION WILL BE REMOVED BEFORE SETTING TO MATCH GRADE OF VALLEY GUTTER.

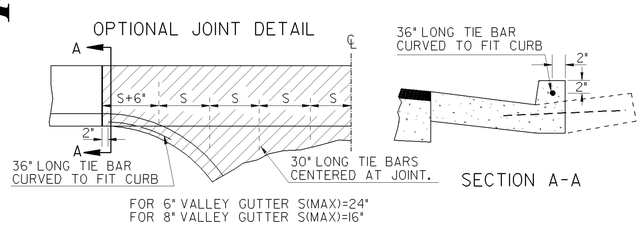

FOR 6" VALLEY GUTTER S(MAX)=24"
FOR 8" VALLEY GUTTER S(MAX)=16"

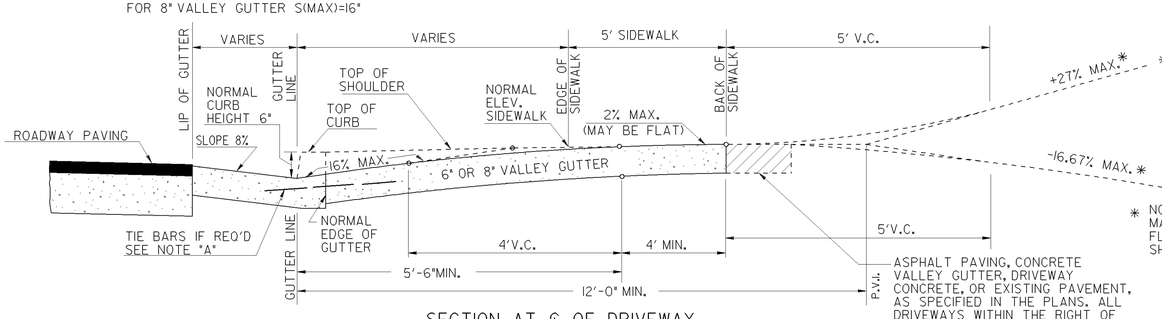

*PERCENTAGE OF ASCENDING GRADE MAY BE INCREASED AT A DISTANCE OF 23' FROM THE GUTTER LINE.

*PERCENTAGE DESCENDING GRADE MAY BE INCREASED AT A DISTANCE 18' FROM THE GUTTER LINE.

* NOTE:
MAXIMUM DRIVEWAY GRADES SHOWN ABOVE ARE INTENDED FOR RESIDENTIAL DRIVEWAYS WHERE FLATTER GRADES ARE NOT FEASIBLE. GRADES FOR COMMERCIAL DRIVEWAYS OR FOR TRUCKS SHALL NOT BE GREATER THAN 11% UNLESS SPECIFIED OTHERWISE.

ASPHALT PAVING, CONCRETE VALLEY GUTTER, DRIVEWAY CONCRETE, OR EXISTING PAVEMENT, AS SPECIFIED IN THE PLANS. ALL DRIVEWAYS WITHIN THE RIGHT OF WAY SHALL BE PAVED.

DETAIL OF 4' CORRUGATED CONCRETE MEDIAN

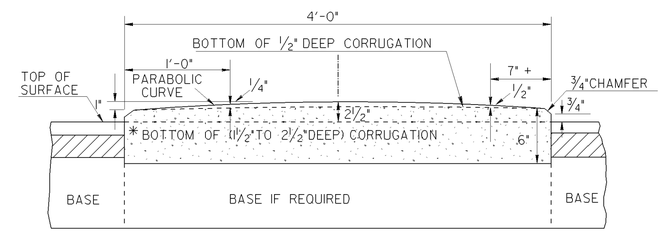

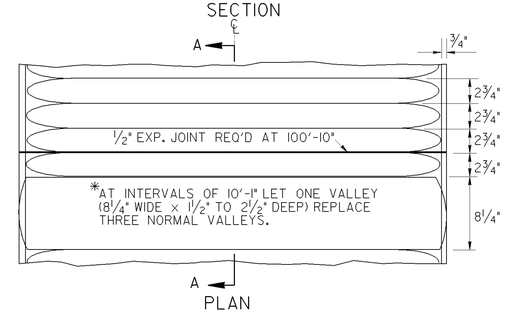

*APPLIES ONLY TO SUPERELEVATED CURVES, INCLUDING TRANSITIONS.

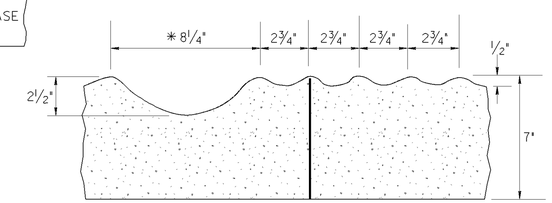

SEE SPECIAL DETAILS FOR DETAILS OF CONCRETE SIDEWALK.

This Detail Replaces Ga Standard 9031J

Guidelines For Usage On Metric Projects

When these details are incorporated into plans and or projects that are being prepared or constructed in metric units, exact or precise conversion to metric units is not required. The dimensions shown that are in feet and inches may be converted to corresponding metric units using the following "Rounded-Off" conversion factors: 1" =25mm, 4"=100mm, and 12" or 1' =300mm. All measurement notes that refer to linear feet and square yards shall be interpreted to mean linear meters and square meters.

BY	REVISION	DATE
GLO	ADDED PAVEMENT NOTE, REV. DRIVEWAY SECTION	7-21-11
GLO	REV. PAVEMENT NOTES	2-21-03
	REVISED	4-11-02
	REVISED	4-3-02

DEPARTMENT OF TRANSPORTATION
STATE OF GEORGIA

CONSTRUCTION DETAIL

CONCRETE VALLEY GUTTER AT STREET INTERSECTION
6" OR 8" CONCRETE VALLEY GUTTER AT DRIVE
PLACING PAVEMENT ADJACENT TO GUTTER
ADDITIONAL PAVING AT STREET INTERSECTION
4' CORRUGATED CONCRETE MEDIAN

NO SCALE — MARCH 12, 2002

NUMBER A2