VOID

RELEASED FOR CONSTRUCTION - 07-23-13

STAGE 3

1. MAINTAIN TRAFFIC ON NEWLY CONSTRUCTED SOUTH SIDE OF BOURNE AVENUE.
2. CONSTRUCT NORTH SIDE OF PROPOSED BOURNE AVENUE.
3. RAISED CONCRETE MEDIANS (INTEGRAL) ALONG SR307/BOURNE AVENUE ARE TO BE CONSTRUCTED ONCE STAGE 3 CONSTRUCTION IS COMPLETE.
4. CONTRACTOR TO MAINTAIN A 1 FOOT SEPARATION BETWEEN THE WESTBOUND AND EASTBOUND TRAFFIC.

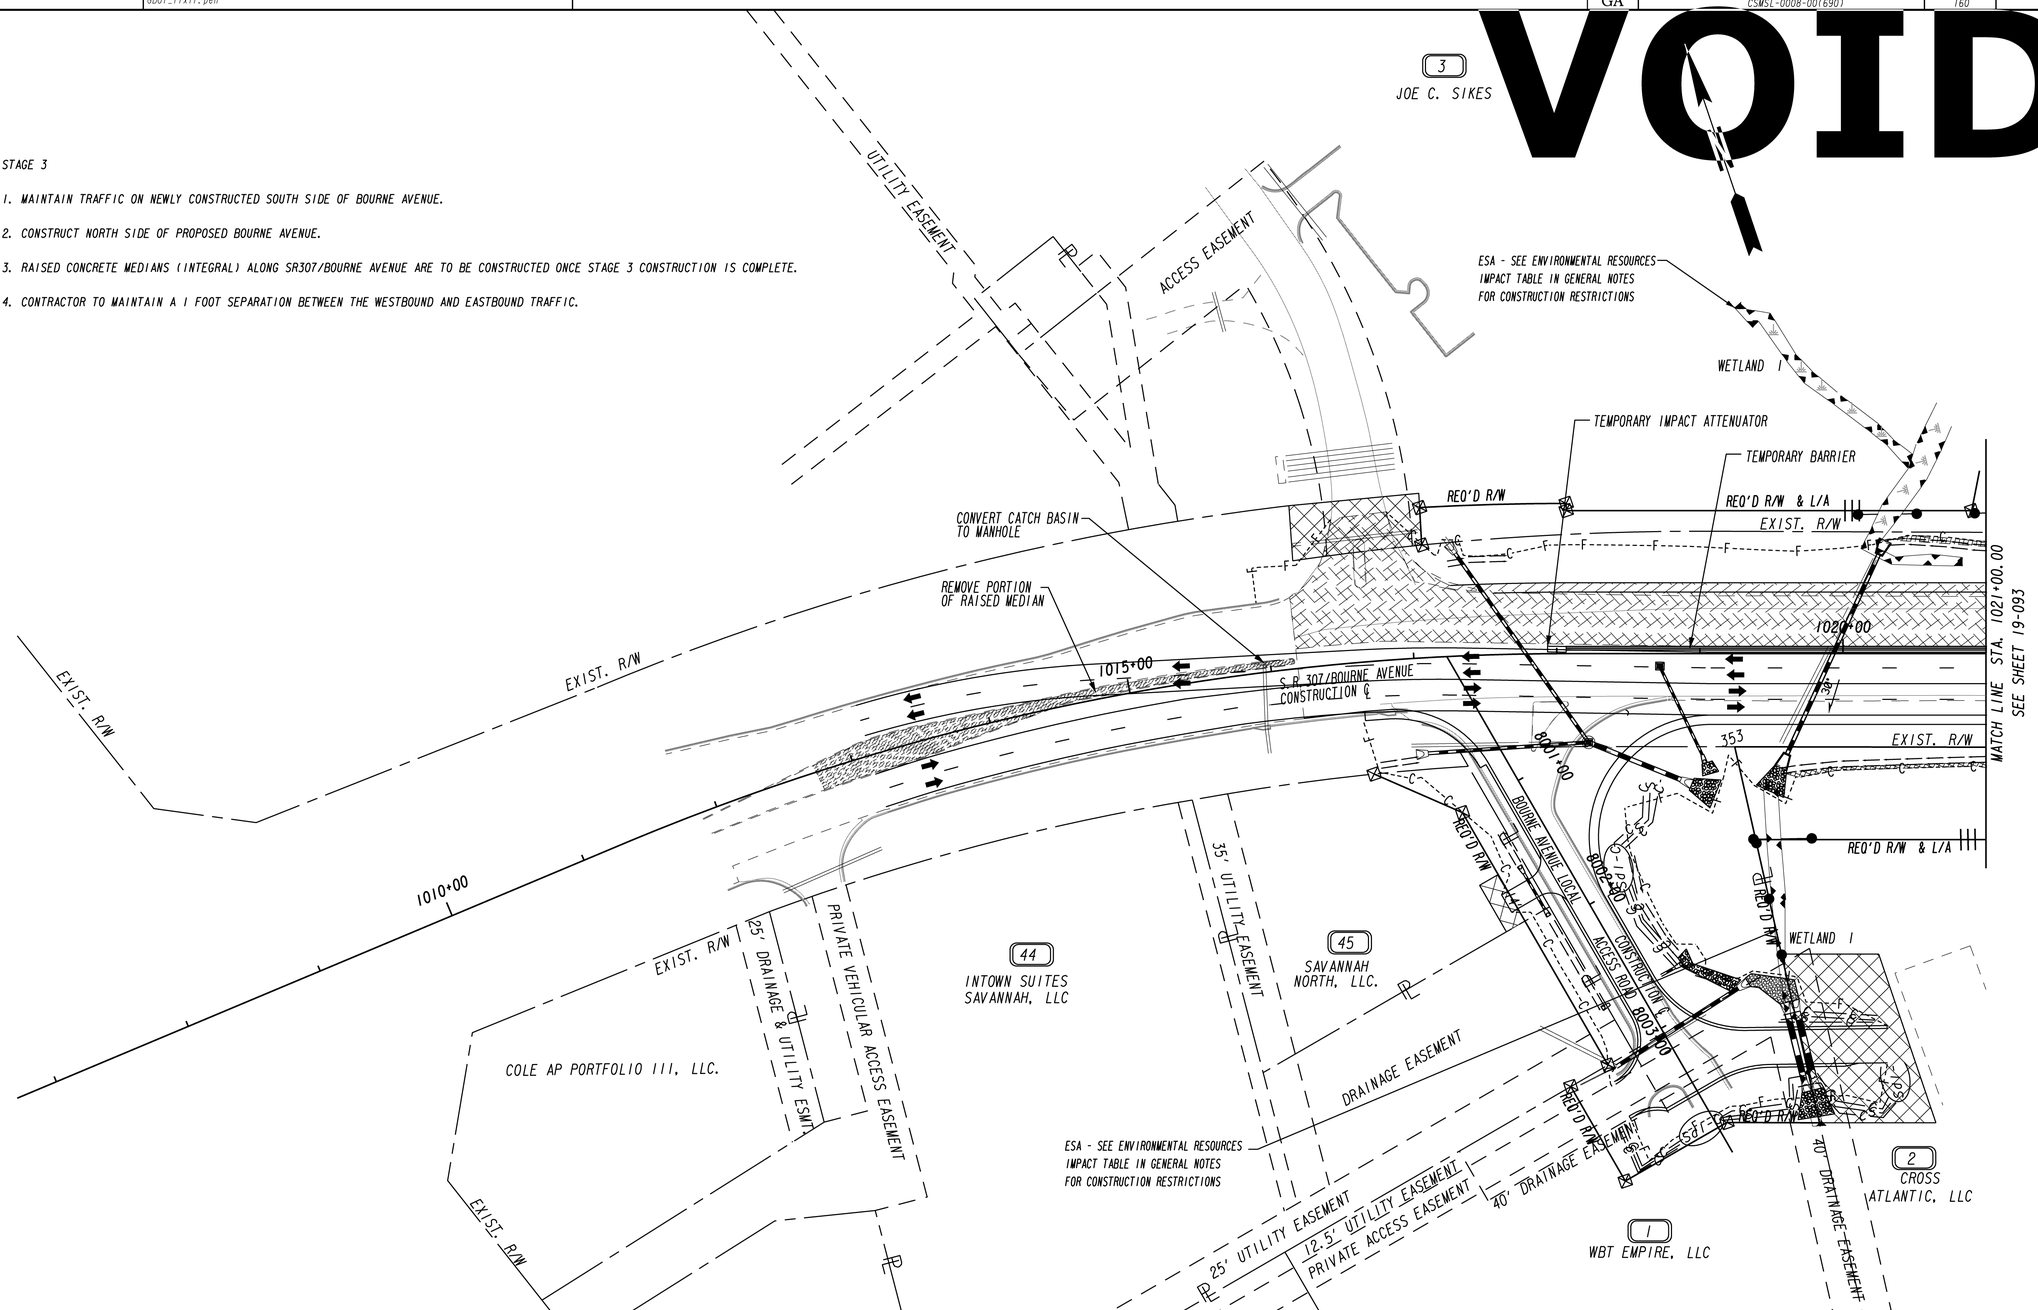

LEGEND

- PAVEMENT REMOVAL
- TEMPORARY CONSTRUCTION PAVEMENT
- PERMANENT CONSTRUCTION
- CONCRETE MEDIAN CONSTRUCTION
- MILL & OVERLAY CONSTRUCTION
- OPEN LANES OF TRAFFIC

STAGE 3

THE LPA GROUP
TRANSPORTATION CONSULTANTS
A UNIT OF MICHAEL BAKER CORPORATION
3595 ENGINEERING DRIVE
NORCROSS, GEORGIA 30092
(770) 263-9118

SCALE IN FEET
0 50 100 200

REVISION DATES

STATE OF GEORGIA
DEPARTMENT OF TRANSPORTATION
OFFICE: INNOVATIVE PROGRAM DELIVERY

CONSTRUCTION STAGING PLAN

STAGE 3 - BEGIN CONST. TO SONNY DIXON INTERCHANGE STA. 1021+00

DRAWING No. 19-092

3/1/2007 GPLN