12/30/2010 10:13:27 AM Plot file
USER: bgc C:\GDOT\GDOTROAD\tables\Gplotborder-utilities-half.tbl

COUNTY	PROJECT NUMBER	SHEET NO.	TOTAL SHEETS
CHATHAM	CSMSL-0008-00(690)		

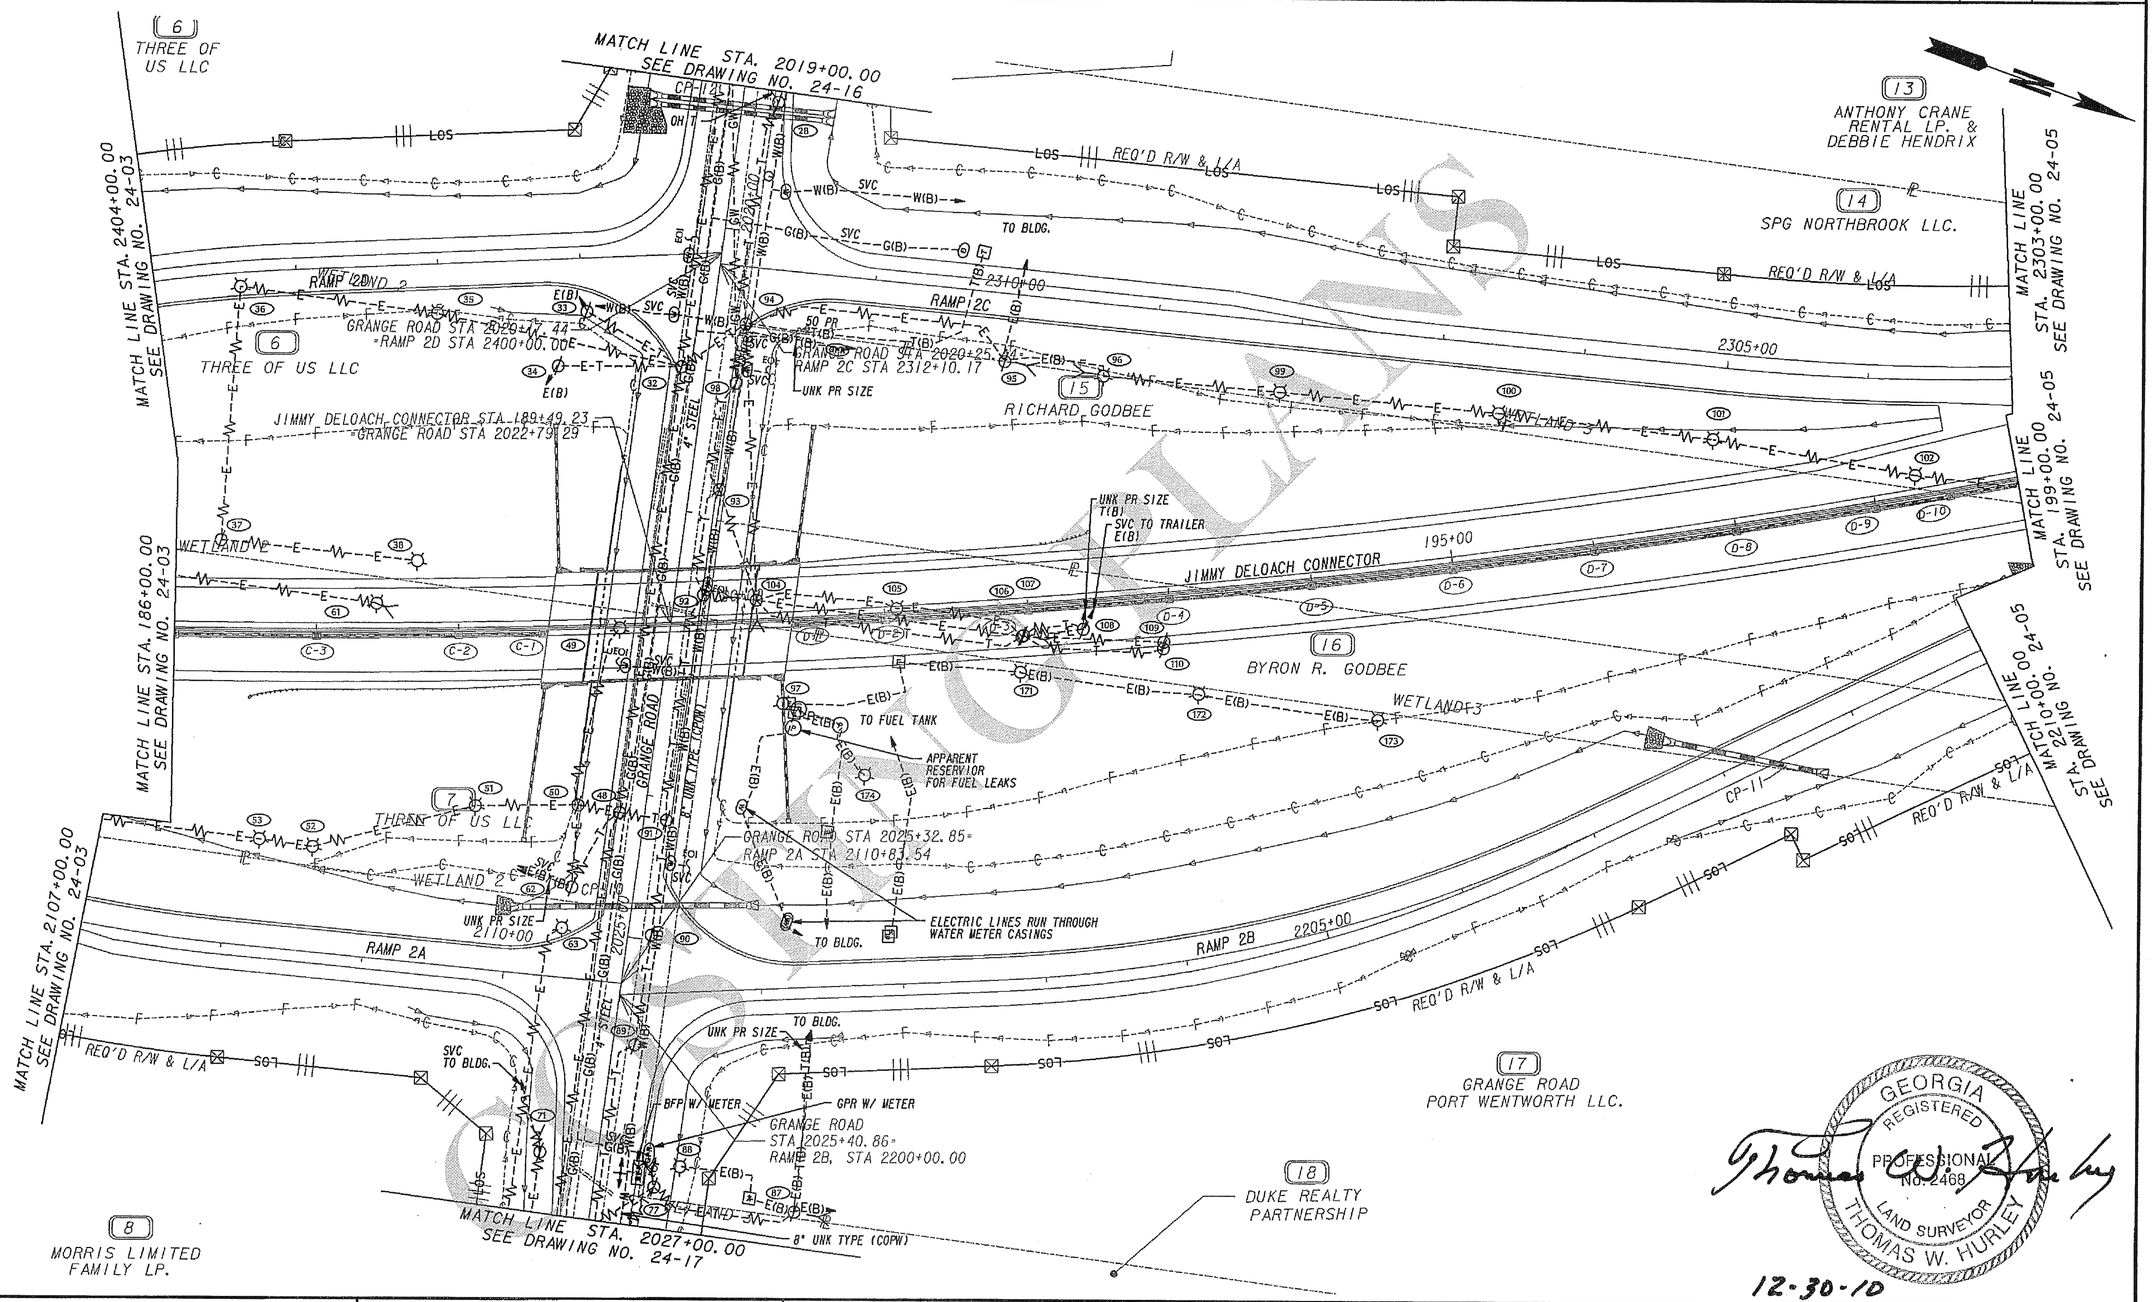

GEORGIA REGISTERED PROFESSIONAL No. 2468 LAND SURVEYOR THOMAS W. HURLEY

12-30-10

PLAN RELEASE			
DRAWN BY	DATE	CHECKED BY	DATE
BGC	10/04/10	BC	12/07/10
BGC	12/07/10	TWH	12/08/10
BGC	12/09/10	RC	12/09/10
BGC	12/13/10	RWS	12/12/10

TBE PROJECT NUMBER
GA-095-007-04

TBE CONTACT
THOMAS W. HURLEY, R. L. S.

TBE GROUP
PEACHTREE CORPORATE CENTER
6649 PEACHTREE INDUSTRIAL BLVD.
SUITE J, NORCROSS GA 30092-4302
TELEPHONE: 678.421.0080

SCALE IN FEET
0 50 100 200

REVISION DATES

STATE OF GEORGIA
DEPARTMENT OF TRANSPORTATION
OFFICE: UTILITIES, JUN BIRNKAMMER, EIT

UTILITY PLANS
JIMMY DELOACH CONNECTOR

P. I. NO. 0008690

DRAWING No. 24-04