AS-BUILT PLANS - 08/30/13

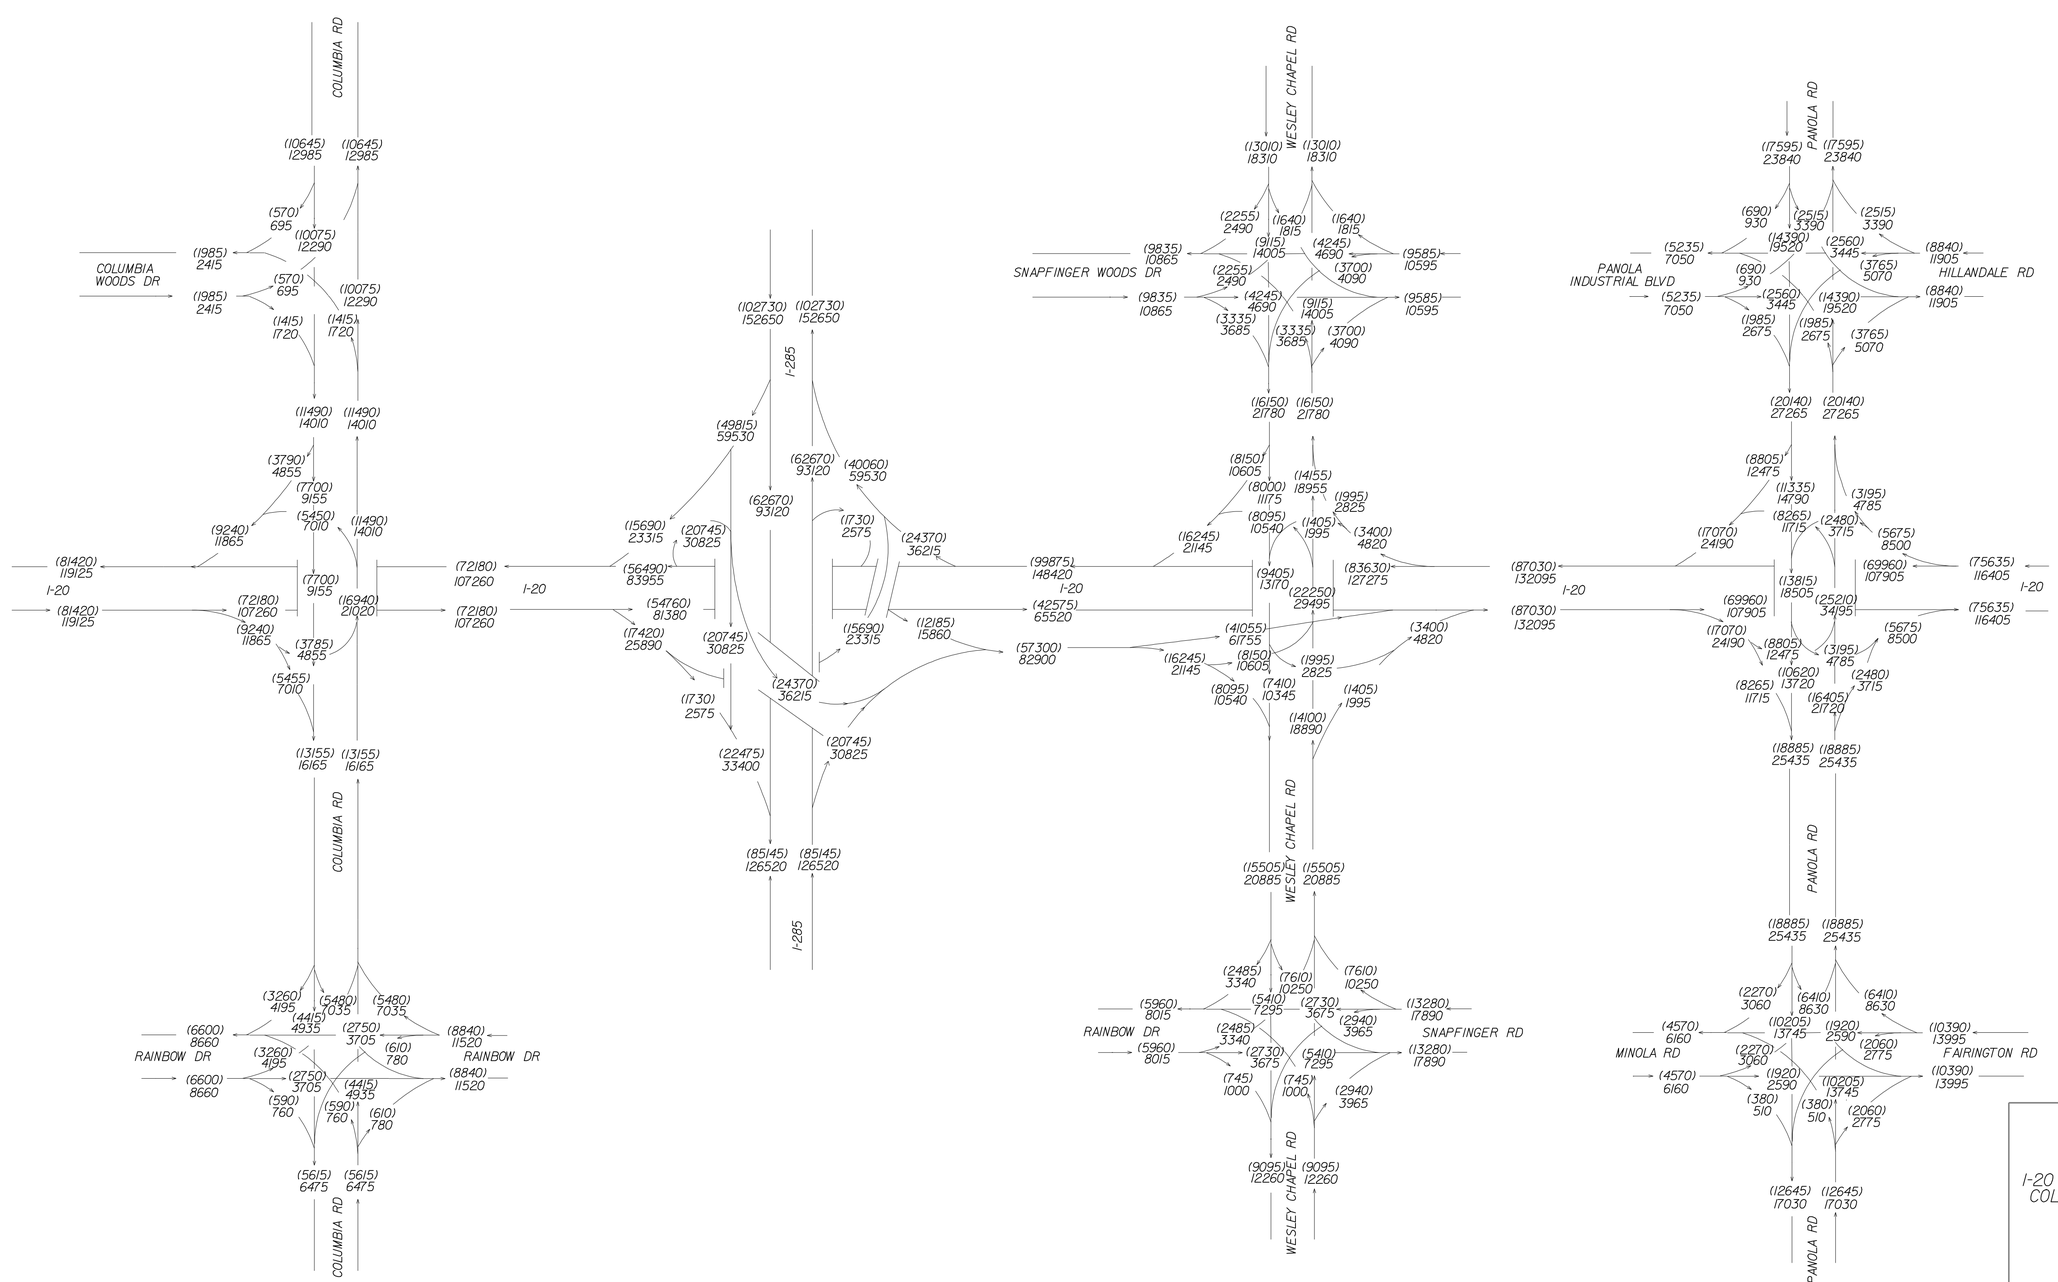

OPEN YEAR (2012) & DESIGN YEAR (2032) ADT - BUILD CONDITIONS

DEKALB COUNTY
PI#0009542

I-20 EB CD FROM WEST OF COLUMBIA RD TO EAST OF PANOLA RD

2012 ADT= (000)
2032 ADT= 000

24 HR T = 18%
S.U.= 8%
COMB.= 10%

ARCADIS
08/2009

THE LPA GROUP
TRANSPORTATION CONSULTANTS
A UNIT OF MICHAEL BAKER CORPORATION
3595 ENGINEERING DRIVE
NORCROSS, GEORGIA 30092
(770) 263-9118

REVISION DATES		

STATE OF GEORGIA
DEPARTMENT OF TRANSPORTATION
OFFICE: INNOVATIVE PROGRAM DELIVERY

TRAFFIC DIAGRAM

I-20 EASTBOUND CD LANES
I-285 TO PANOLA ROAD

DRAWING No. 10-001

1/5/2009 GPLN