AS-BUILT PLANS - 08/30/13

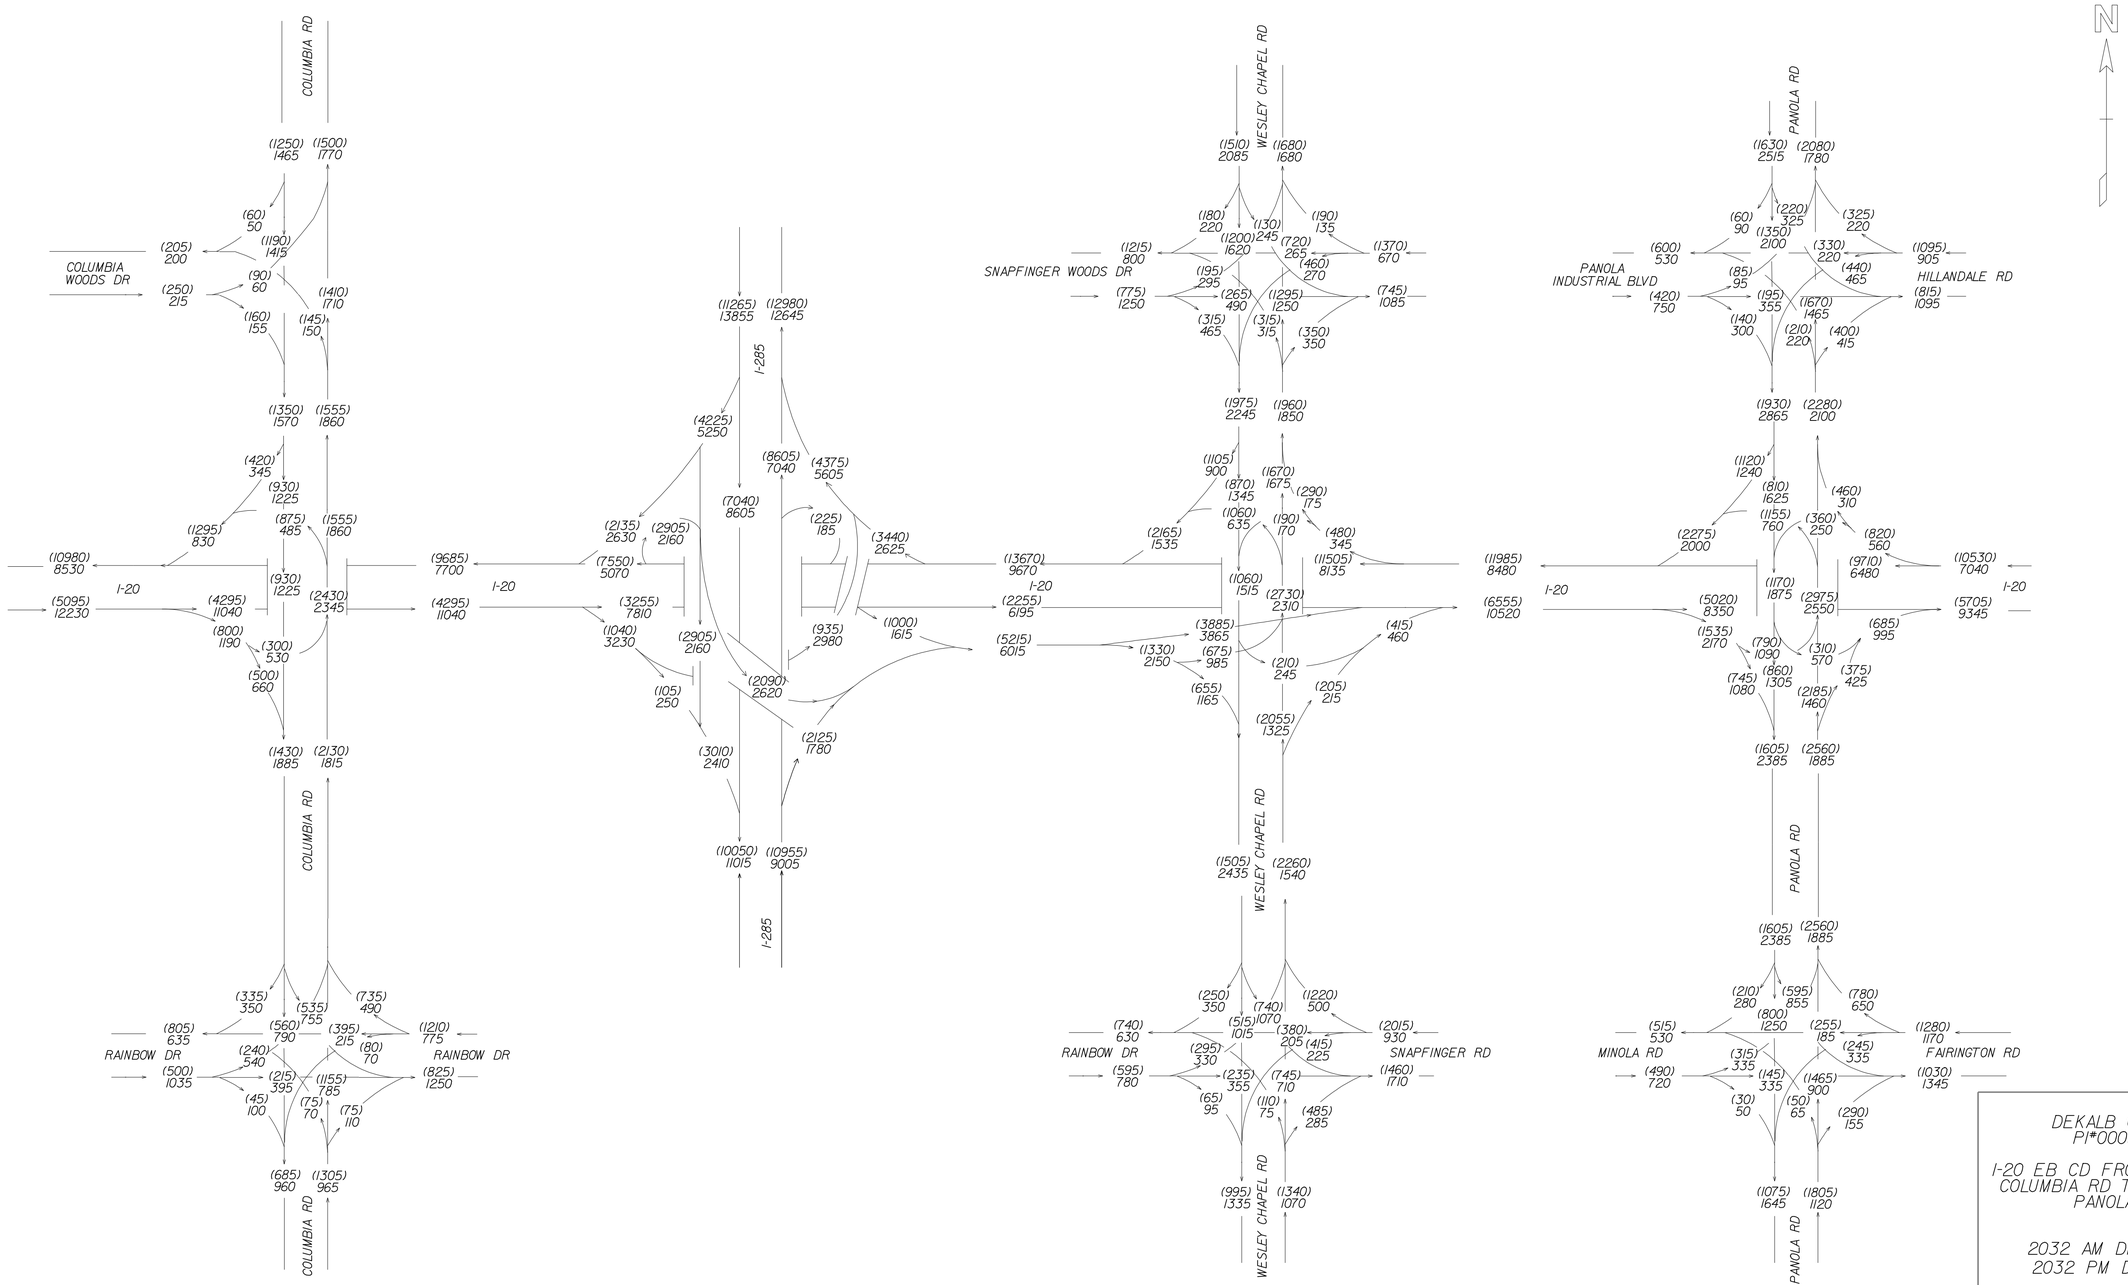

DESIGN YEAR (2032) DESIGN HOURLY VOLUMES - BUILD CONDITIONS

DEKALB COUNTY
PI#0009542

I-20 EB CD FROM WEST OF COLUMBIA RD TO EAST OF PANOLA RD

2032 AM DHV = (000)
2032 PM DHV = 000

T = 9%
S.U. = 4%
COMB. = 5%

ARCADIS
08/2009

THE LPA GROUP
TRANSPORTATION CONSULTANTS
A UNIT OF MICHAEL BAKER CORPORATION
3595 ENGINEERING DRIVE
NORCROSS, GEORGIA 30092
(770) 263-9118

REVISION DATES		

STATE OF GEORGIA
DEPARTMENT OF TRANSPORTATION
OFFICE: INNOVATIVE PROGRAM DELIVERY

TRAFFIC DIAGRAM

I-20 EASTBOUND CD LANES
I-285 TO PANOLA ROAD

DRAWING No. 10-002

1/5/2009 GPLN