AS-BUILT PLANS - 08/30/13

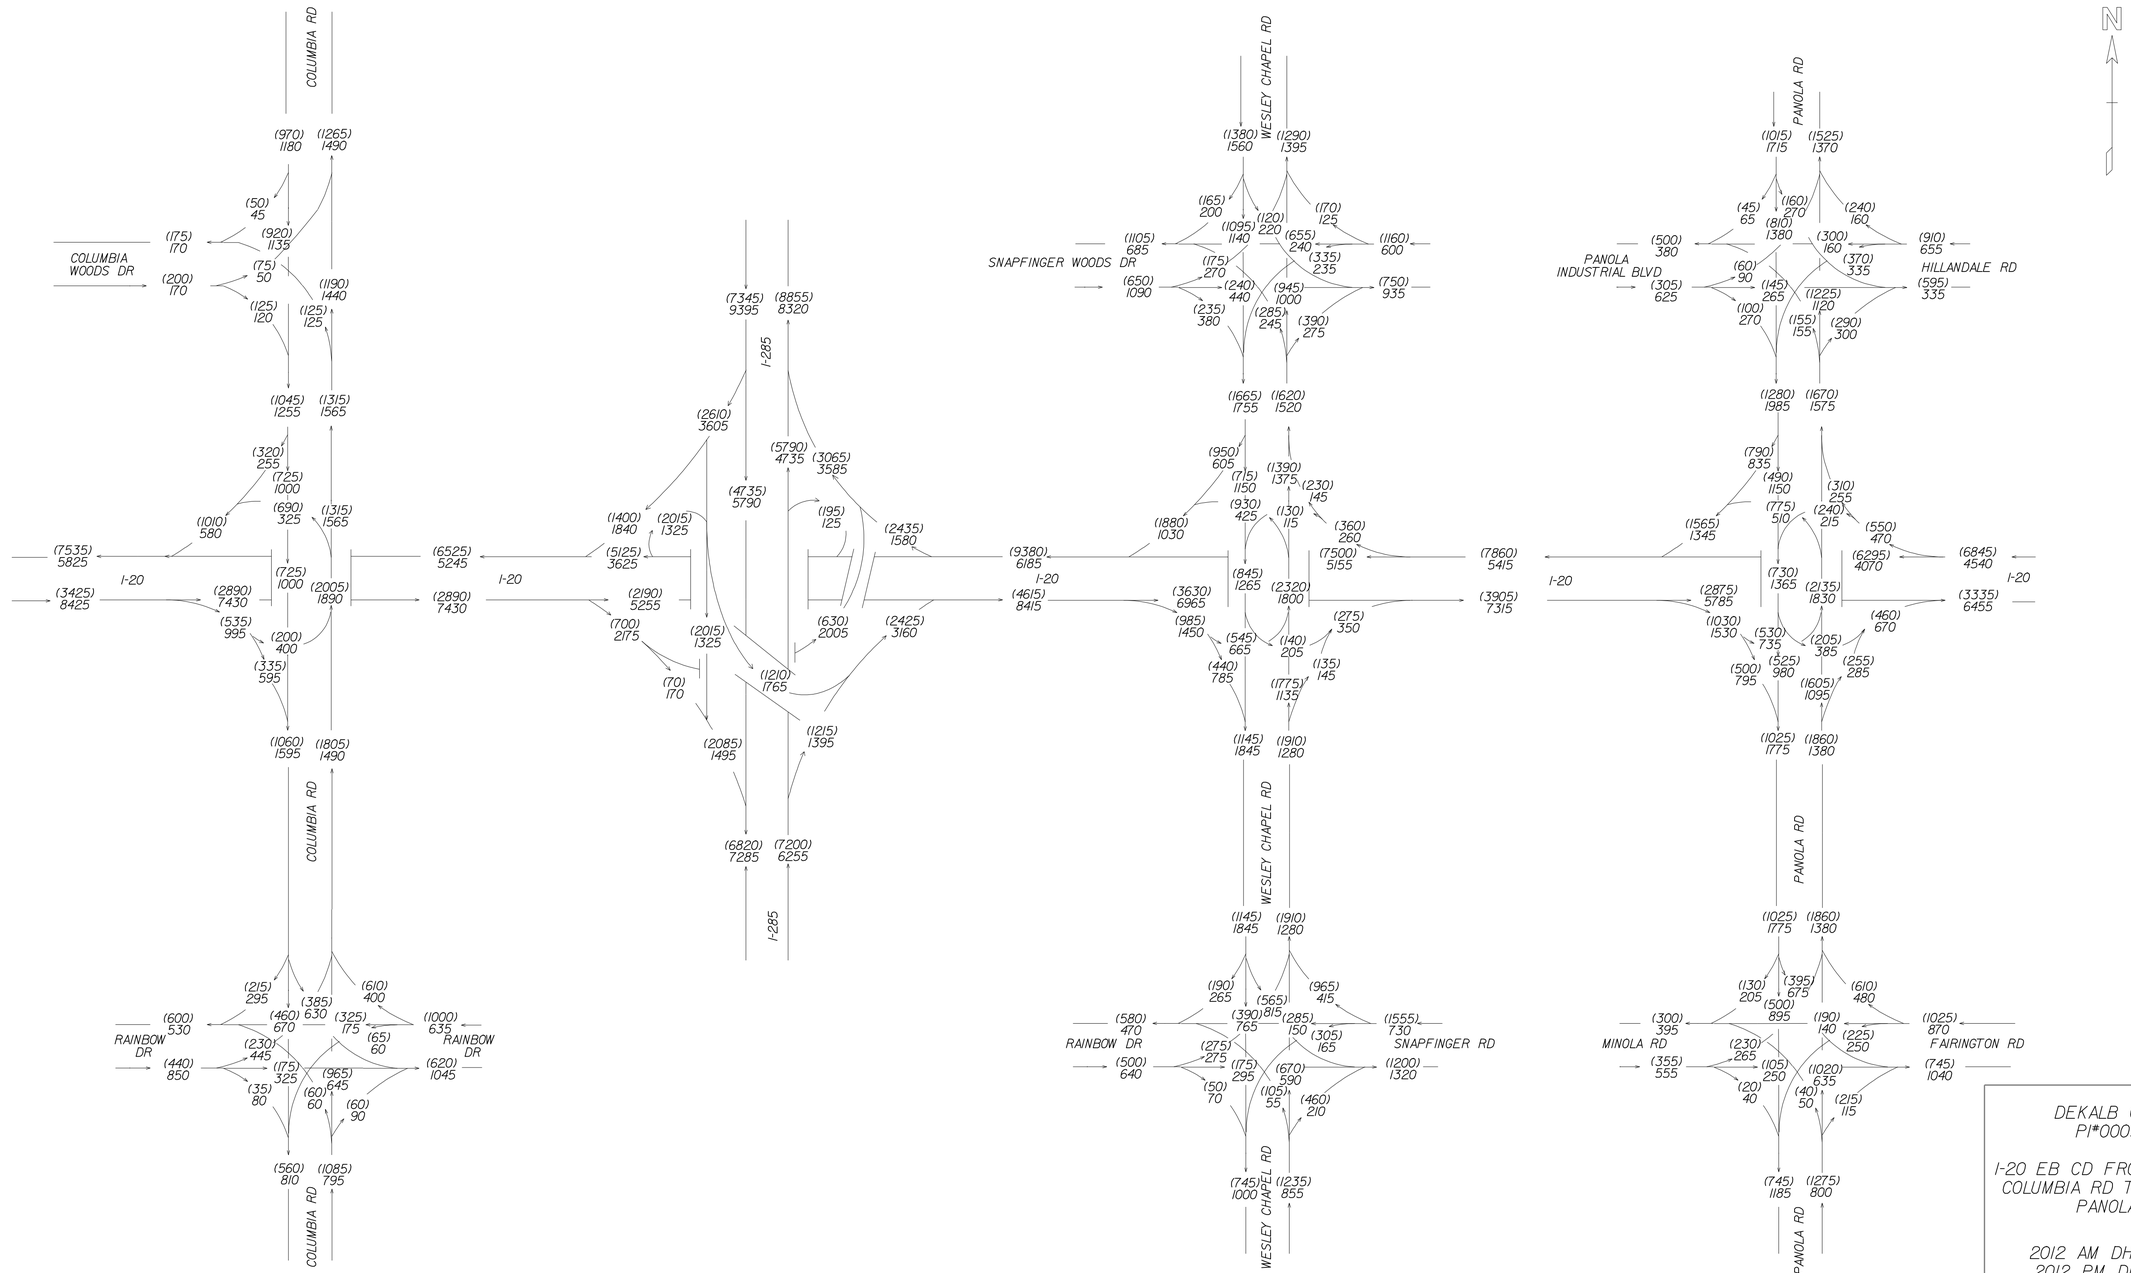


OPEN YEAR (2012) DESIGN HOURLY VOLUMES - NO-BUILD CONDITIONS

DEKALB COUNTY
PI#0009542

I-20 EB CD FROM WEST OF COLUMBIA RD TO EAST OF PANOLA RD

2012 AM DHV = (000)
2012 PM DHV = 000

T = 9%
S.U.= 4%
COMB.= 5%

ARCADIS 08/2009

THE LPA GROUP
TRANSPORTATION CONSULTANTS
A UNIT OF MICHAEL BAKER CORPORATION
3595 ENGINEERING DRIVE
NORCROSS, GEORGIA 30092
(770) 263-9118

| REVISION DATES | | |
|---|---|---|
| | | |
| | | |
| | | |
| | | |
| | | |
| | | |
| | | |

STATE OF GEORGIA
DEPARTMENT OF TRANSPORTATION
OFFICE: INNOVATIVE PROGRAM DELIVERY

**TRAFFIC DIAGRAM**

I-20 EASTBOUND CD LANES
I-285 TO PANOLA ROAD

DRAWING No. 10-003

1/5/2009 GPLN