STATE	PROJECT NUMBER	SHEET NO.	TOTAL SHEETS
GA	0009542	60	759

AS-BUILT PLANS - 08/30/13

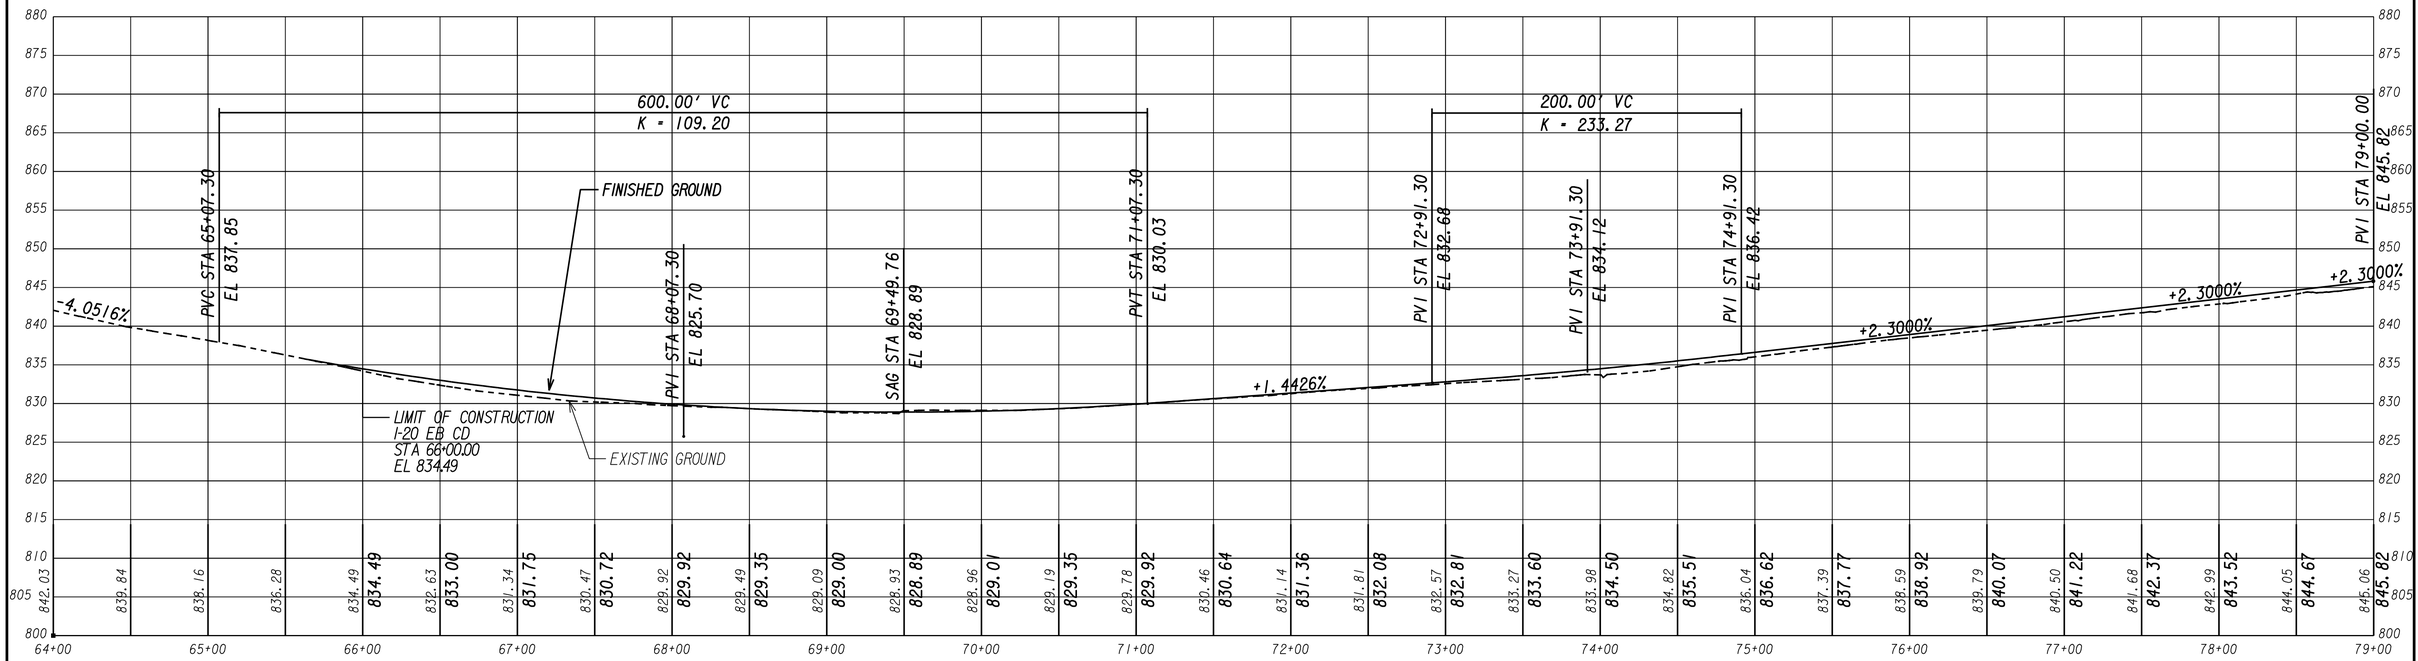

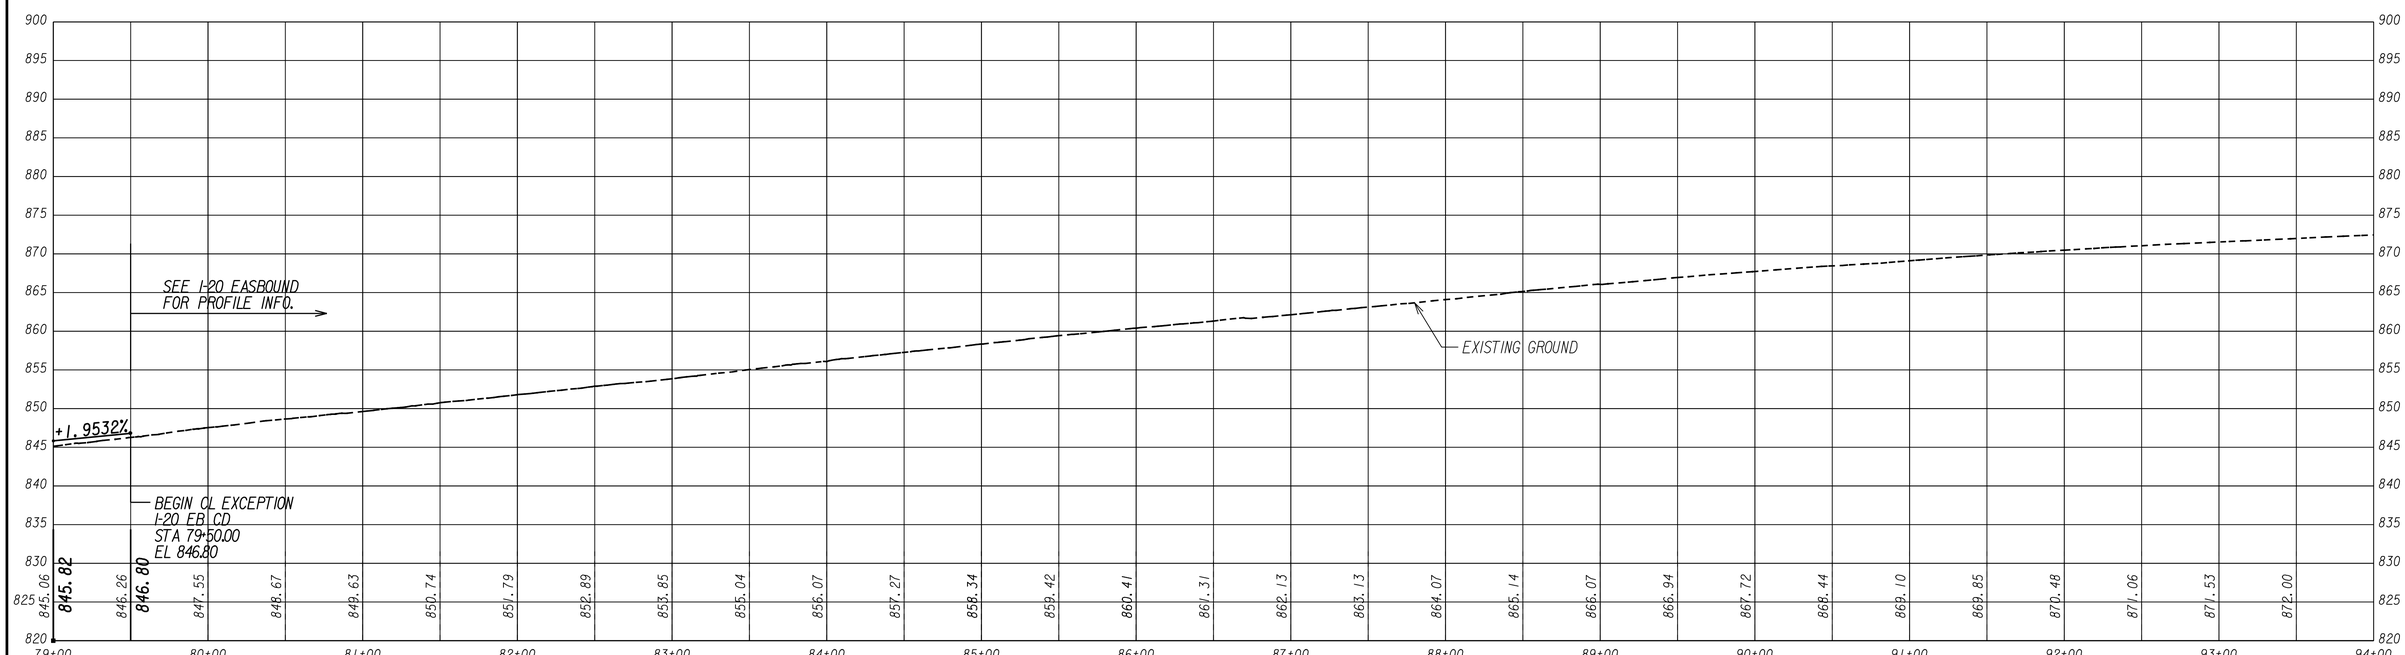

THE LPA GROUP
TRANSPORTATION CONSULTANTS
A UNIT OF MICHAEL BAKER CORPORATION
3595 ENGINEERING DRIVE
NORCROSS, GEORGIA 30092
(770) 263-9118

SCALE : 1" = 50' HORIZ.
1" = 10' VERT.

REVISION DATES

STATE OF GEORGIA
DEPARTMENT OF TRANSPORTATION
OFFICE: INNOVATIVE PROGRAM DELIVERY

CROSSROAD PROFILE

I-20 EB CD

DRAWING No. 16-001

3/1/2007 GR2EDG