AS-BUILT PLANS - 08/30/13

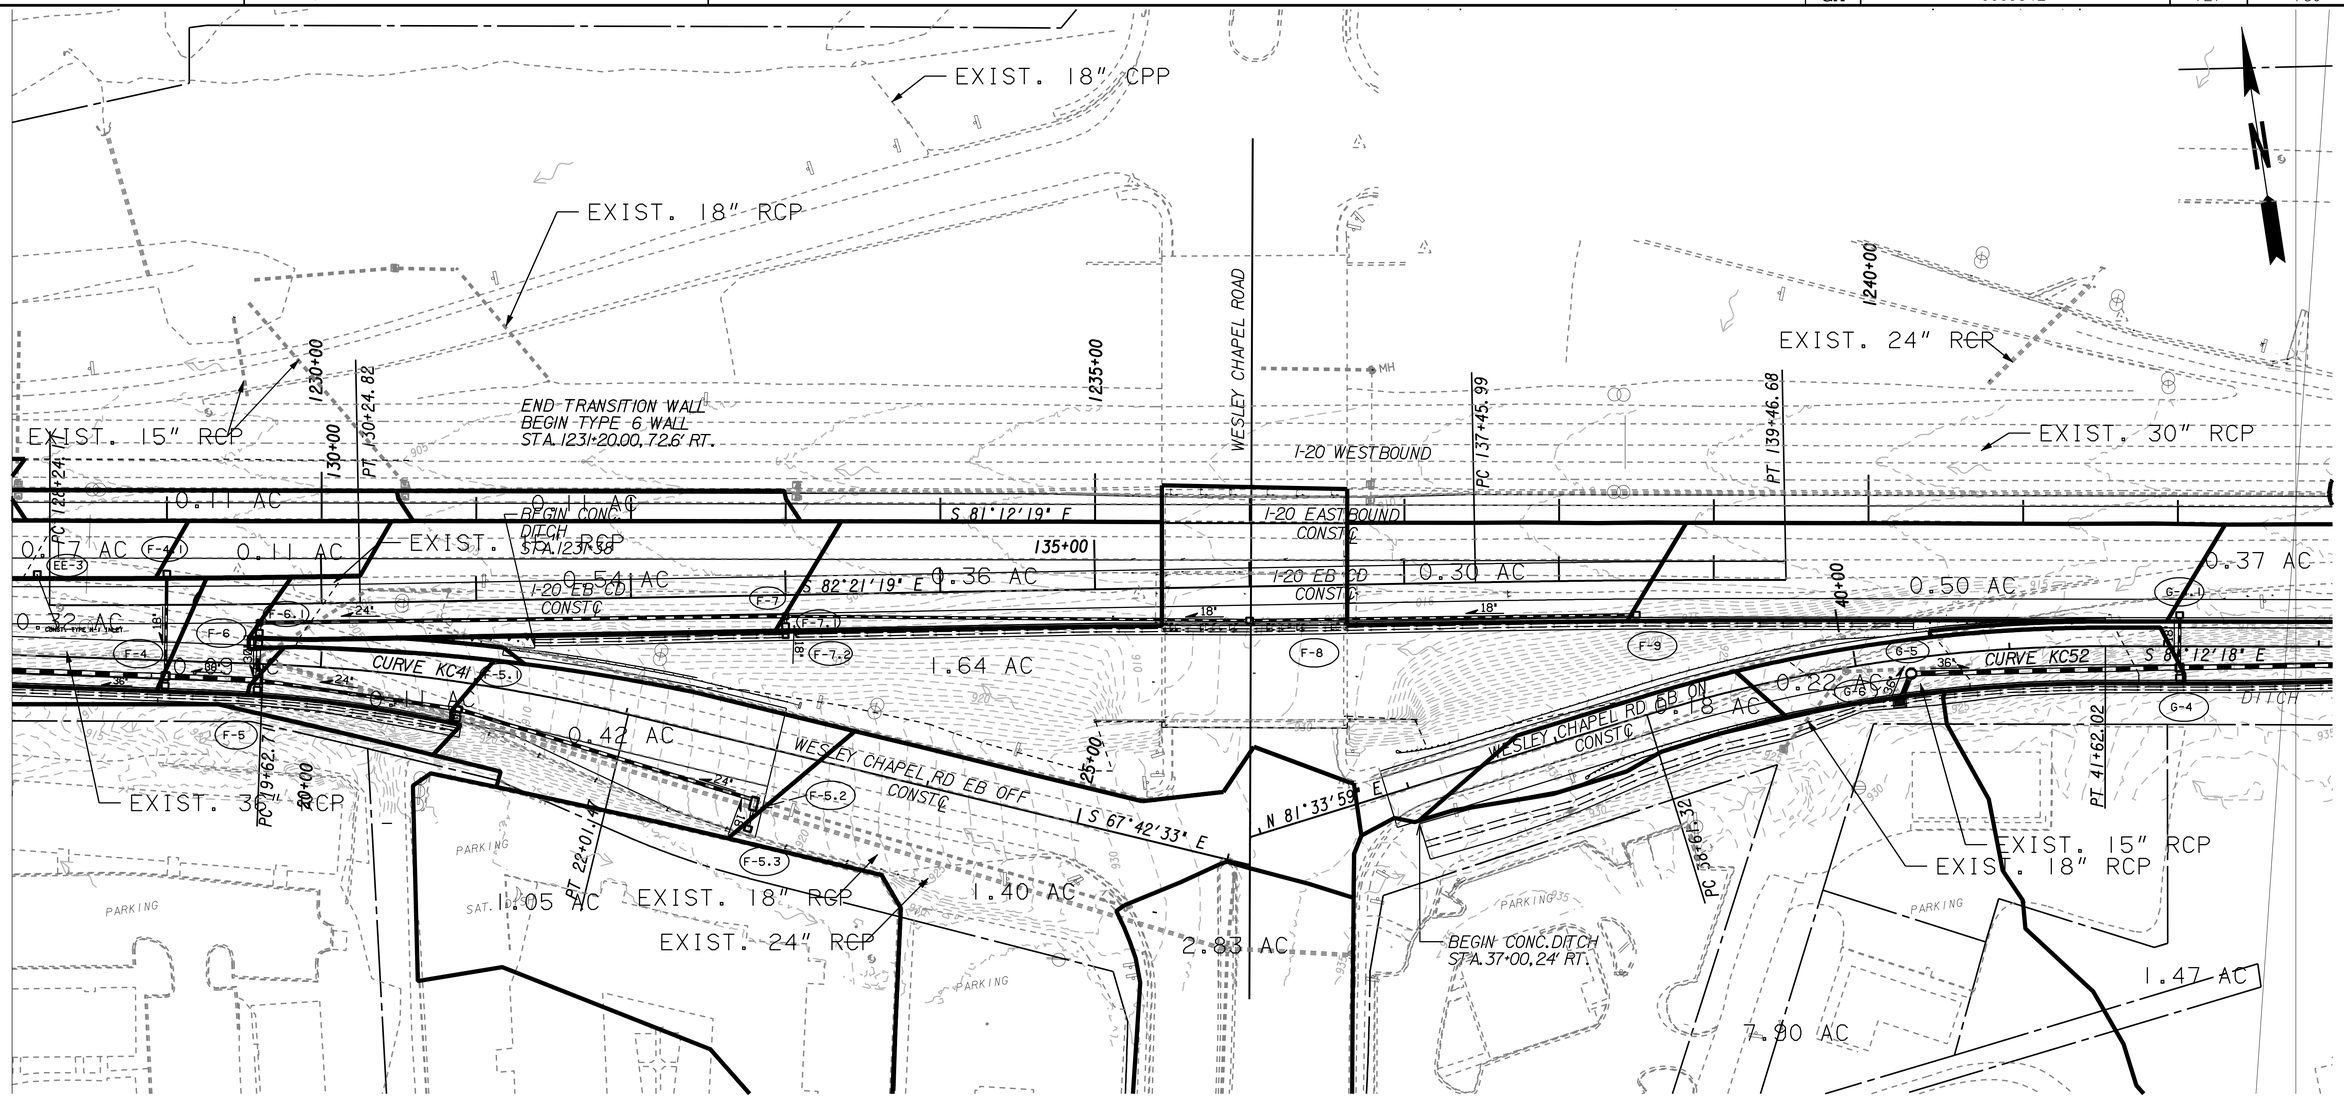

F-4

19+00.0 15.9 RT
WESLEY CHAPEL RD
OFF RAMP
DI MOD M-1 GA DETAIL D-36
AREA: 0.09 AC
C = 0.95
Q = 2.3 CFS

F-5

19+59.5 16.9 RT
WESLEY CHAPEL RD
OFF RAMP
DI MOD M-1 GA DETAIL D-36
AREA: 0.11 AC
C = 0.95
Q = 1.2 CFS

F-6

1 29+59.9 75.6 RT
I-20 MAINLINE
DI MOD M-3 GA DETAIL D-36
AREA: 0.54 AC
C = 0.95
Q = 4.2 CFS

F-7

1233+00.0 66.9 RT
I-20 MAINLINE
DI MOD M-1 GA DETAIL D-36
AREA: 0.36 AC
C = 0.95
Q = 2.6 CFS

F-8

1236+00.7 63.1 RT
I-20 MAINLINE
DI GA STD 5001M
AREA: 0.30 AC
C = 0.95
Q = 2.2 CFS

G-6

40+24.0 30.5 RT
WESLEY CHAPEL RD
ON RAMP
MH GA STD 1011A
AREA: N/A

G-4

42+10.0 20.4 RT
WESLEY CHAPEL RD
ON RAMP
DI MOD M-1 GA DETAIL D-36
AREA: 0.22 AC
C = 0.95
Q = 1.6 CFS

F-4.1

1229+00.0 34.1 RT
I-20 MAINLINE
DI GA STD 5001M
AREA: 0.11 AC
C = 0.95
Q = 0.8 CFS

F-5.1

20+86.4 23.3 RT
WESLEY CHAPEL RD
OFF RAMP
DI MOD M-1 GA DETAIL D-36
AREA: 0.42 AC
C = 0.95
Q = 3.1 CFS

F-5.2

22+94.0 40.2 RT
WESLEY CHAPEL RD
OFF RAMP
MH GA STD 1011A
AREA = N/A

F-5.3

22+94.0 54.3 RT
WESLEY CHAPEL RD
OFF RAMP
V INLET
GA DETAIL D-33
AREA = 1.4 AC
C = 0.94
Q = 8.7 CFS

F-7.1

1233+01.0 26.8 RT
I-20 MAINLINE
DI GA DETAIL D-4
AREA: 1.64 AC
C = 0.58
Q = 7.0 CFS

F-9

1238+50.3 58.9 RT
I-20 MAINLINE
DI GA STD 5001M
AREA: 0.50 AC
C = 0.95
Q = 3.7 CFS

G-7

40+14.0 30.5 RT
WESLEY CHAPEL RD
ON RAMP
HW GA STD 1001B
AREA: 7.90 AC
C = 0.64
Q = 35.6 CFS

G-5

40+35.1 11.0 RT
WESLEY CHAPEL RD
ON RAMP
MH GA STD 1011A
AREA: N/A

G-4.1

1242+00.0 58.4 RT
I-20 MAINLINE
DI GA STD 5001M
AREA: 0.37 AC
C = 0.95
Q = 2.7 CFS

THE LPA GROUP
TRANSPORTATION CONSULTANTS
A UNIT OF MICHAEL BAKER CORPORATION
3595 ENGINEERING DRIVE
NORCROSS, GEORGIA 30092
(770) 263-9118

SCALE IN FEET
0 50 100 200

REVISION DATES

STATE OF GEORGIA
DEPARTMENT OF TRANSPORTATION
OFFICE: INNOVATIVE PROGRAM DELIVERY

DRAINAGE AREA MAP

I-20 EASTBOUND CD LANES
I-285 TO PANOLA ROAD

DRAWING No. 21-008