AS-BUILT PLANS - 08/30/13

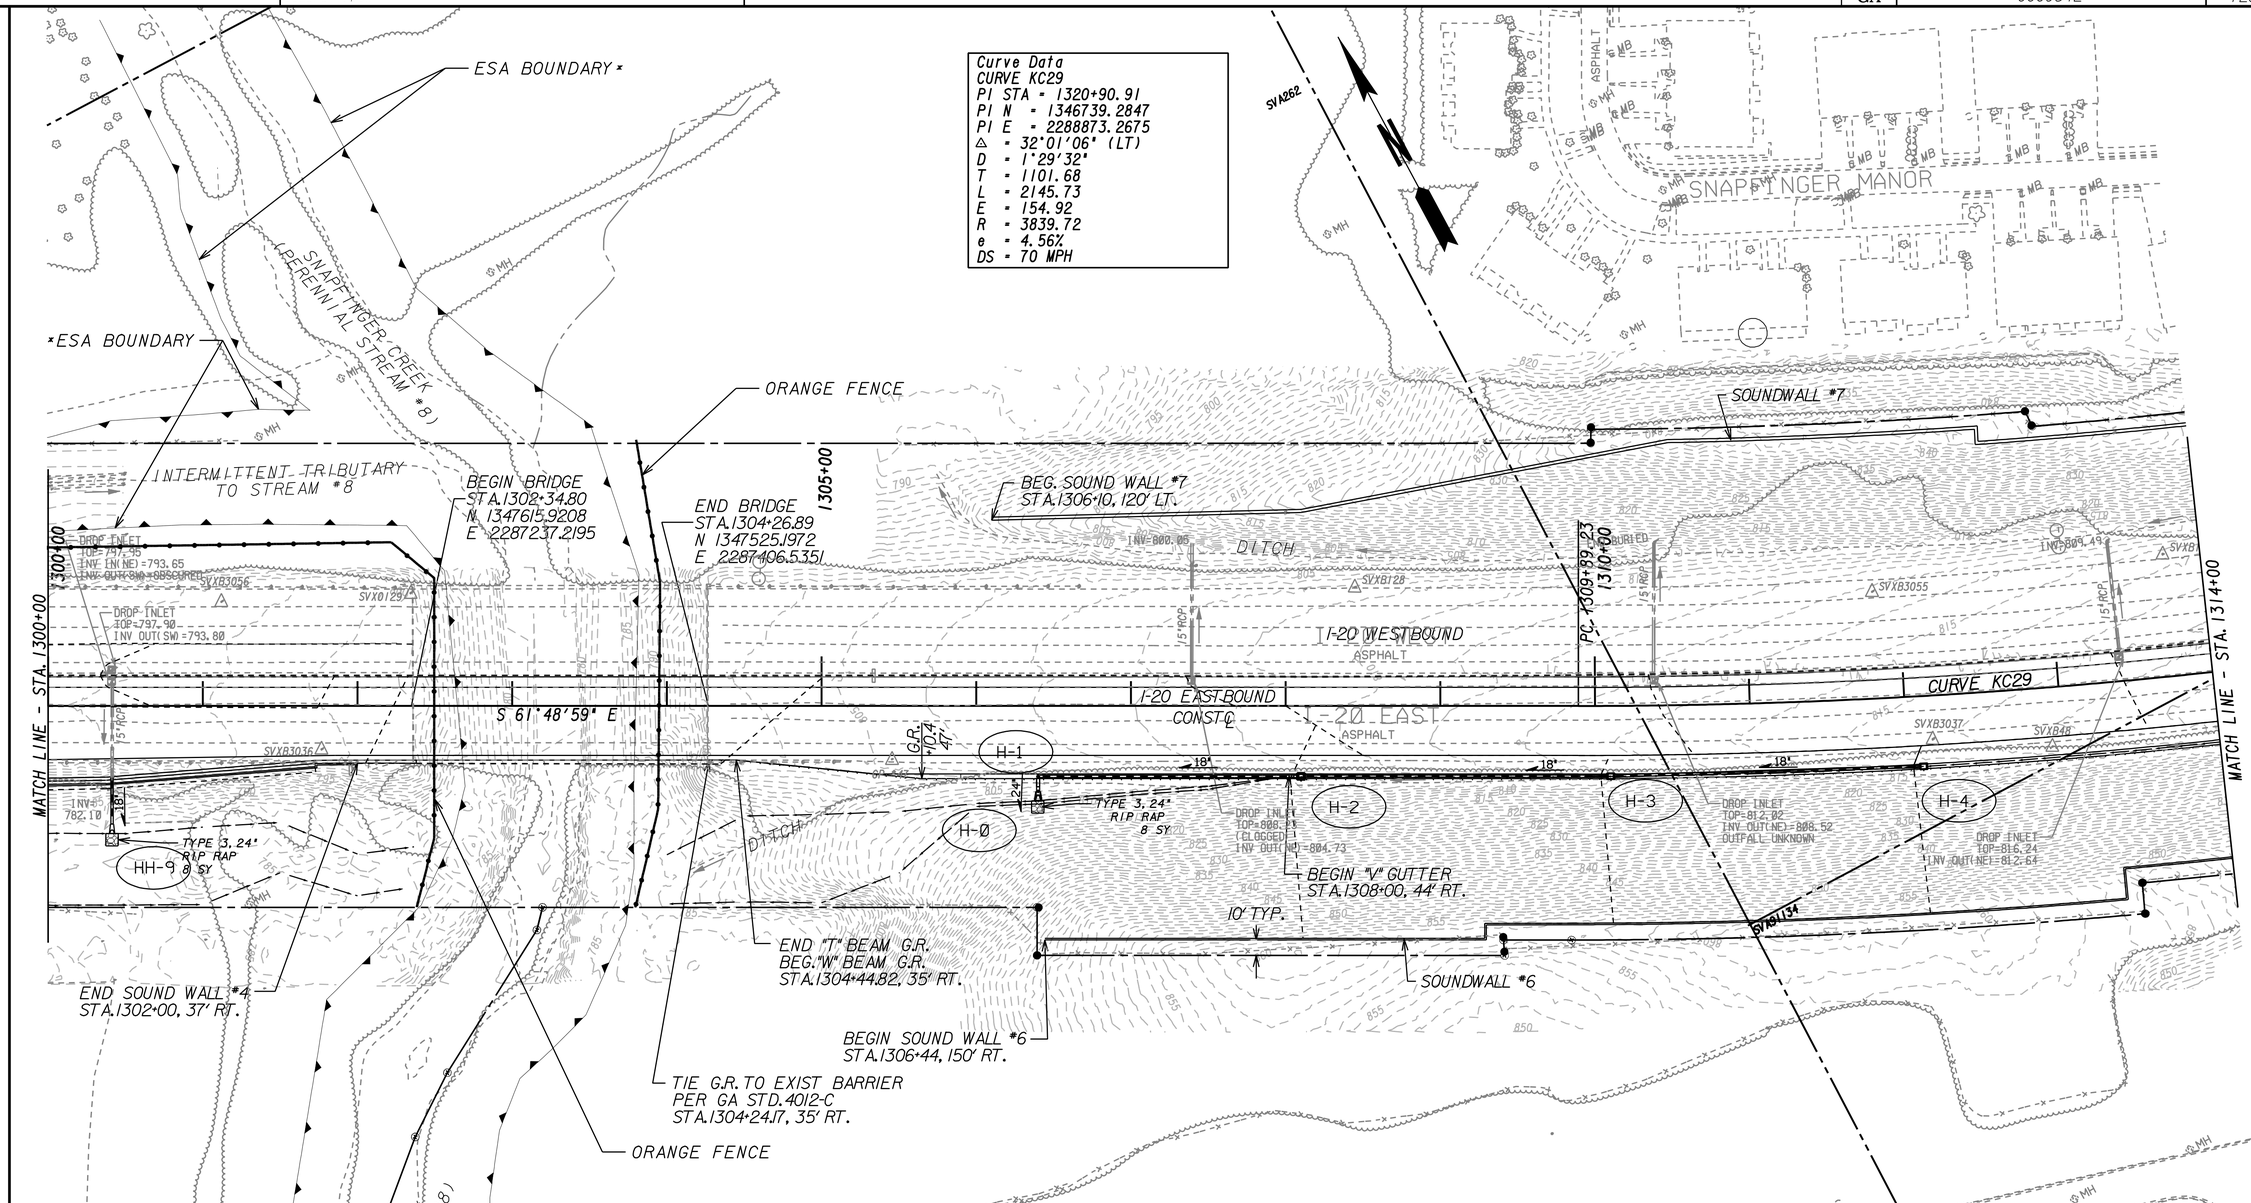

HH-9

1300+41.4 74.5 RT
I-20 MAINLINE
FES GA STD 1120
AREA = 0.12 AC
C = 0.95
Q = 2.9 CFS
V = 9.6 FPS

H-0

1306+40.0 51.5 RT
I-20 MAINLINE
FES GA STD 1120
AREA: N/A
Q = 4.5 CFS
V = 7.5 FPS

H-1

1306+40.0 45.5 RT
I-20 MAINLINE
MH GA STD 1011A
AREA: N/A

H-2

1308+10.0 46.1 RT
I-20 MAINLINE
V INLET GA DETAIL D-33
AREA = 0.54 AC
C = 0.45
Q = 1.6 CFS

H-3

1310+10.0 46.1 RT
I-20 MAINLINE
V INLET GA DETAIL D-33
AREA = 0.51 AC
C = 0.44
Q = 1.3 CFS

H-4

1312+10.0 46.1 RT
I-20 MAINLINE
V INLET GA DETAIL D-33
AREA = 0.56 AC
C = 0.46
Q = 1.6 CFS

THE LPA GROUP
TRANSPORTATION CONSULTANTS
A UNIT OF MICHAEL BAKER CORPORATION
3595 ENGINEERING DRIVE
NORCROSS, GEORGIA 30092
(770) 263-9118

SCALE IN FEET
0 50 100 200

REVISION DATES

STATE OF GEORGIA
DEPARTMENT OF TRANSPORTATION
OFFICE: INNOVATIVE PROGRAM DELIVERY

DRAINAGE AREA MAP

I-20 EASTBOUND CD LANES
I-285 TO PANOLA ROAD

DRAWING No. 21-013

1/5/2009 GPUN