AS-BUILT PLANS - 08/30/13

GG-9
STA 1274+92.78,
87.72' LT.
I-20 MAINLINE
FES GA STD 1120
INV 844.84

GG-9.1
STA 1274+92.78, 74.29' LT.
I-20 MAINLINE
DI GA STD 5001M
TOP 849.67
INV IN 844.88
INV OUT 844.88
HT: 5.46'

GG-10.1
STA 1271+42.67, 74.29' LT.
I-20 MAINLINE
DI GA STD 5001M
TOP 858.56
INV IN 853.23
INV OUT 853.23
HT: 6.00'

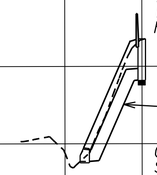

GG-10
STA 1271+42.67, 107.90' LT.
I-20 MAINLINE
FES GA STD 1120
INV 842.70

GG-12.1
STA 1263+97.24, 74.29' LT.
I-20 MAINLINE
DI GA STD 5001M
TOP 877.67
INV IN 872.34
INV OUT 872.34
HT: 6.00'

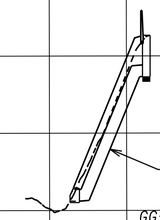

GG-12
STA 1263+97.24, 117.43' LT.
I-20 MAINLINE
FES GA STD 1120
INV 856.19

GG-9.2
STA 1275+50.00, 95.29' LT.
I-20 MAINLINE
DITCH DROP INLET
GA DETAIL D-4
TOP 844.60
INV OUT 841.60
HT: 3.50'

GG-9.3
STA 1276+20.61, 93.38' LT.
I-20 MAINLINE
FES GA STD 1120
INV 841.00

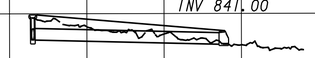

GG-11.1
STA 1268+41.23, 74.29' LT.
I-20 MAINLINE
DI GA STD 5001M
TOP 865.89
INV IN 860.56
INV OUT 860.56
HT: 6.00'

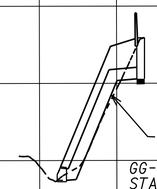

GG-11
STA 1268+41.23, 122.08' LT.
I-20 MAINLINE
FES GA STD 1120
INV 847.44

GG-13
STA 1265+25.02, 127.04' LT.
I-20 MAINLINE
DITCH DROP INLET
GA DETAIL D-4
TOP 852.25
INV OUT 847.95
HT: 4.80'

GG-8.1
STA 1272+50.00, 105.72' RT.
I-20 MAINLINE
DITCH DROP INLET
GA DETAIL D-4
TOP 850.73
INV OUT 845.50
HT: 5.73'

GG-8
STA 1272+94.04, 94.12' RT.
I-20 MAINLINE
FES GA STD 1120
INV 845.28

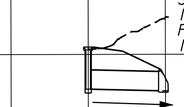

TYPICAL HH-SERIES SLOPE DRAIN DETAIL

STA SEE CHART, SEE CHART
I-20 MAINLINE
DI GA STD 5001M
TOP SEE CHART
INV OUT SEE CHART
HT: SEE CHART'

STA SEE CHART , SEE CHART
I-20 MAINLINE
FES GA STD 1120
INV SEE CHART

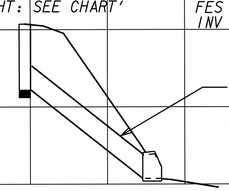

STRUCT. ID	TYPE	STA.	OFFSET	TOP EL.	INVERT EL.	HEIGHT
HH-2.1 HH-2	DI FES	1289+54.90 1289+54.90	53.83 RT 95.71 RT	813.24	809.04 793.71	4.87'
HH-6.1 HH-6	DI FES	1297+80.00 1298+01.72	46.29 RT 75.95 RT	796.44	791.24 783.59	5.87'
HH-7.1 HH-7	DI FES	1298+50.00 1298+72.95	46.29 RT 77.47 RT	796.35	791.35 782.84	5.67'
HH-8.1 HH-8	DI FES	1299+20.00 1299+43.67	46.08 RT 78.14 RT	796.61	791.51 782.54	5.77'

HH-1.1
STA 1287+62.08, 91.17' RT.
I-20 MAINLINE
FES GA STD 1120
INV 805.00

HH-1
STA 1288+41.92, 102.82' RT.
I-20 MAINLINE
FES GA STD 1120
INV 796.86

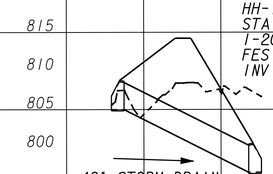

HH-3
STA 1291+04.21, 83.38' RT.
I-20 MAINLINE
FES GA STD 1120
INV 794.34

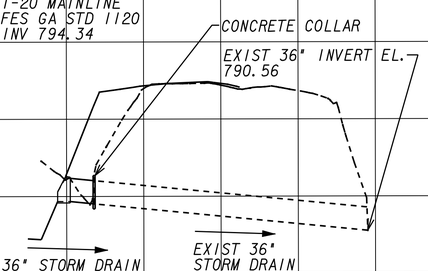

THE LPA GROUP
TRANSPORTATION CONSULTANTS
A UNIT OF MICHAEL BAKER CORPORATION
3595 ENGINEERING DRIVE
NORCROSS, GEORGIA 30092
(770) 263-9118

SCALE : 1" = 50' HORIZ.
1" = 10' VERT.

REVISION DATES

STATE OF GEORGIA
DEPARTMENT OF TRANSPORTATION
OFFICE: INNOVATIVE PROGRAM DELIVERY

GG-SERIES & HH-SERIES

I-20 EASTBOUND CD LANES
I-285 TO PANOLA ROAD

DRAWING No. 22-008

3/1/2007 GR2EDG